


Section 16 T.19S. R.3.W.W.M.
LANE COUNTY
1"=400'

FOR ASSESSMENT
AND TAXATION
USE ONLY

19 0
7-27-89
-DIV. 1409 D.C.

Application No. K-76994
Permit No. 73382

See Map 19 03 09

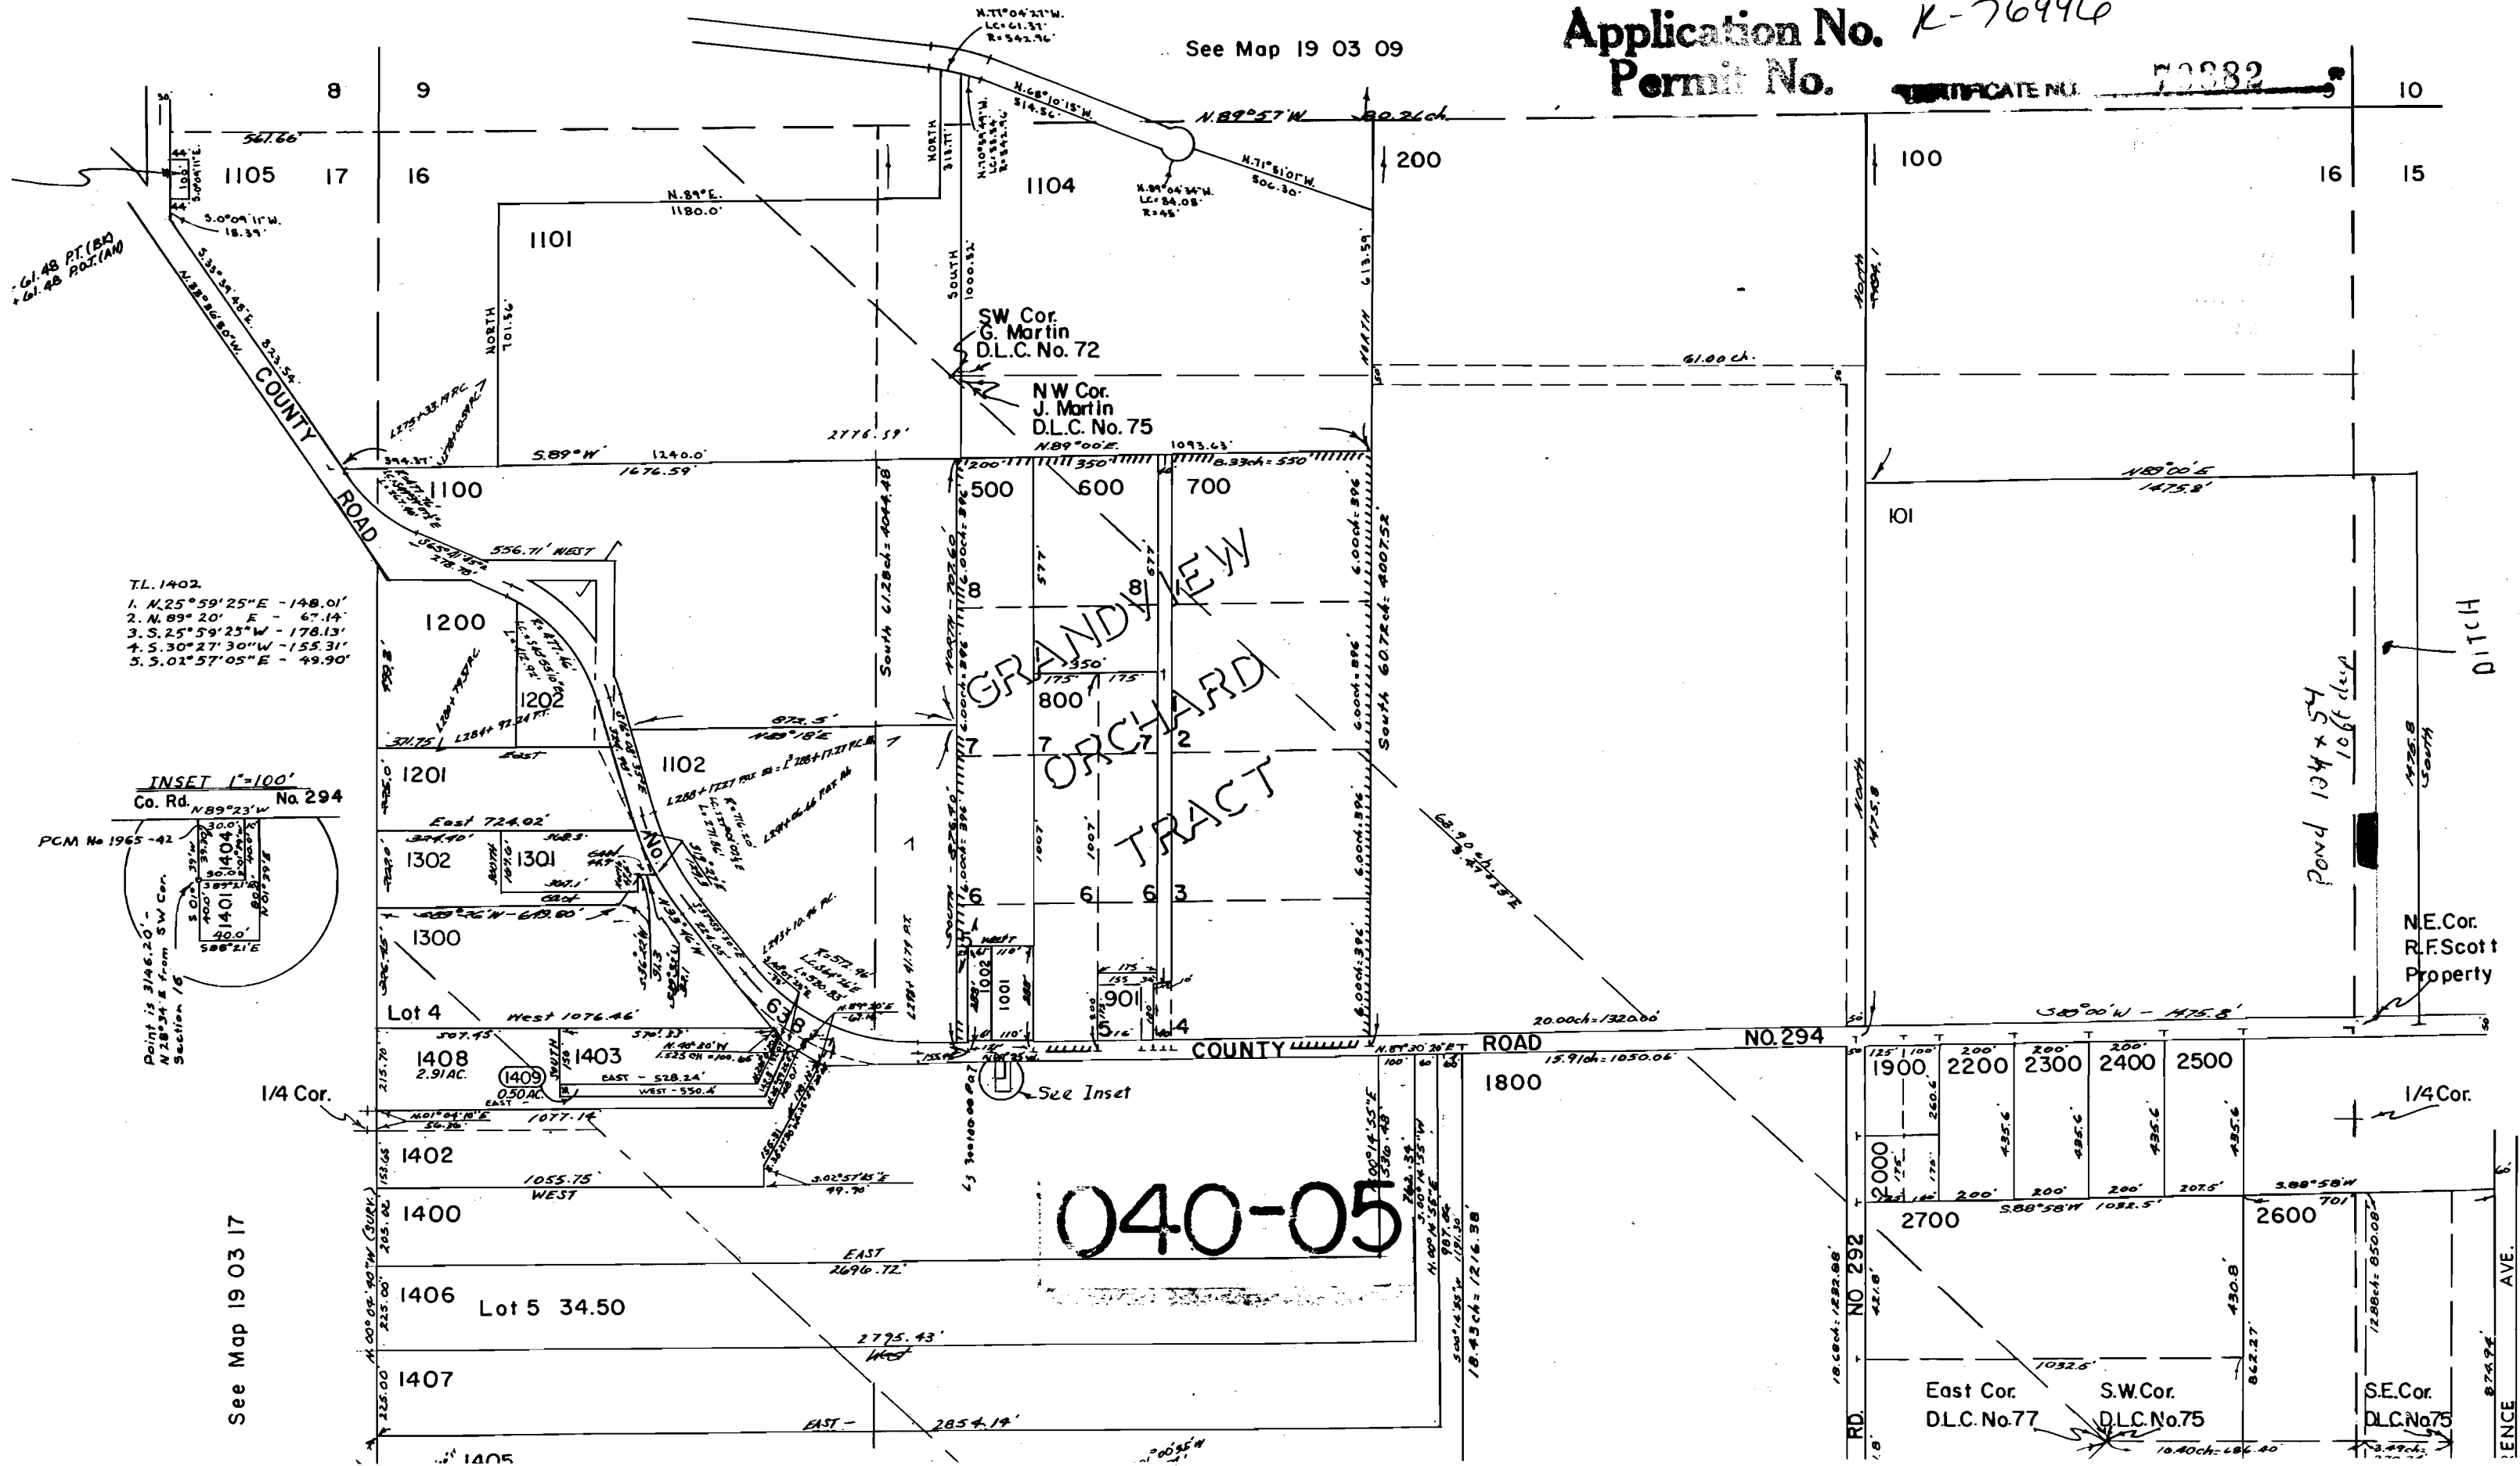

No Final Proof Map available

No Permit Map available