

THIS MAP WAS PREPARED FOR  
ASSESSMENT PURPOSE ONLY.


1"=200'

Application No. *K-76998*  
Permit No.

SEE MAP 27 13 20

70884

CERTIFICATE NO.

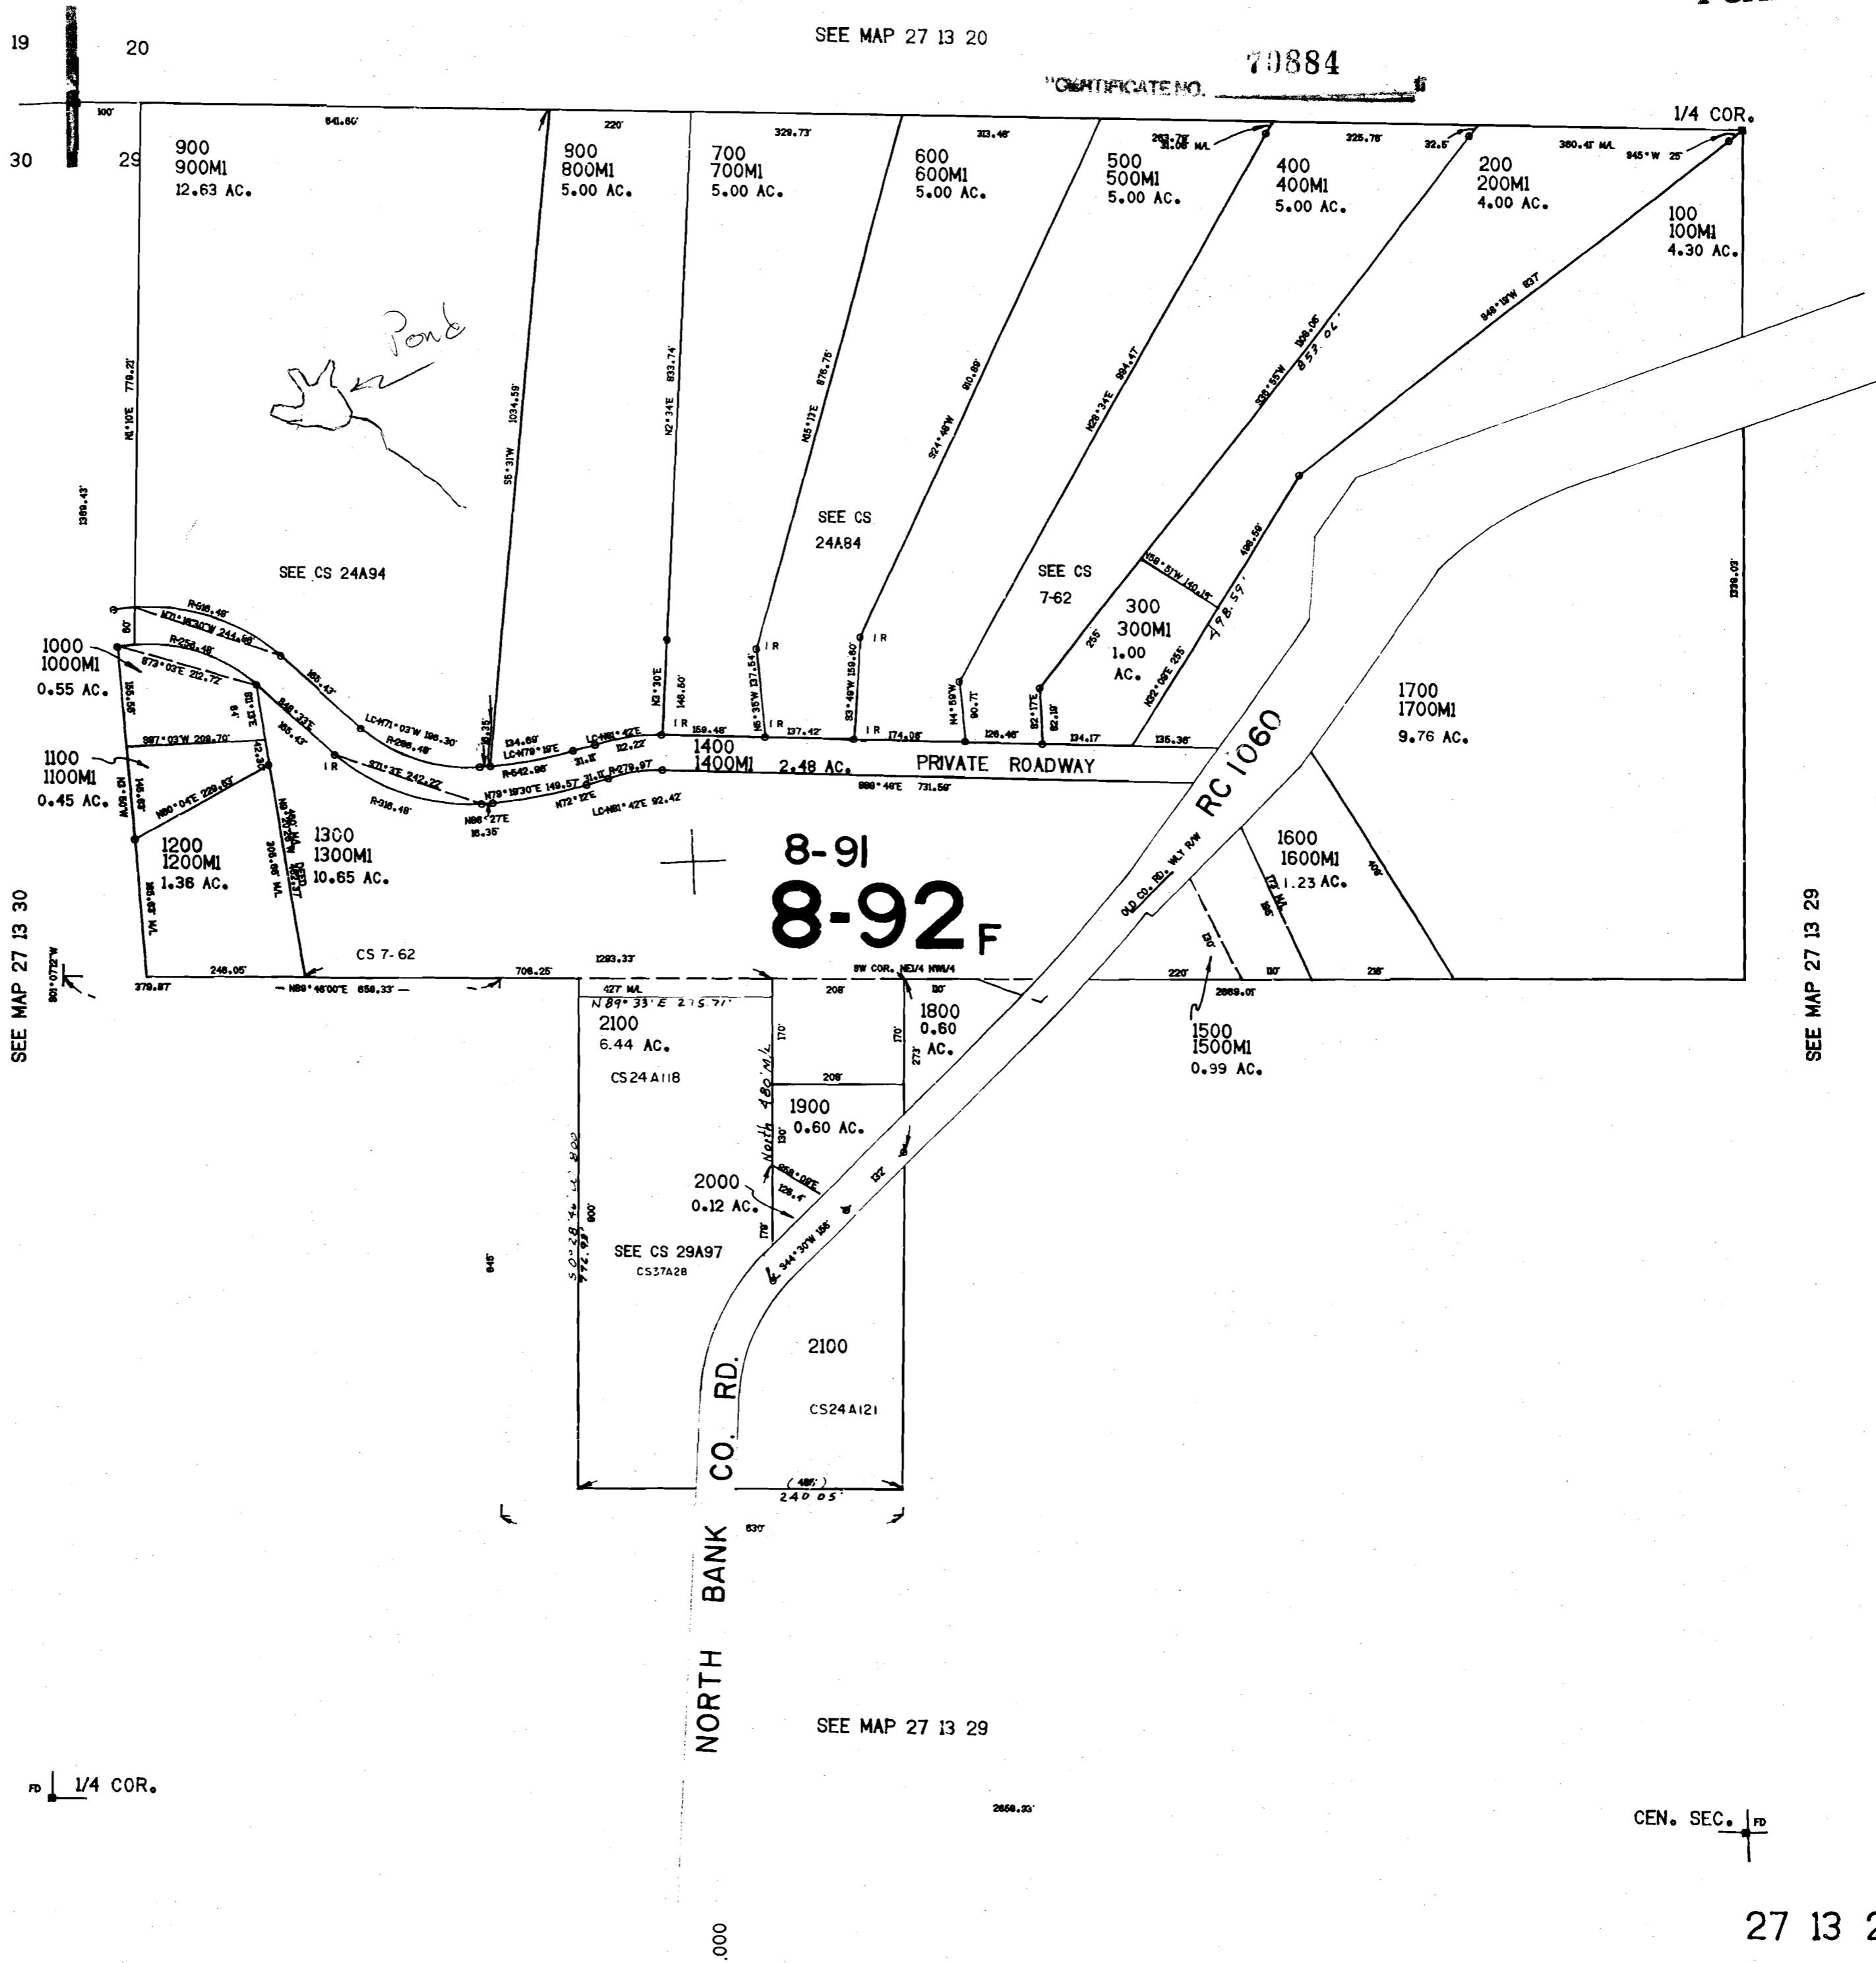

CONTROL — LAYOUT — TRACED — CHECKED

SEE MAP 27 13 30

SEE MAP 27 13 29

8-91  
8-92F

584.000

1/4 COR.

CEN. SEC.