


SEE MAP 10 29

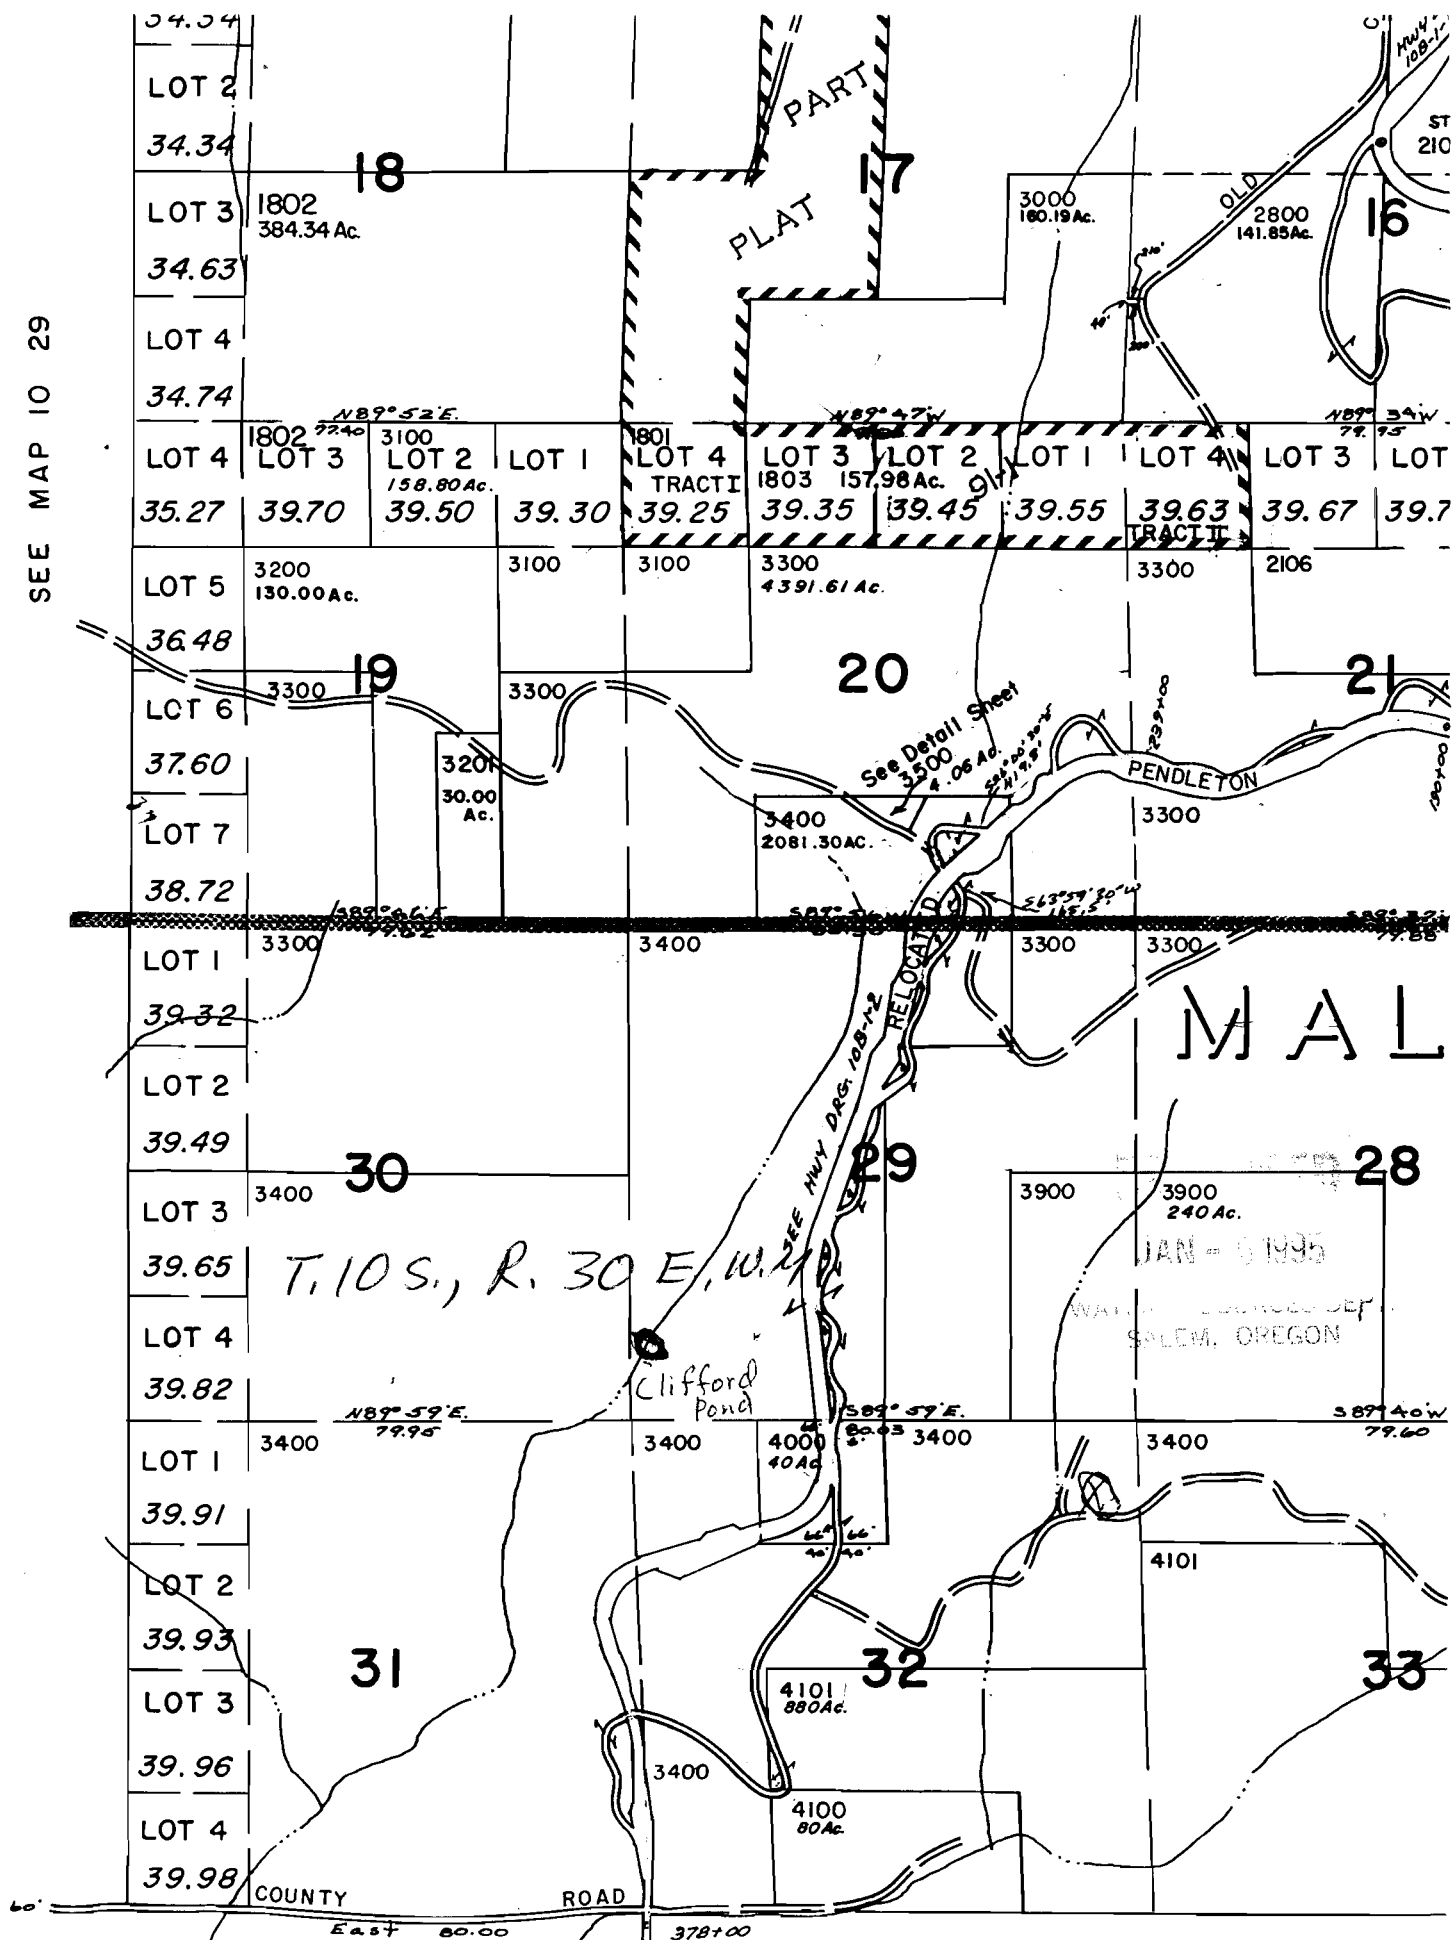

RECEIVED

NOV 25 1994

DEPT. OF REVENUE
STATE OF OREGON

Application No. R-77000
Permit No. 72236

No Final Proof Map available

No Permit Map available