

T.10S. R.30E. W.M.
GRANT COUNTY

1" = 2000'

SEE MAP 9 30

Application No. 877001
Permit No.

SEE MAP 10 29

CANCELLED NO.
2900
2801
901
1303
2103
2104
2107
2001
701
702
2108
2109
3401
805


SECTION 10
PARCEL 2105

1. N. 79° E. 105.00'
2. S. 61° E. 200.00'
3. S. 79° W. 200.00'
4. N. 11° W. 200.00'
5. N. 79° E. 95.00'

SECTION 9
PARCEL 802

1. N. 5° 41' 48" W. 103.41'
2. N. 0° 58' 24" E. 124.23'
3. S. 84° 24' 55" E. 240.91'
4. S. 0° 30' 08" W. 200.65'
5. N. 89° 27' 13" W. 200.00'

THIS MAP WAS PREPARED FOR
ASSESSMENT PURPOSES ONLY

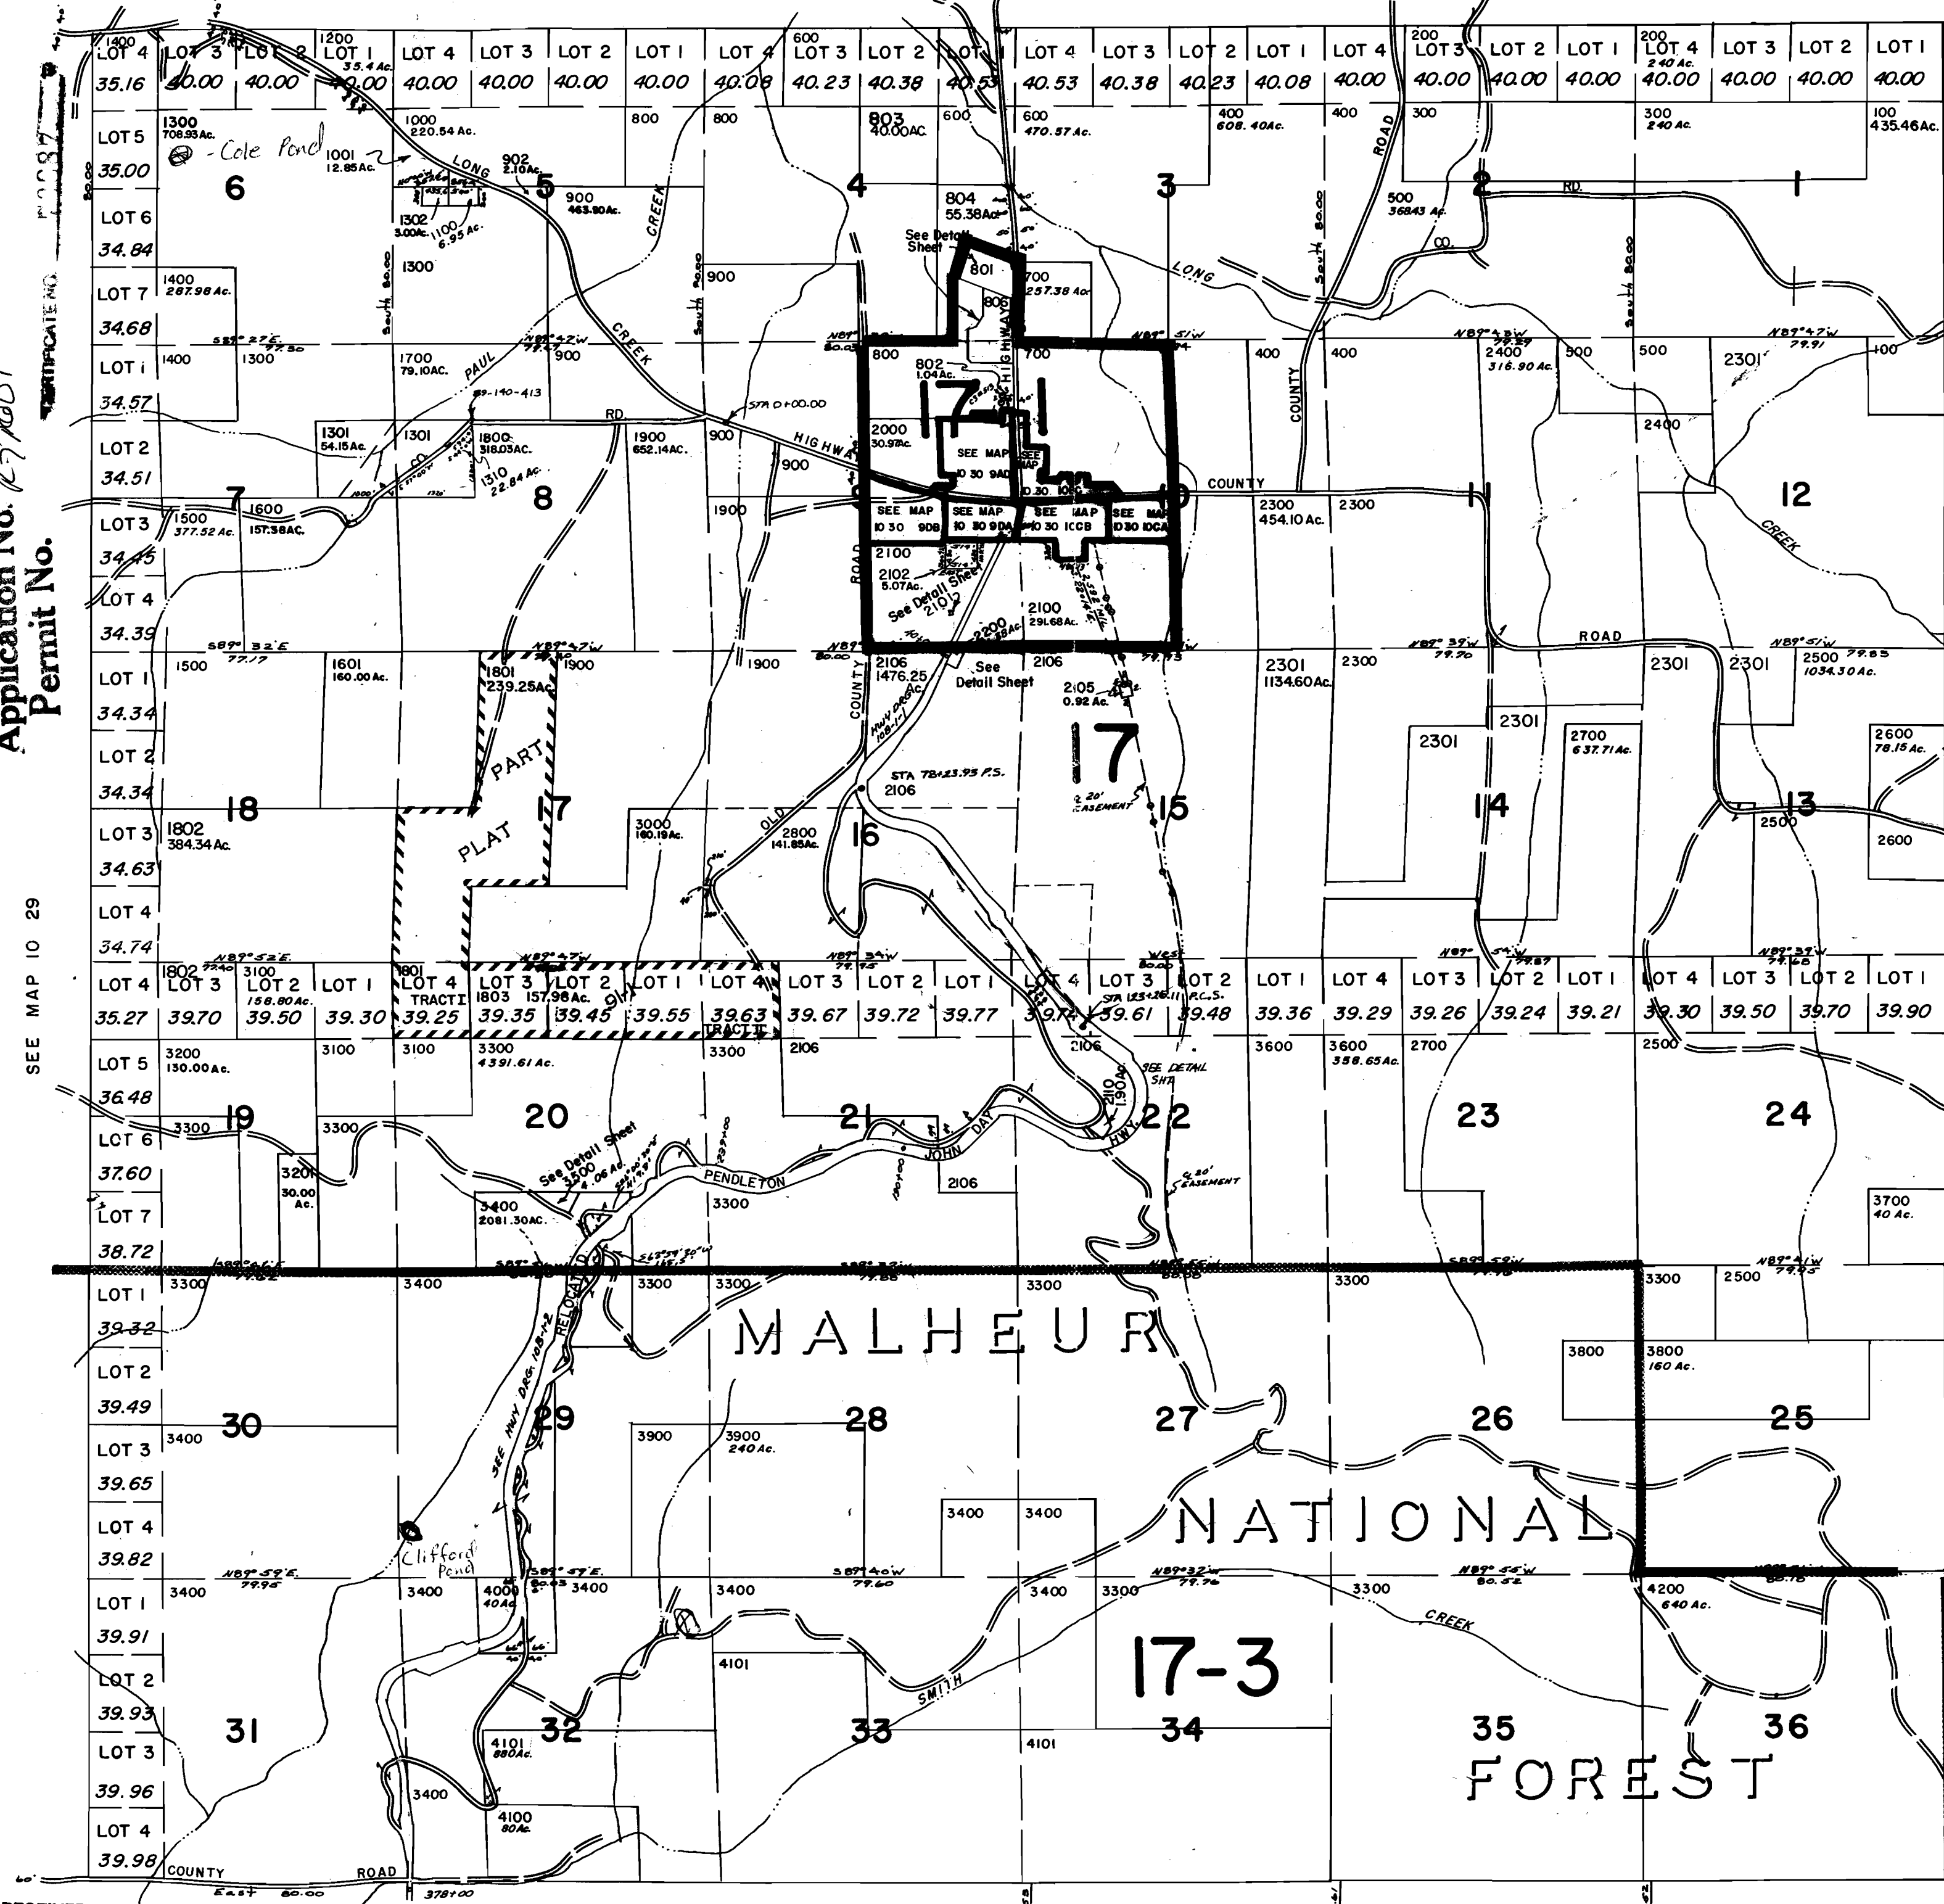

RECEIVED

NOV 2 5 1994

DEPT. OF REVENUE
STATE OF OREGON

SEE MAP 11 30

No Final Proof Map available

No Permit Map available