


T6S, R21E
SEC. #3

Application No. R-77005
Permit No.

RECEIVED

JAN - 5 1995

WATER RESOURCES DEP
SALEM, OREGON

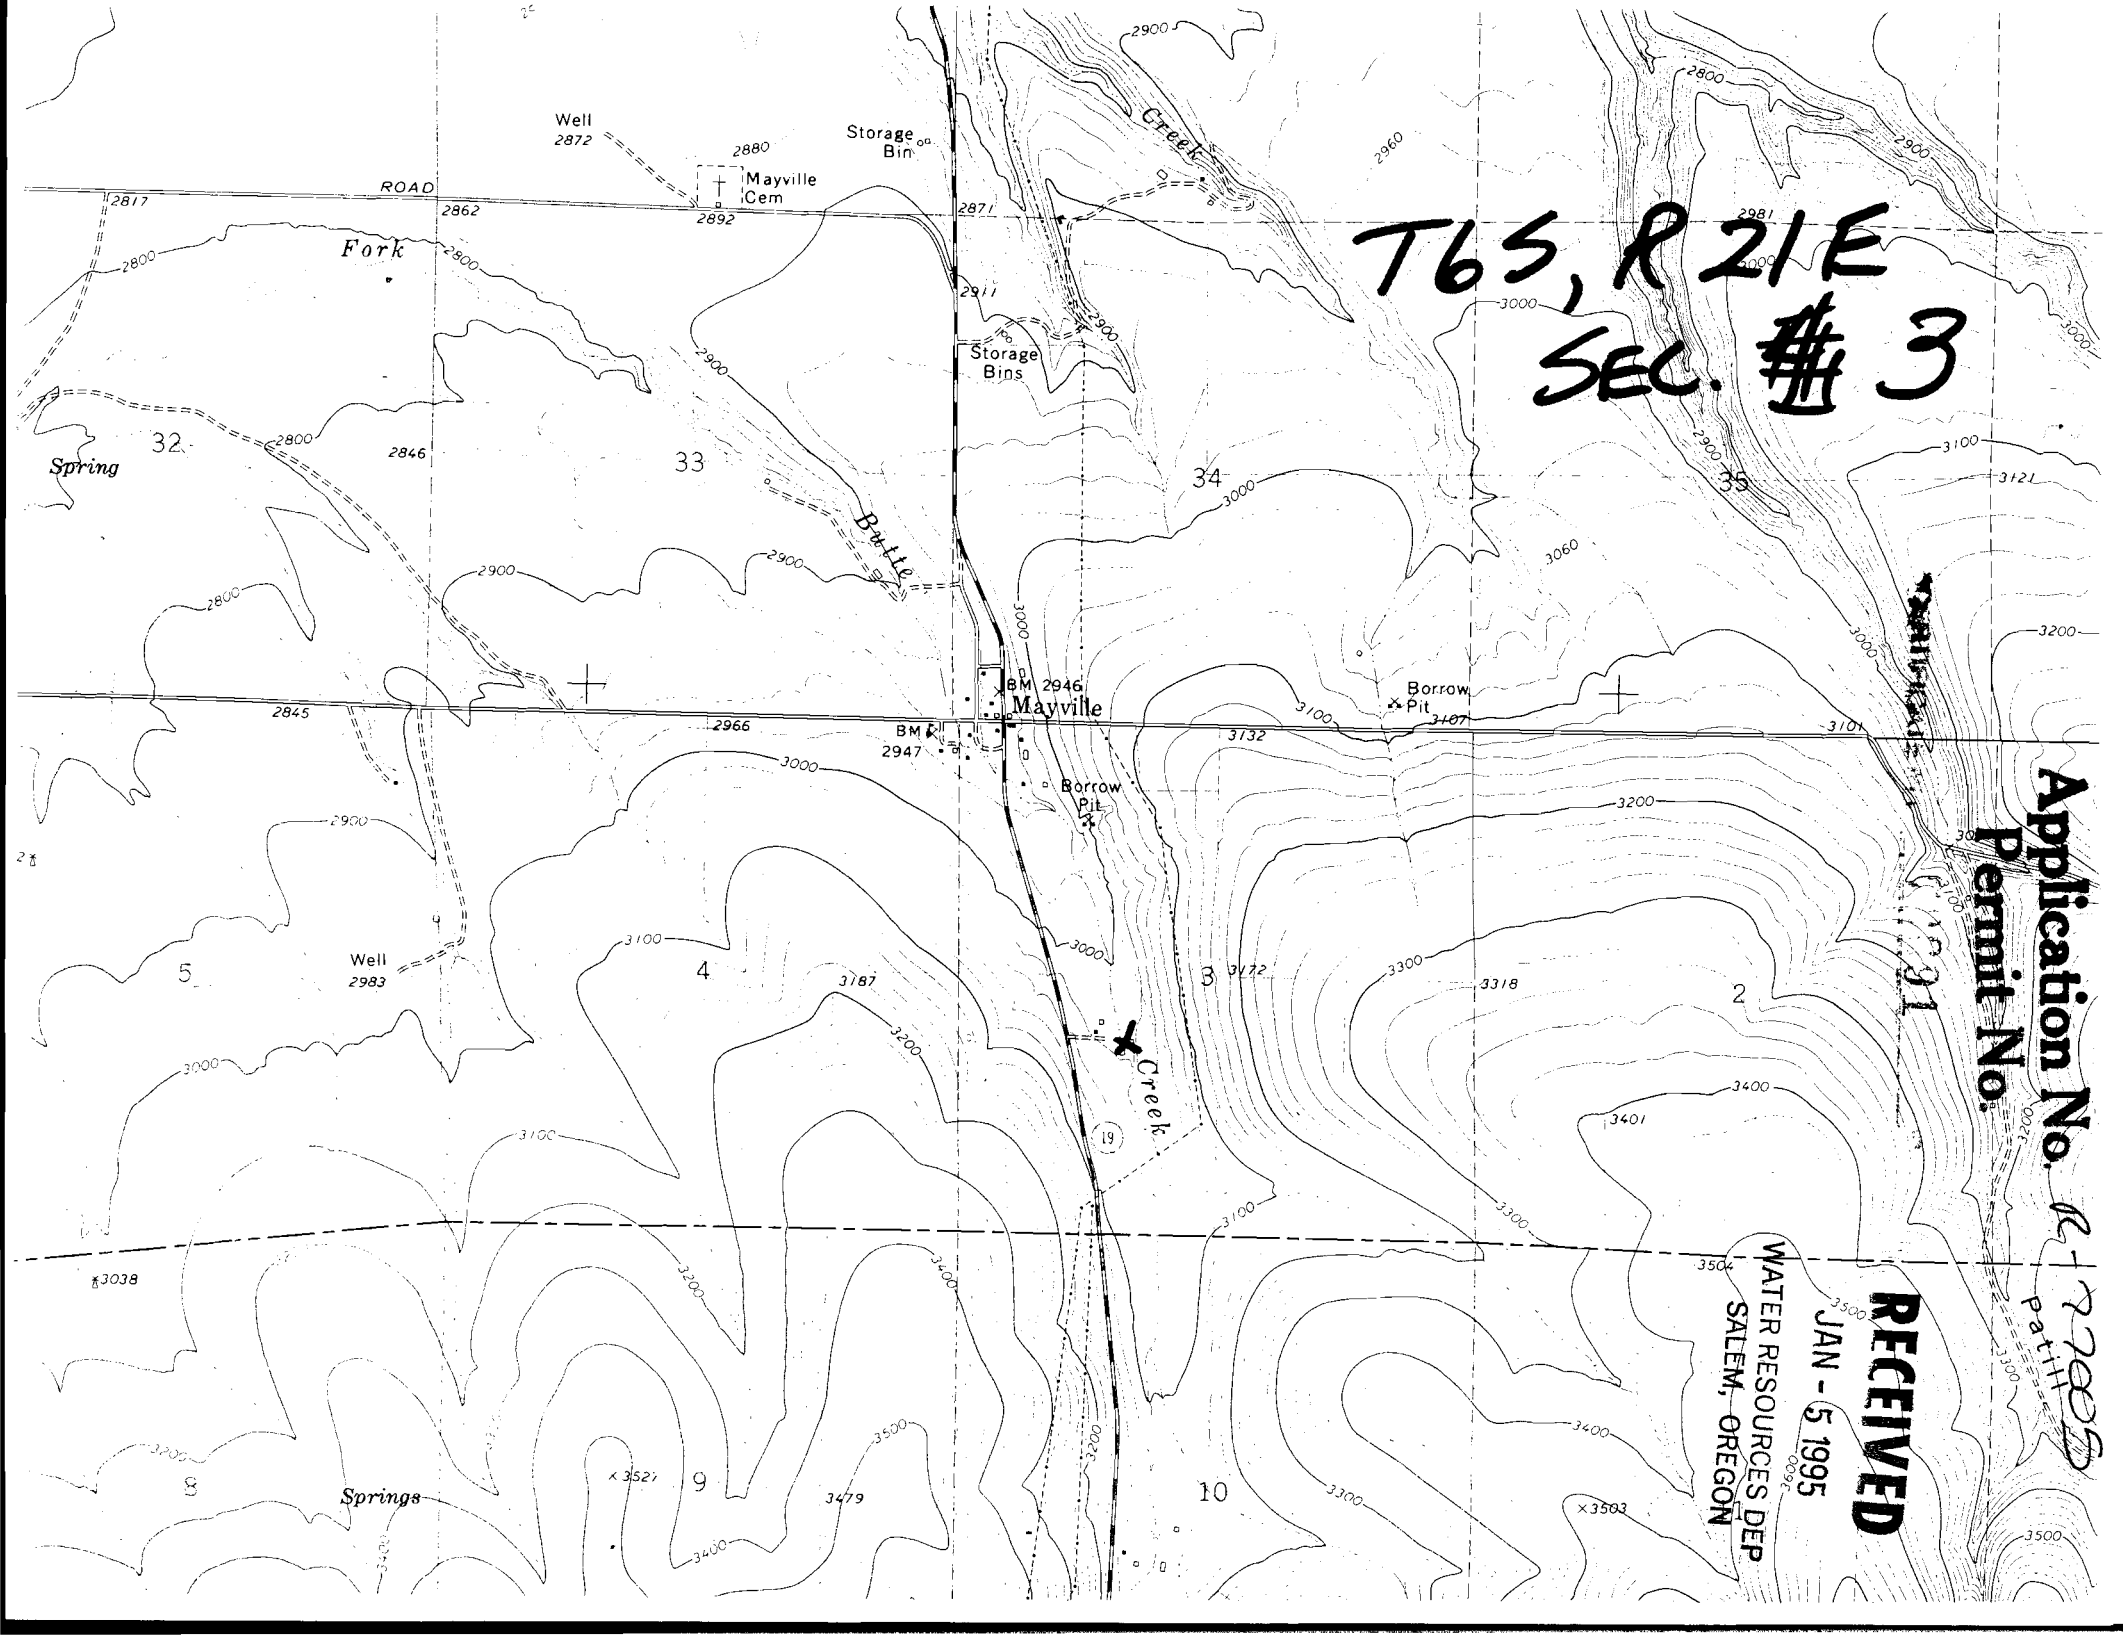

No Final Proof Map available

No Permit Map available