

SMENT
TION
LY

Section 9 T.17 S. R.6 W.W.M.

LANE COUNTY

1"=400'

Application No. R-77009
Permit No.

17
3-19-
CODES
11-8-93
-302-307

JAN - 1995

WATER - ...
SALEM, OREGON

CERTIFICATE NO. 72095


See Map 17 06 04
SHEFFLER

Tax Lotted on Map
17 06 04

Tax Lotted On
Map 17 06 08

Paul Bokizans'
Sweet Ck
(Seasonal)

028-02

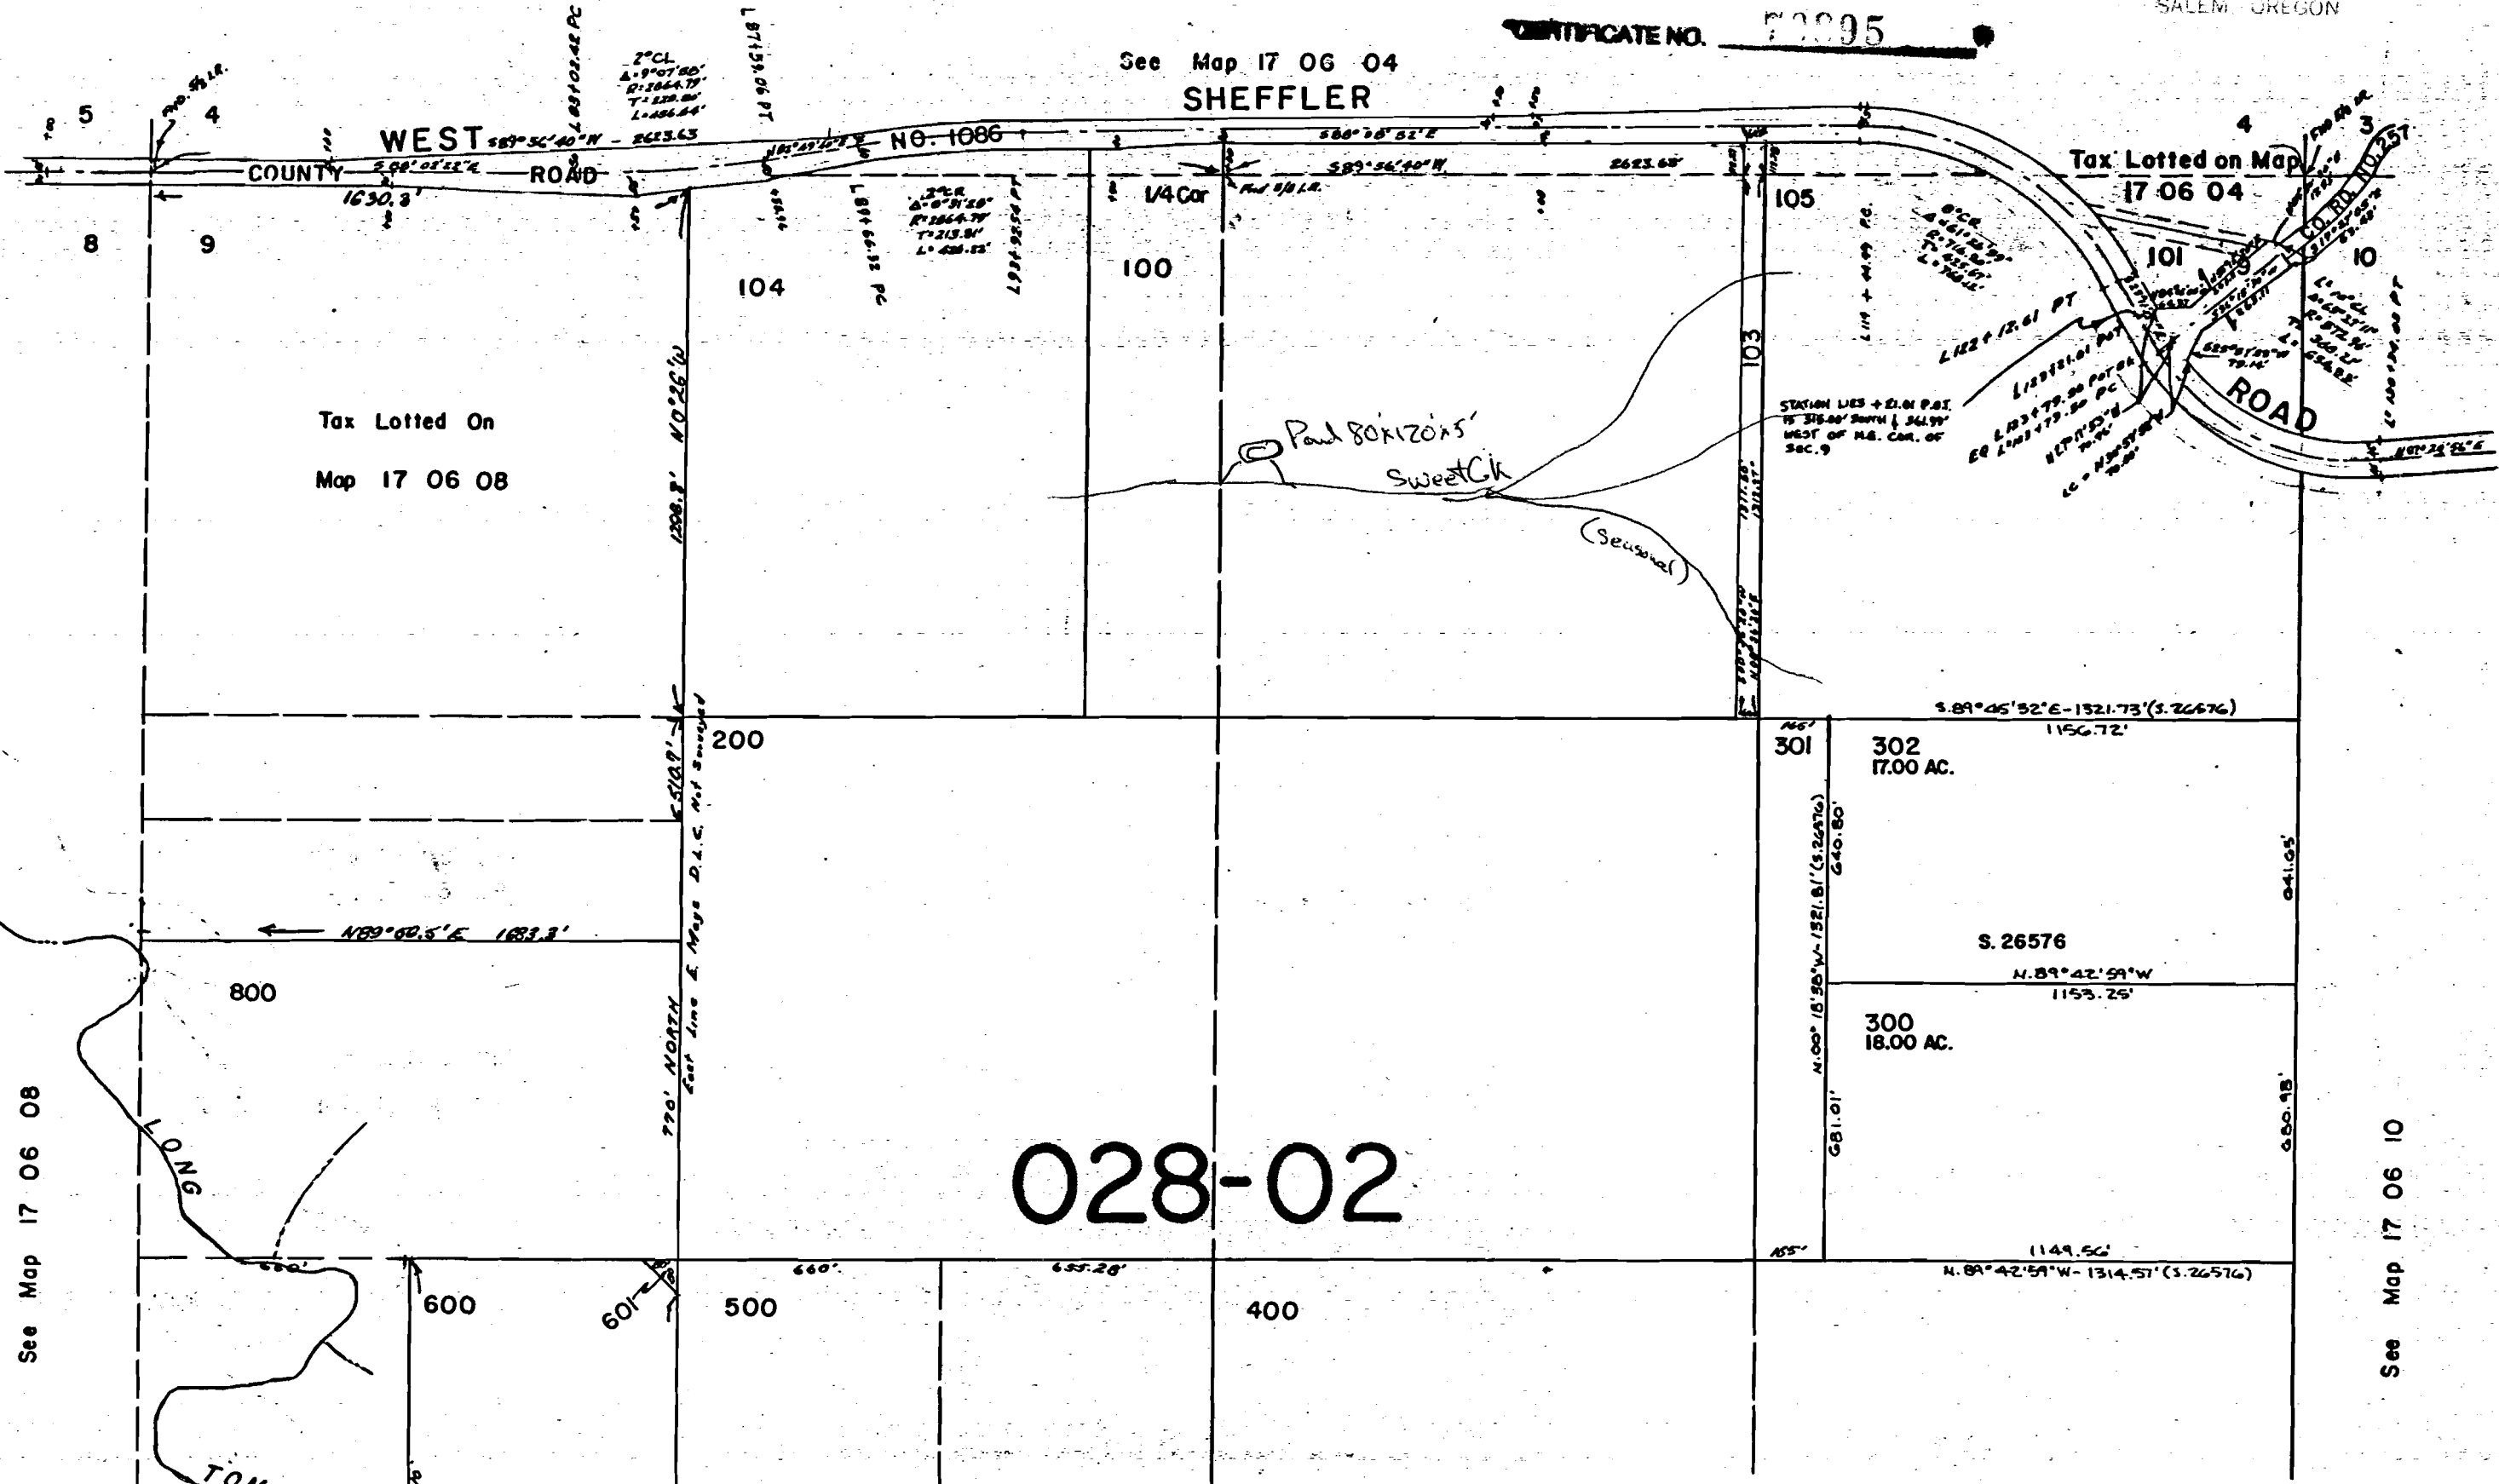

See Map 17 06 08

See Map 17 06 10

No Final Proof Map available

No Permit Map available