

T395 R12E

Application No. K-77014

RECEIVED

1998
PROCESSED

RECEIVED
JAN 09 1998
WATERMANS

5/6/98

CERTIFIED TRUE COPY OF ORIGINAL DOCUMENT

DATE 12/19/97
Photo & Video of EMPLOYEE

NEV 4
NEV 4
SECS 5

NEV 4
NEV 4
SECS 5

SEV 4
SEV 4
SECS 5

SEV 4
SEV 4
SECS 5


5

24.19
25.30



HEL
CRP
87-96
7
14.6

7

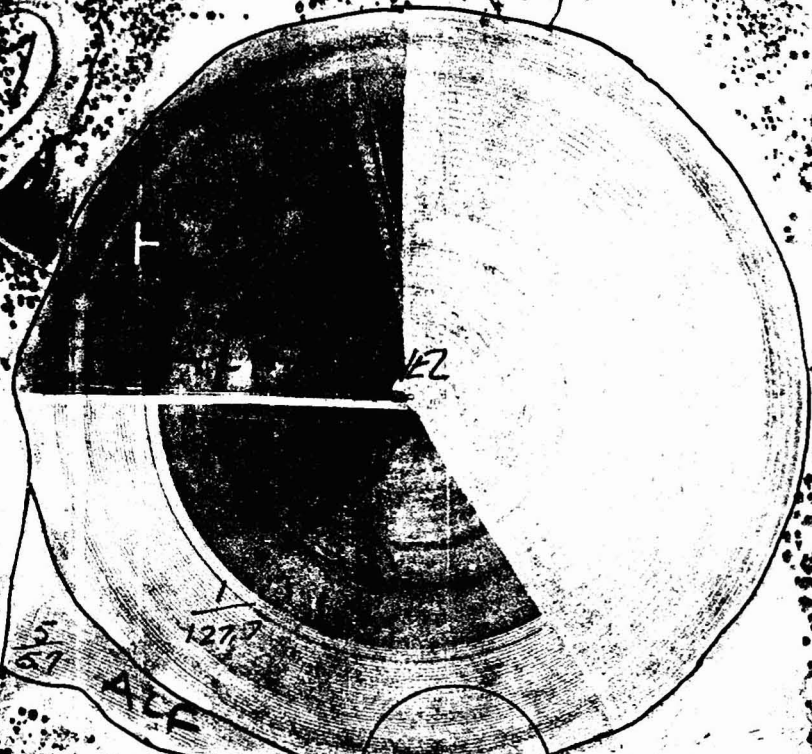

8

5
67
127.7
ACC

25.30
36.31

PAJ
HEL
9
11.5
CUPAN

PAJ
HEL
8
168
CUPAN

PAJ
HEL
10
86
CUPAN

No Final Proof Map available

No Permit Map available