


Map of Streams & waters  
to be appropriated by Henry Frohnhoffer.

Sec 24. Township 12 S. Range 15 East.

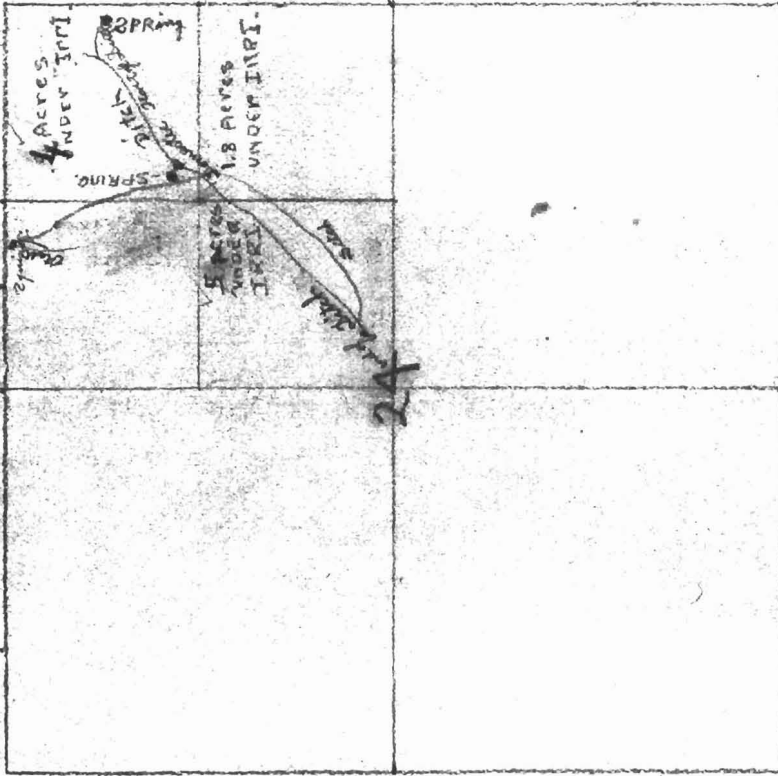

STATE ENGINEER  
RECEIVED  
NOV 19 1923  
OREGON

NOV 19 1923

SALEM, OREGON

Application No 9265  
Permit No 6138