


ROAD LOCATION MAP BURNT TABLE TIMBER SALE

T.38S., R.3E., WILL. MER.
T.39S., R.3E., WILL. MER.

SEE SHEET #1 FOR LEGEND

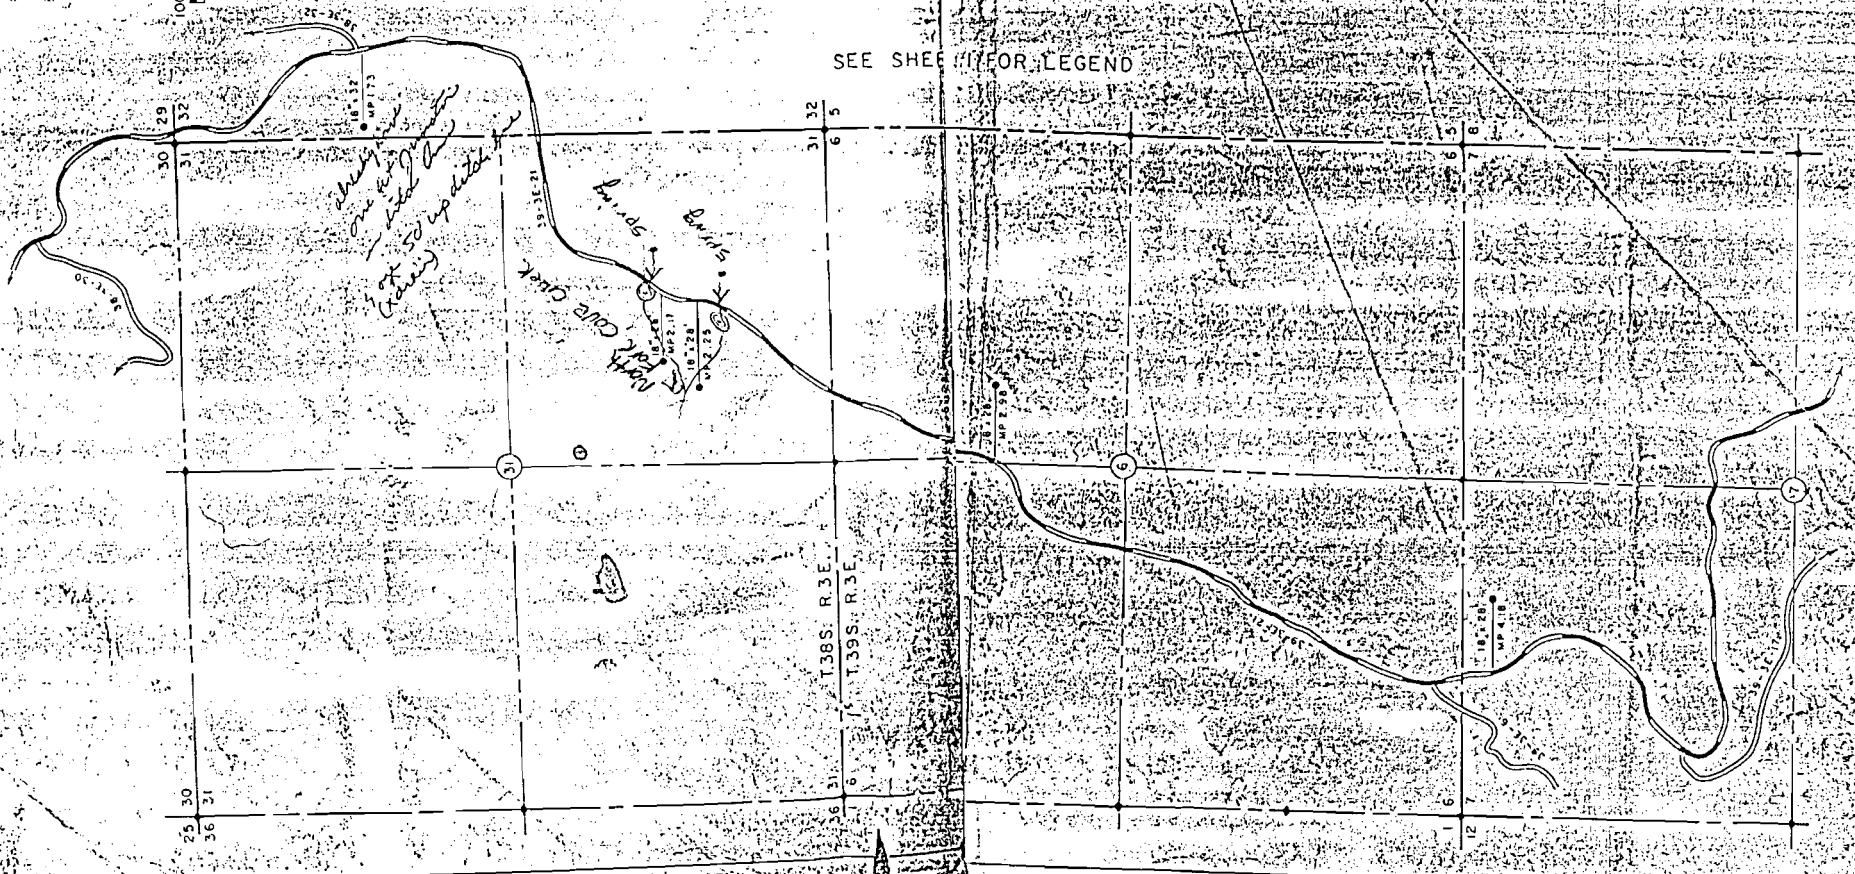

No Final Proof Map available

No Permit Map available