


**RECEIVED**

JAN - 5 1995


WATER RESOURCES DEPT  
SALEM, OREGON

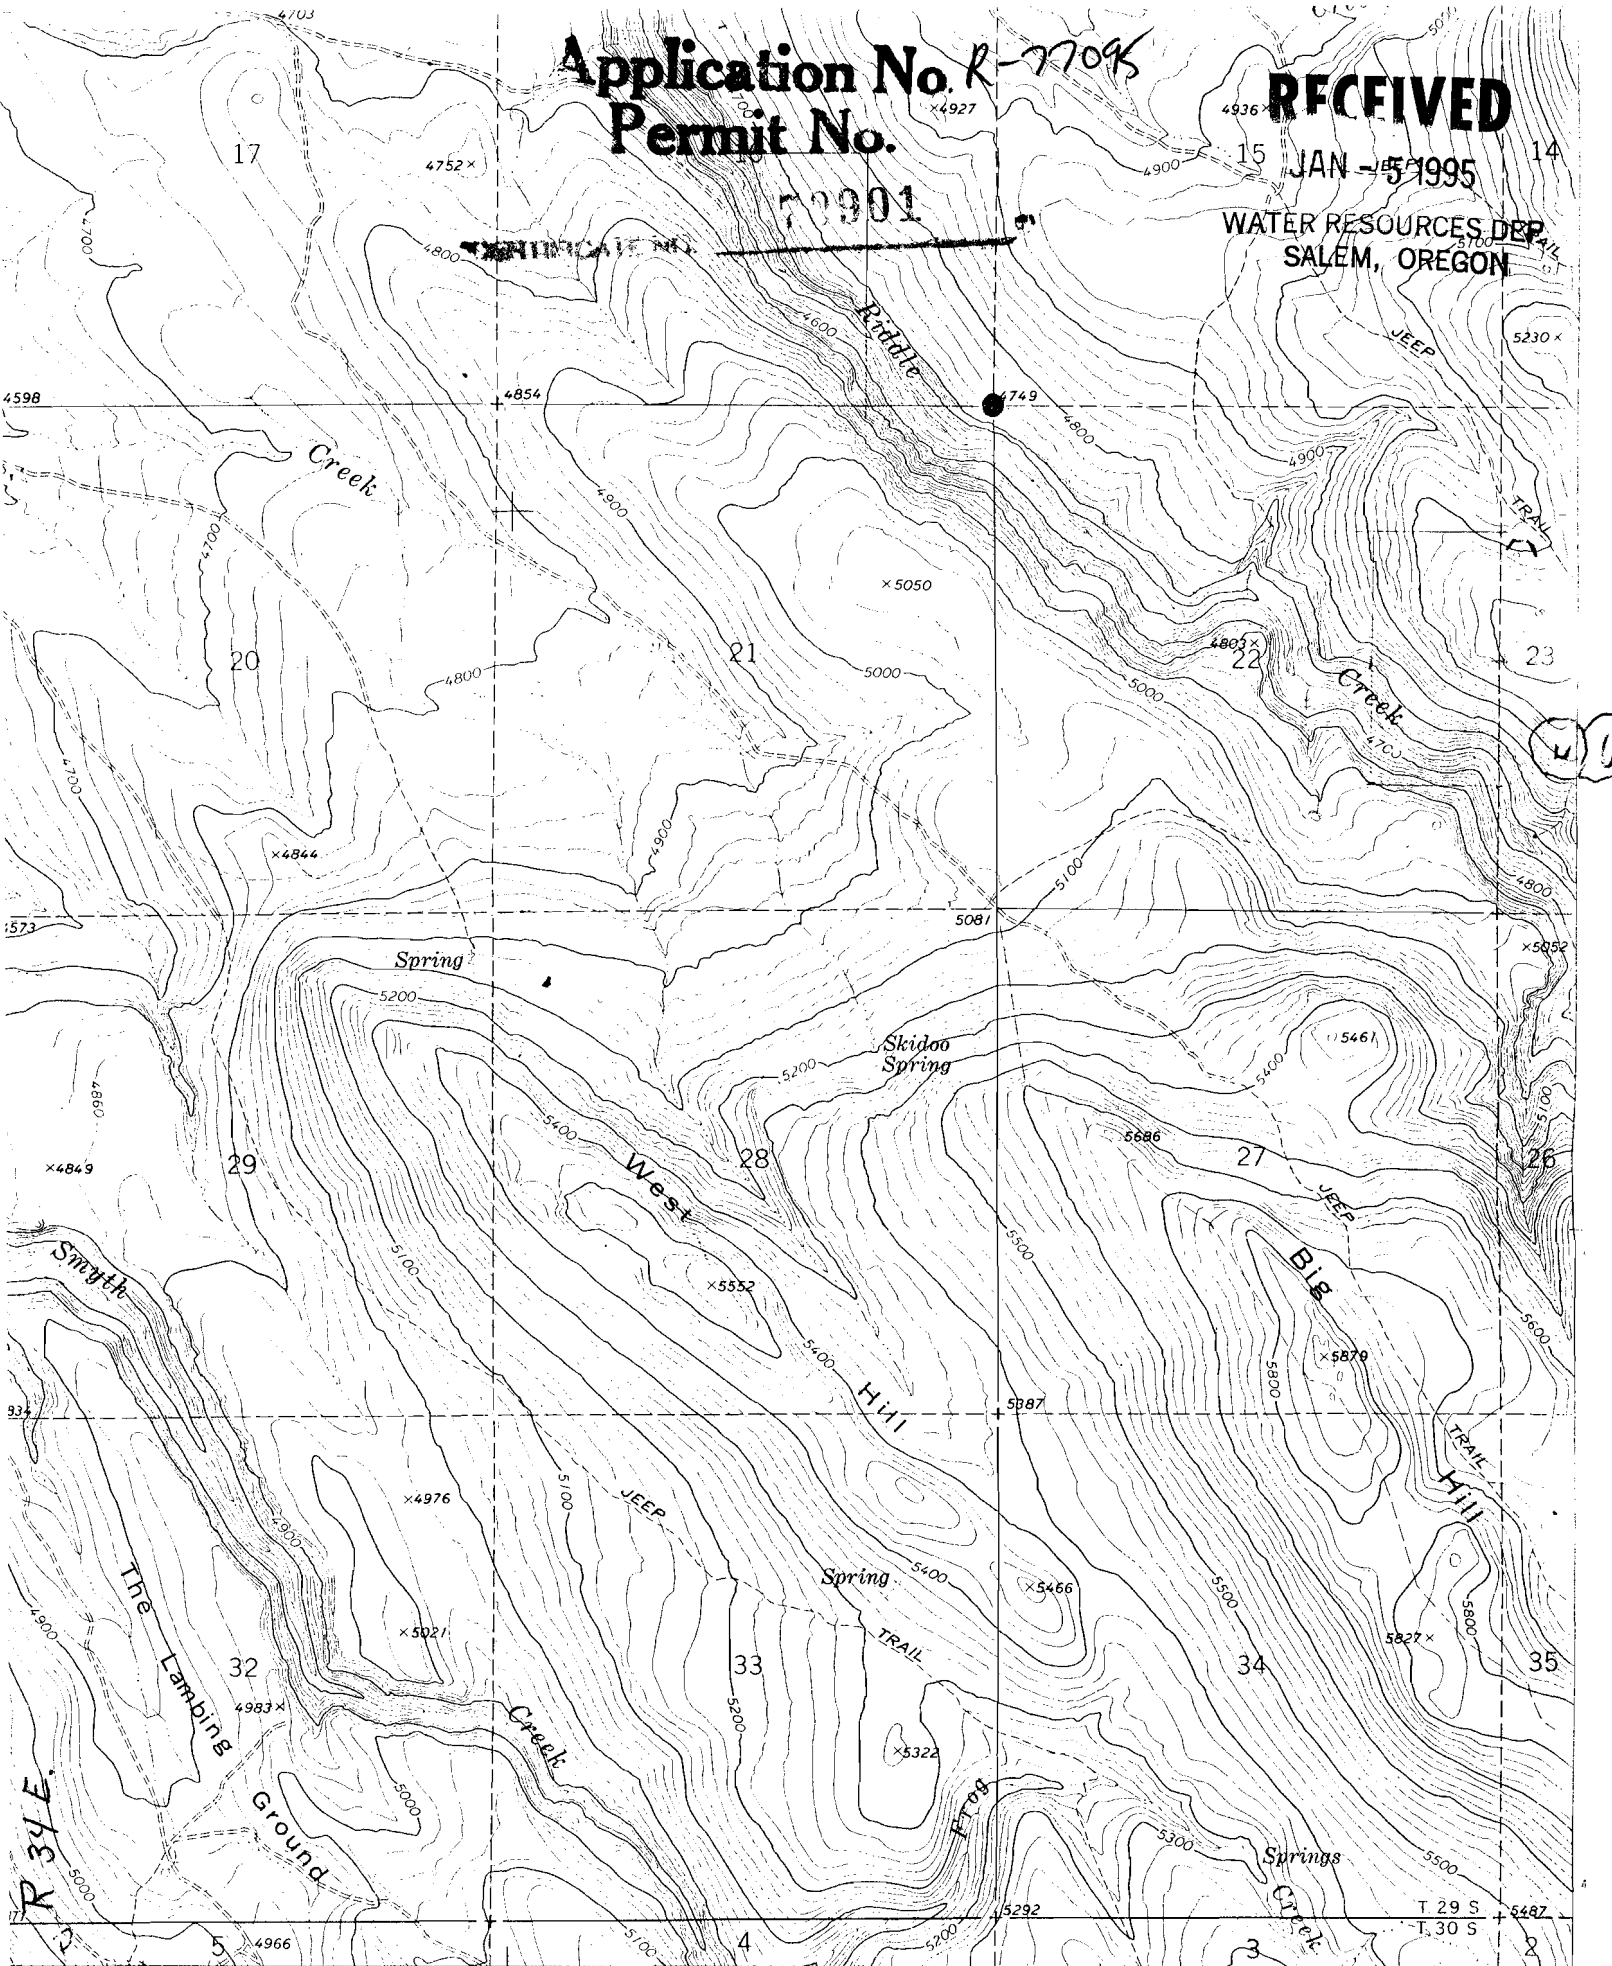

|        |     |     |        |
|--------|-----|-----|--------|
| RINGS) | 373 | 374 | 32'30" |
|--------|-----|-----|--------|

4000

4000 5000 6000 7000 FEE

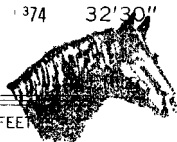

RIDDLE RANCH, INC.  
HC 72 Box 55  
Princeton, OR 97721

RIDDLE RANCH, INC.  
HC 72 Box 55  
Princeton, OR 97721

Happy Valley, Oreg. Quadrangle  
1967 1980  
Photo revised Harney Co.

ROAD CLASSIFICATION

INTERIOR—GEOLOGICAL SURVEY, RESTON, VIRGINIA— 1980


118°

Application No. R-77095  

RECEIVED

JAN - 5 1995

WATER RESOURCES DEPT  
SALEM, OREGON

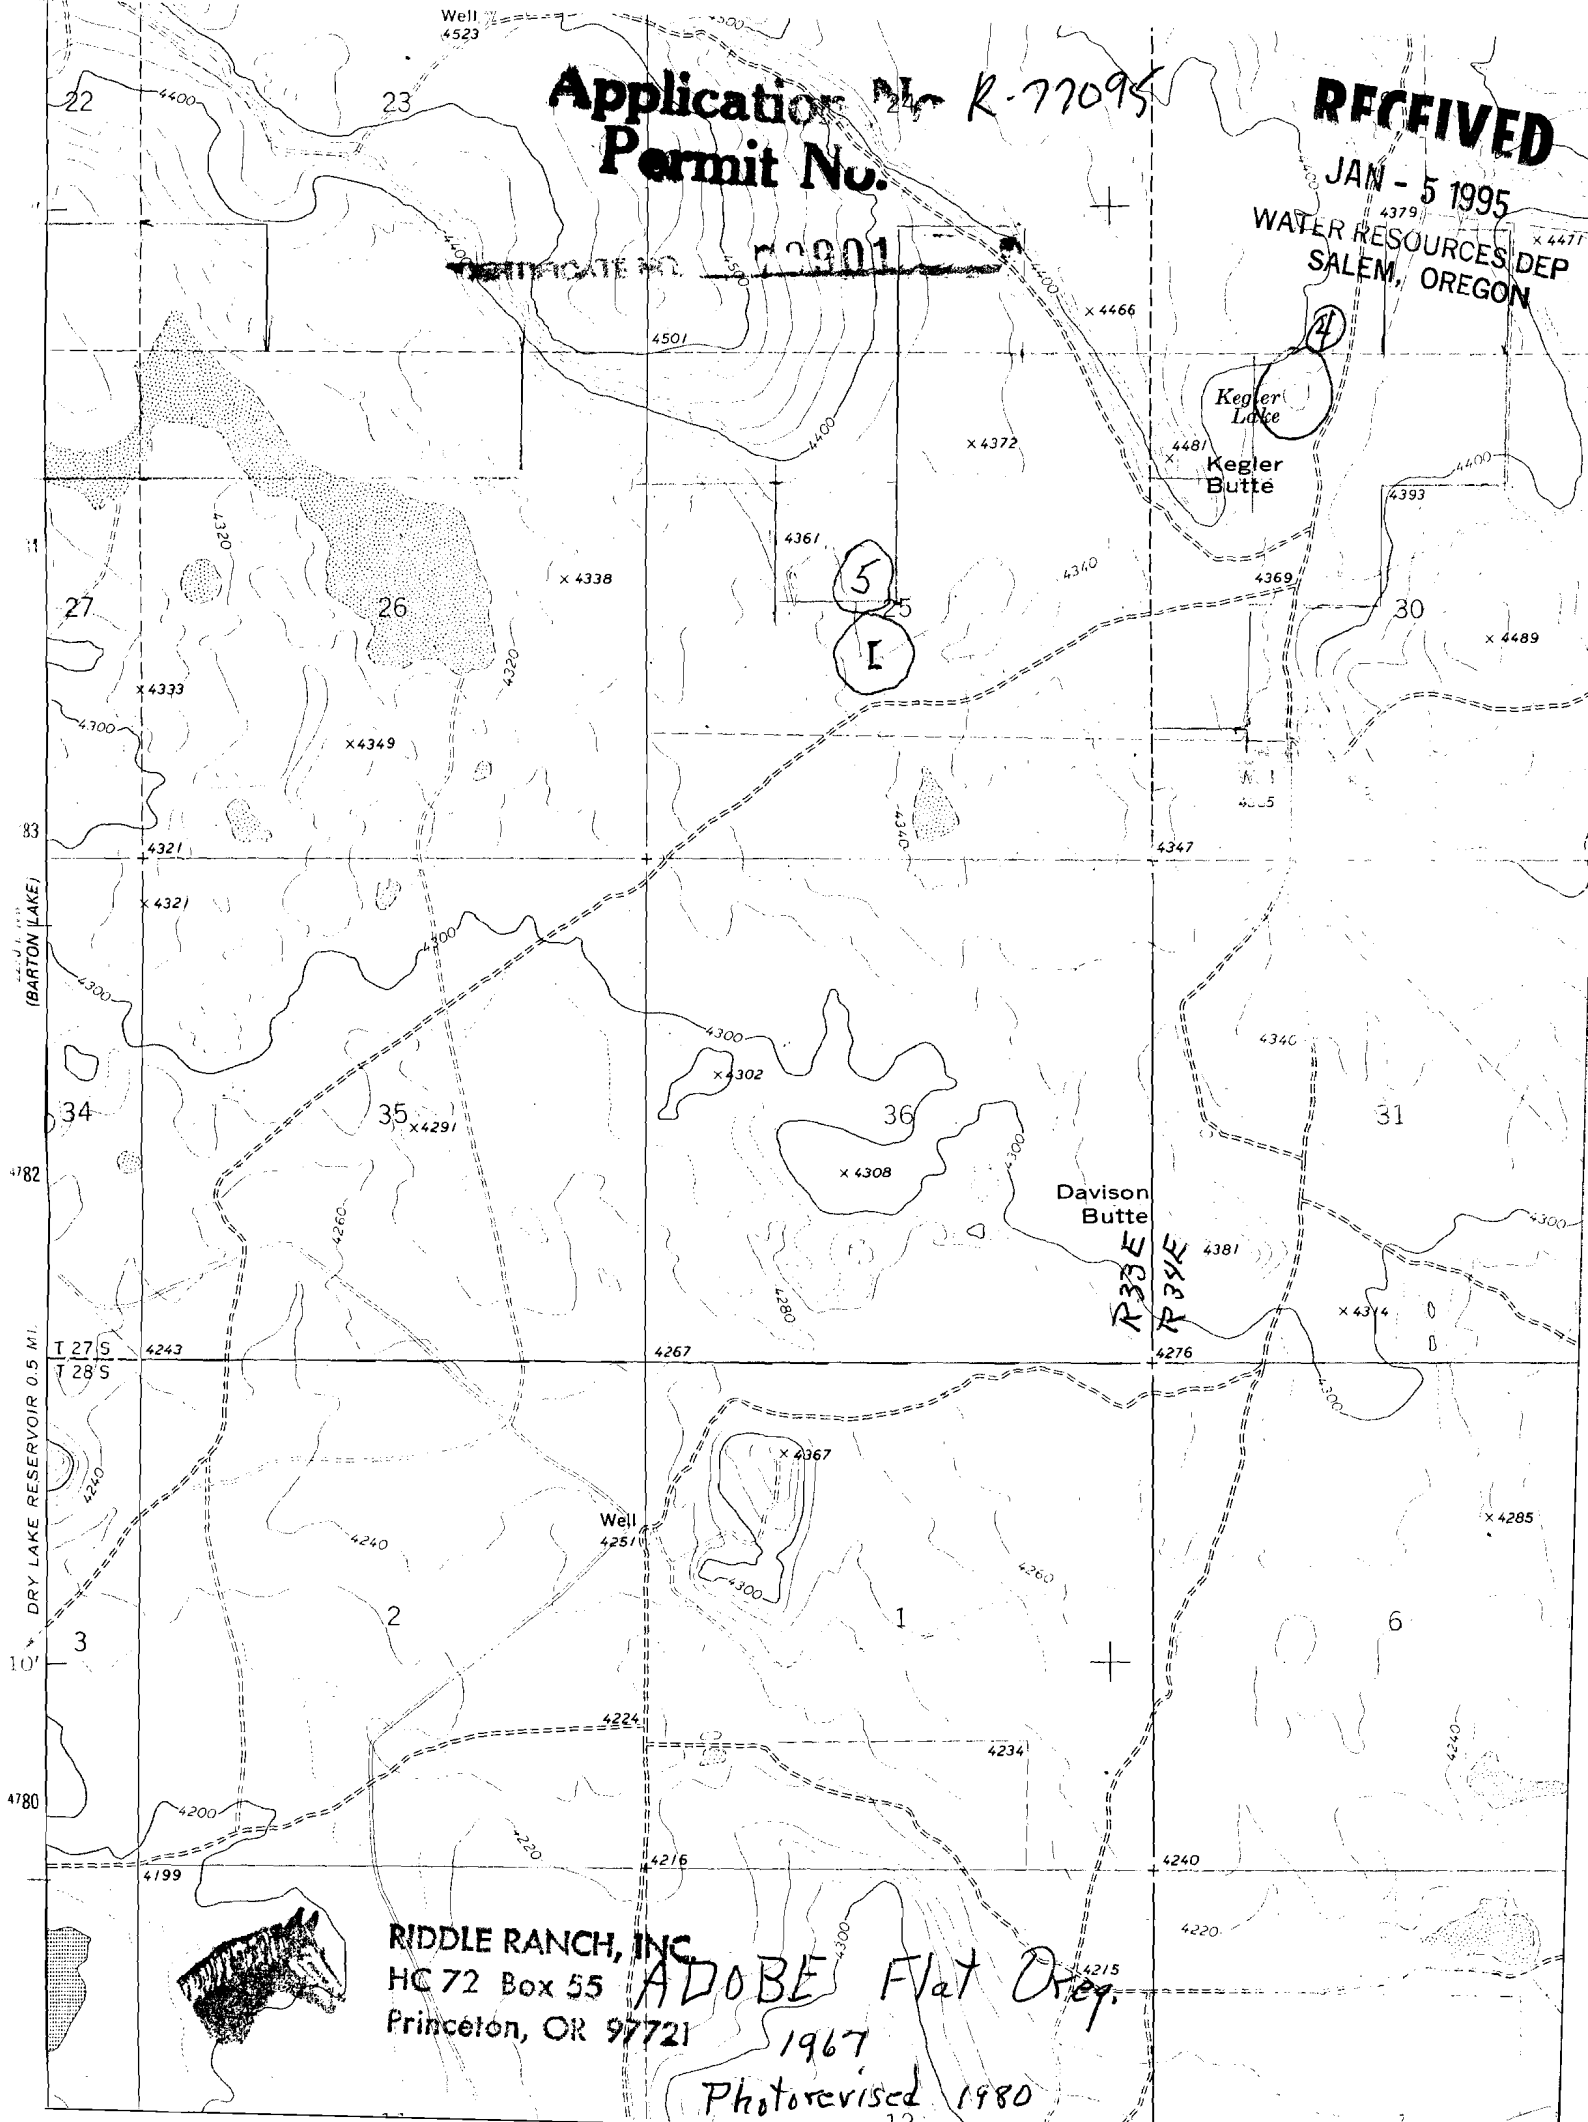

RIDDLE RANCH, INC  
HC 72 Box 55  
Princeton, OR 97721

ADOBE Flat Oreg.

1967


Photorevised 1980

Application No. **R-77095**  

**RECEIVED**

JAN - 5 1995

WATER RESOURCES DEPT  
SALEM, OREGON

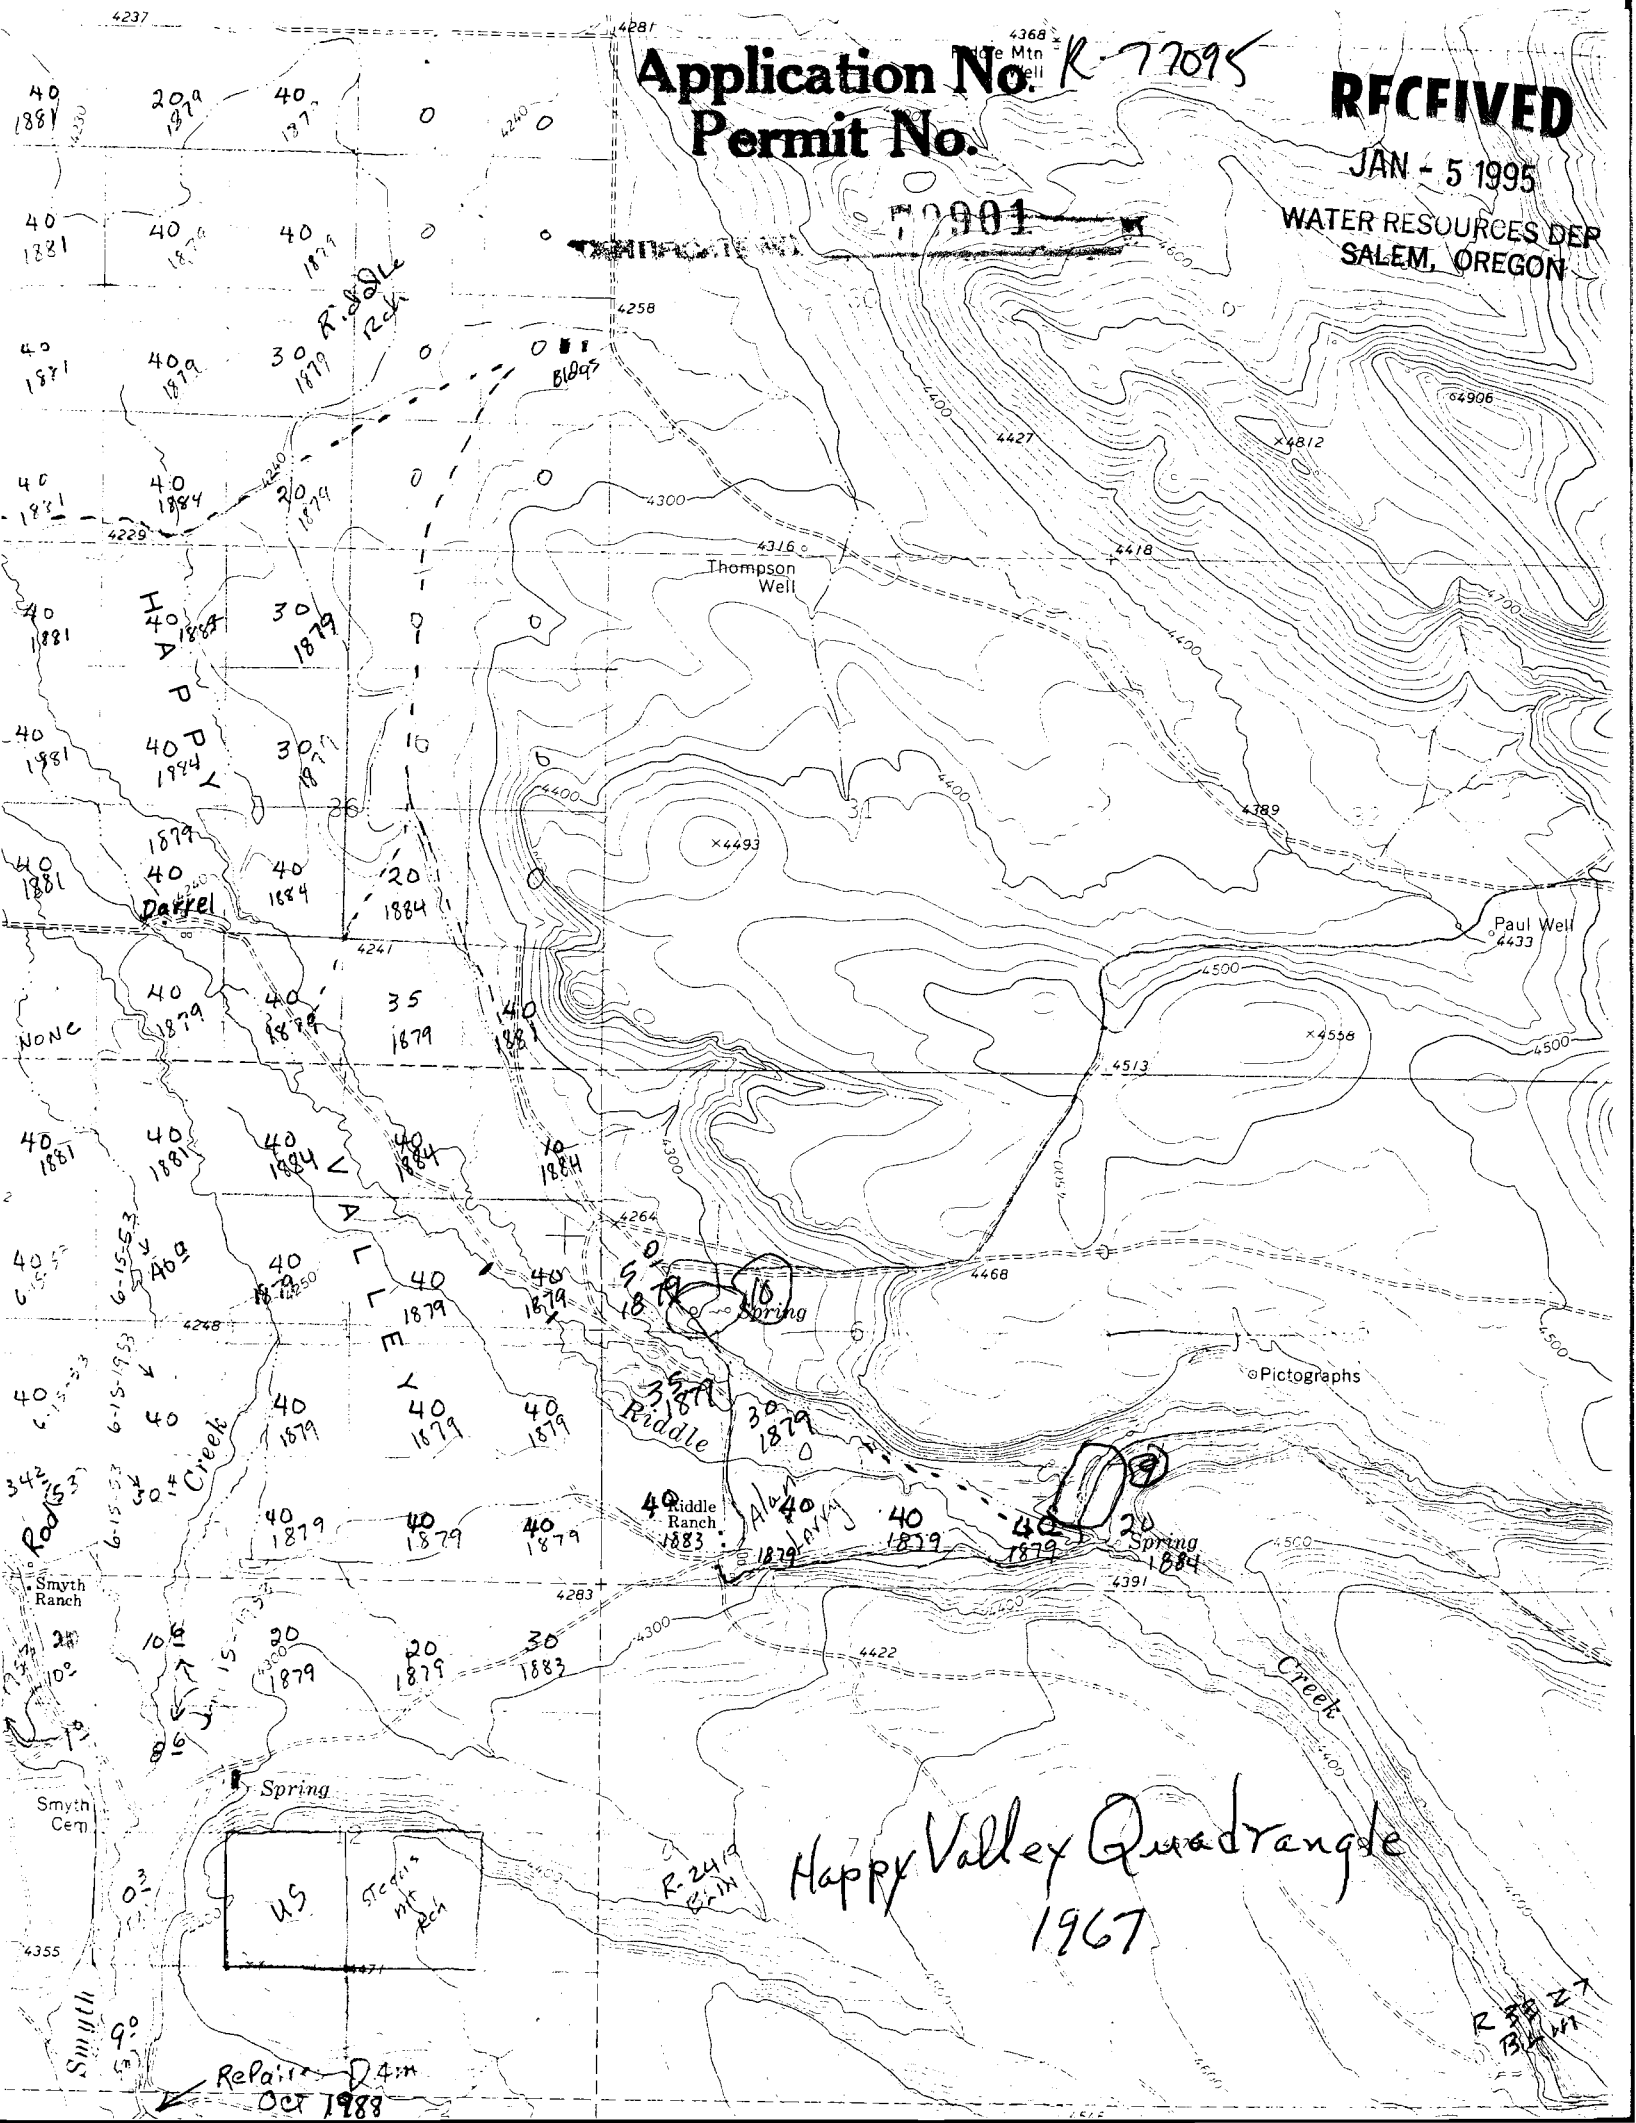

Happy Valley Quadrangle  
1967

US  
Smyth Ranch

Repair 24m  
Oct 1988

R-249  
B.M.


RIDDLE RANCH, INC.  
HC 72 Box 55  
Princeton, OR 97721

Application No. R-77095  
Permit No. 70901


RECEIVED


WATER RESOURCES  
SALEM, ORE

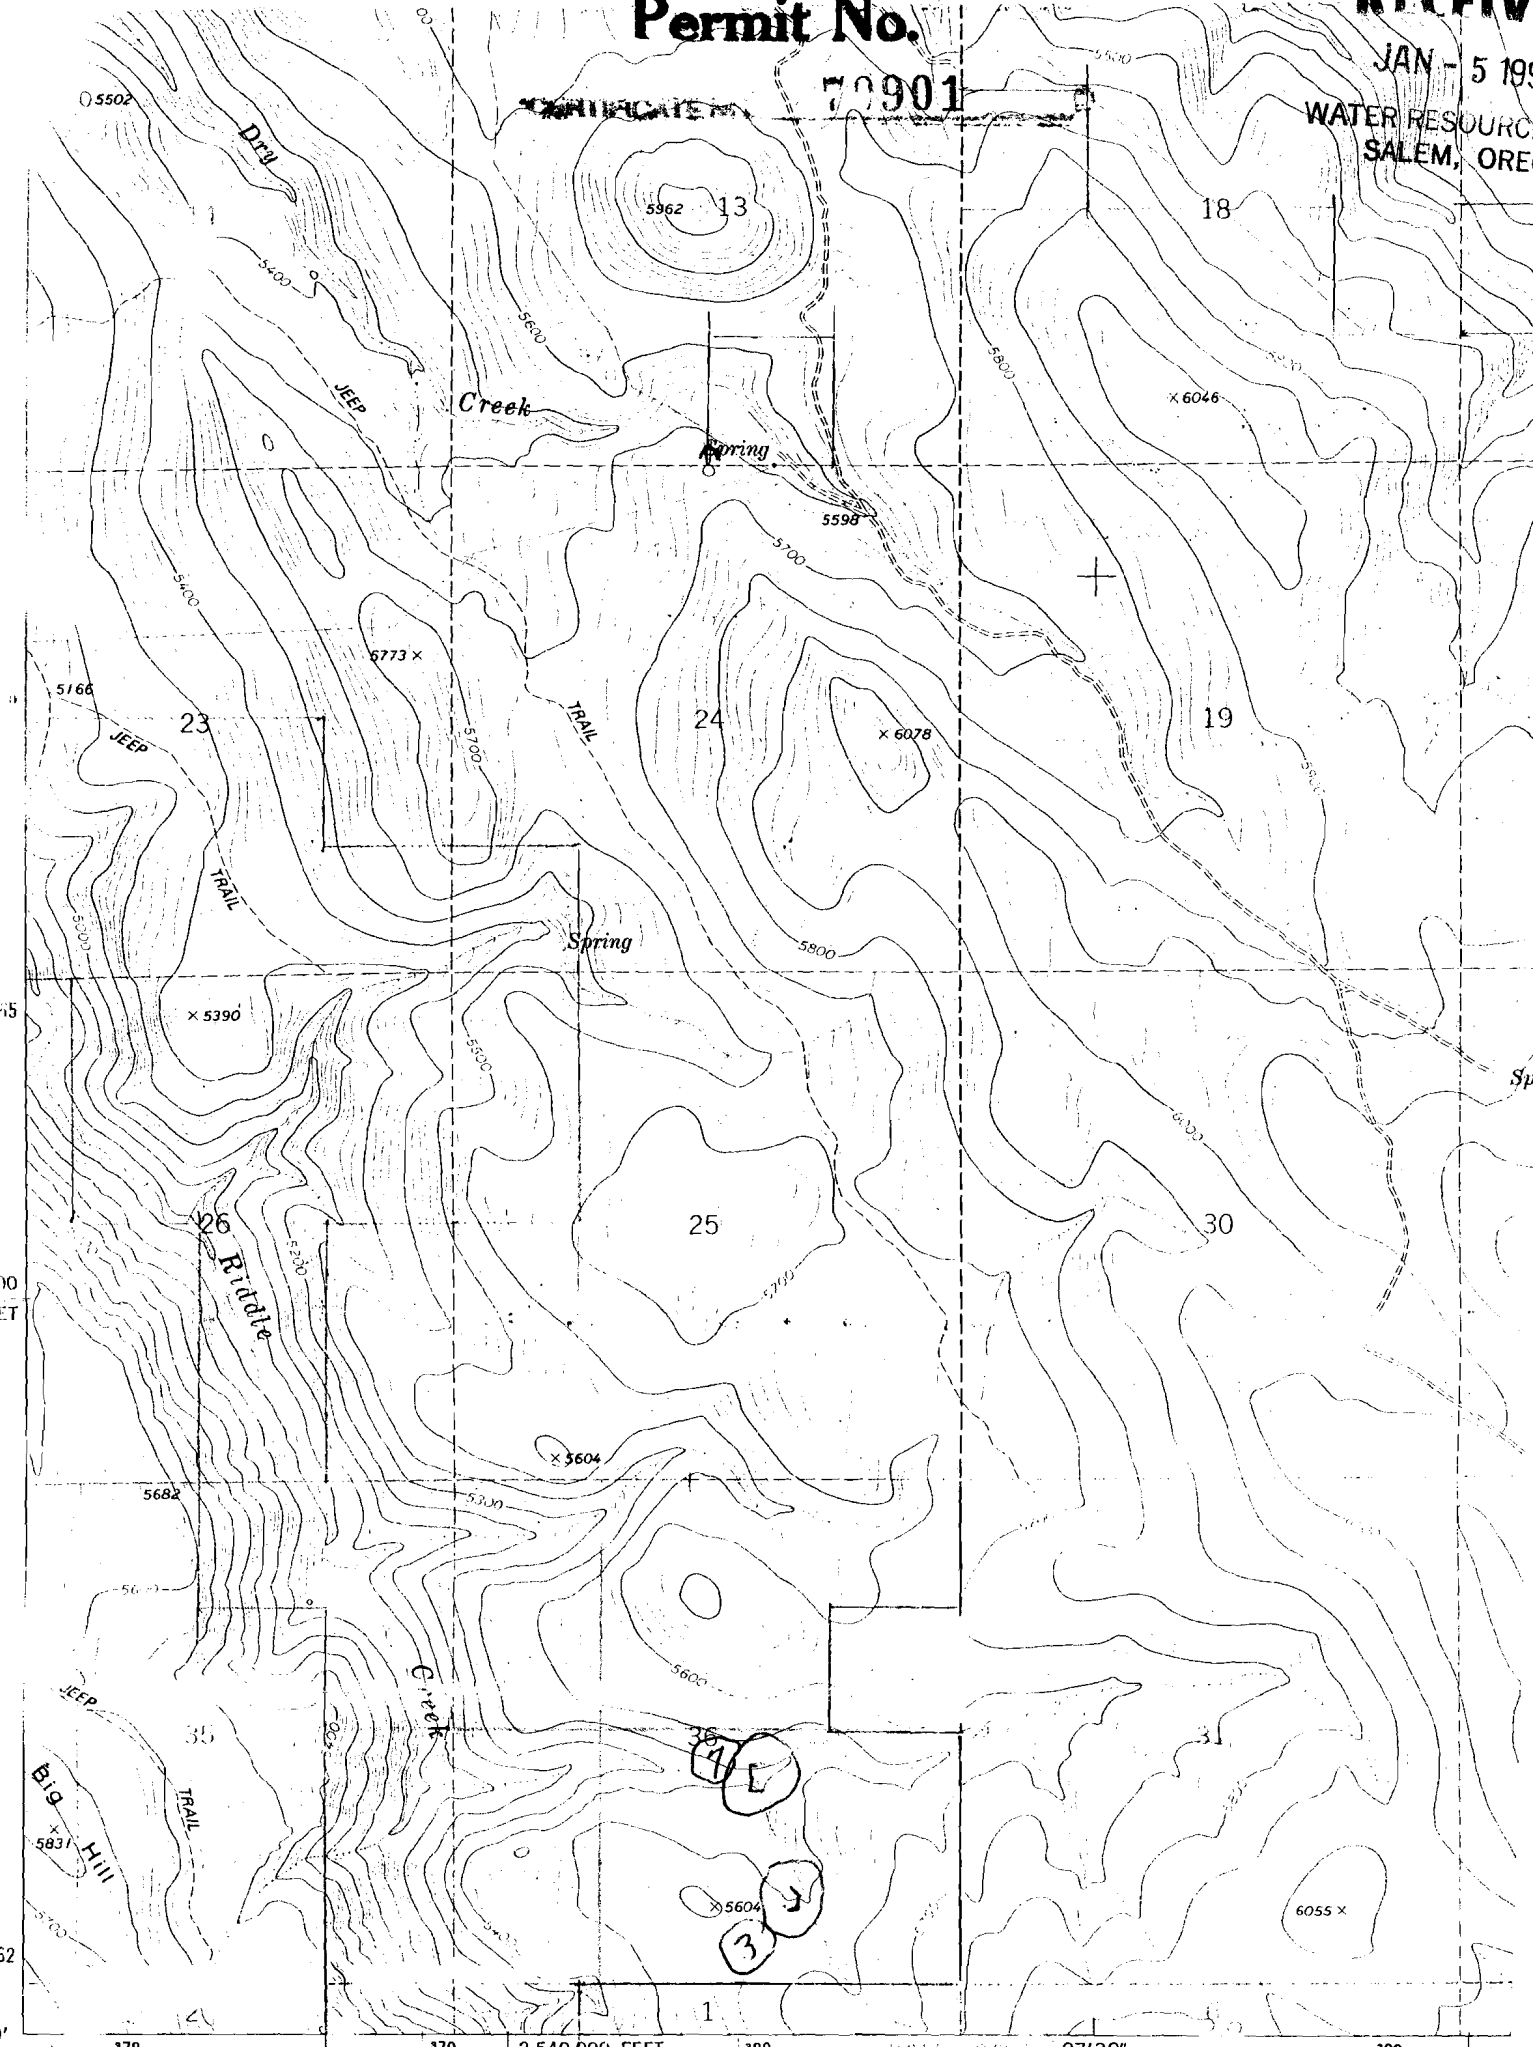

Map 1, edited, and published by the Geological Survey  
Contributed by USGS and NOS/NOAA  
Topography by photogrammetric methods from aerial  
photographs taken 1973. Field checked 1974  
Projection: Universal Transverse Mercator coordinate  
system, south zone (Lambert conformal conic)  
1000-meter Universal Transverse Mercator grid ticks,  
zone 11, shown in blue. 1974 North American datum  
Fine red dashed lines indicate selected fence and field lines  
where generally visible on aerial photographs  
This information is uncheckered

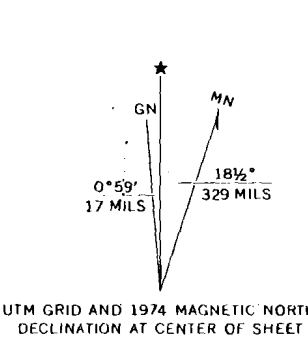

**RIDDLE RANCH, II**  
HC 72 Box 65  
Princeton, OK 97  
NATIONAL GEOGRAPHIC  
**RIDDLE RANCH**  
HC 72 Box 65  
Princeton, OK  
THIS MAP COMPLIES  
FOR SALE BY U. S. GEOLOGICAL SURVEY  
A FOLDER DESCRIBING TOPOGRAPHY

Anderson MTN., Oreg  
SW/4 Anderson MTN. 151 Quadrangle  
1974

Application No R-77095  
Permit No.


RECEIVED

JAN - 5 1995

WATER RESOURCES DEP.  
SALEM, OREGON

CERTIFICATE NO.

