


RECEIVED

JAN 31 1996

WATER RESOURCES DEPT.
SALEM, OREGON

T. 18 & 19 S., R. 2 W., W.M.

RECEIVED
JAN - 4 1995
WATER RESOURCES DEPT.
SALEM, OREGON

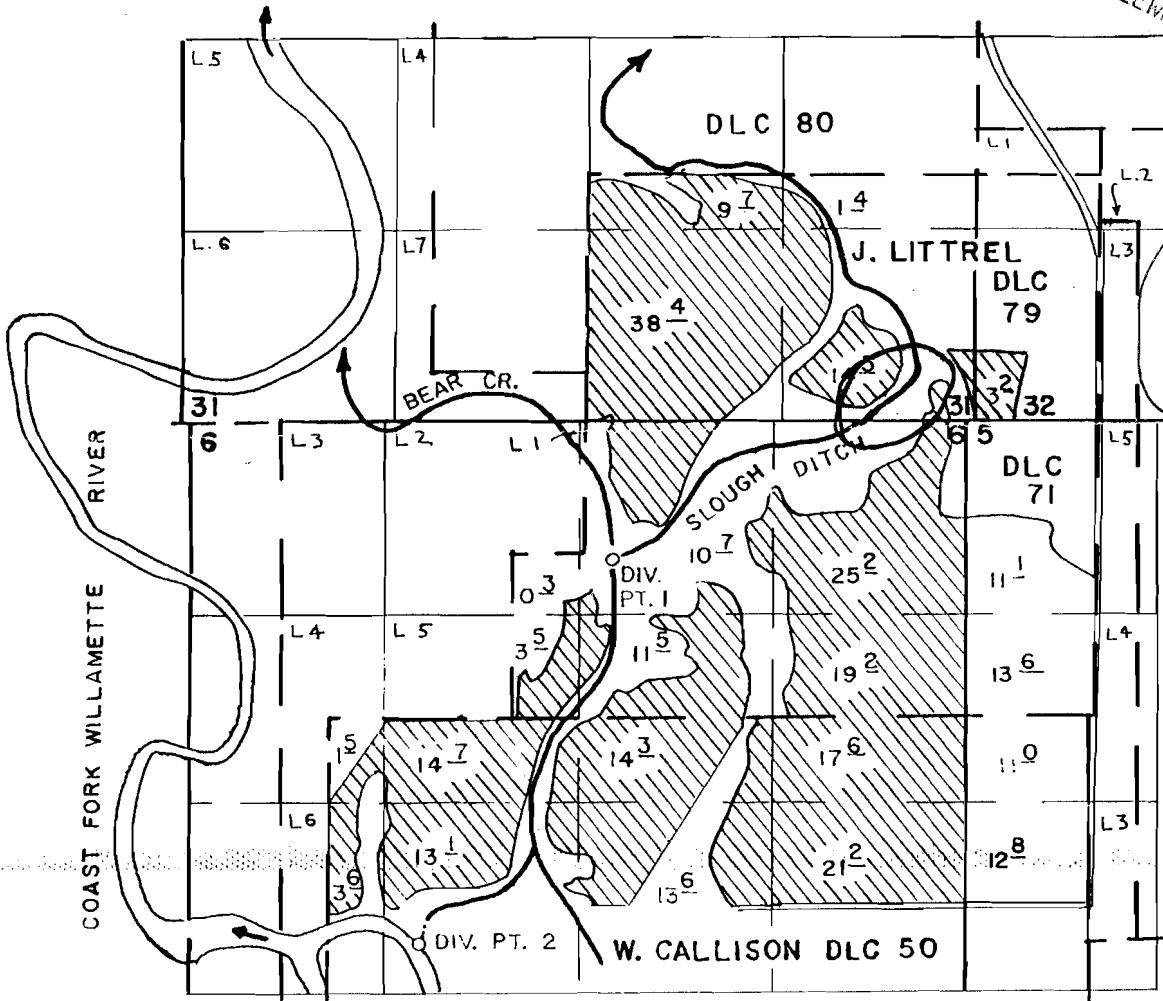

DIV. PT. 1 LOC. 1110' N. & 700' E.;
PT. 2 LOC. 1550' S. & 630' W. Both from SW COR. DLC 71.

Application No. R-77097
Permit No.

FINAL PROOF SURVEY
UNDER



SCALE
1" = 1320'

Application No. 52023 Permit No. 38199.....
IN NAME OF

LARRY J. & CORRIN M. SCHRENK

Surveyed AUG 27 1984, by P. PAGTER.....

No Final Proof Map available

No Permit Map available