

STALLER Application No. R-77099
Permit No. NECOR DLC 48

Section 9 T 36 S RIW WM

Scale 1" = 400'

36 1W 4

Eagle Point Irrigation District Map

Slash marks show ditch water run-off area.

Yellow outline shows tax lot 2400 (36 1W 4) - Staller


Area Irrigated
by Pond
approx. 12
acres

- STALLER
- SCHENFISH
- SIRIANNI
- WILKERSON

IMPORTANT
THIS MAP FOR ASSESSMENT
& TAXATION PURPOSES
ONLY

Oct-196
36 1W 9

CERTIFICATE NO. 1935

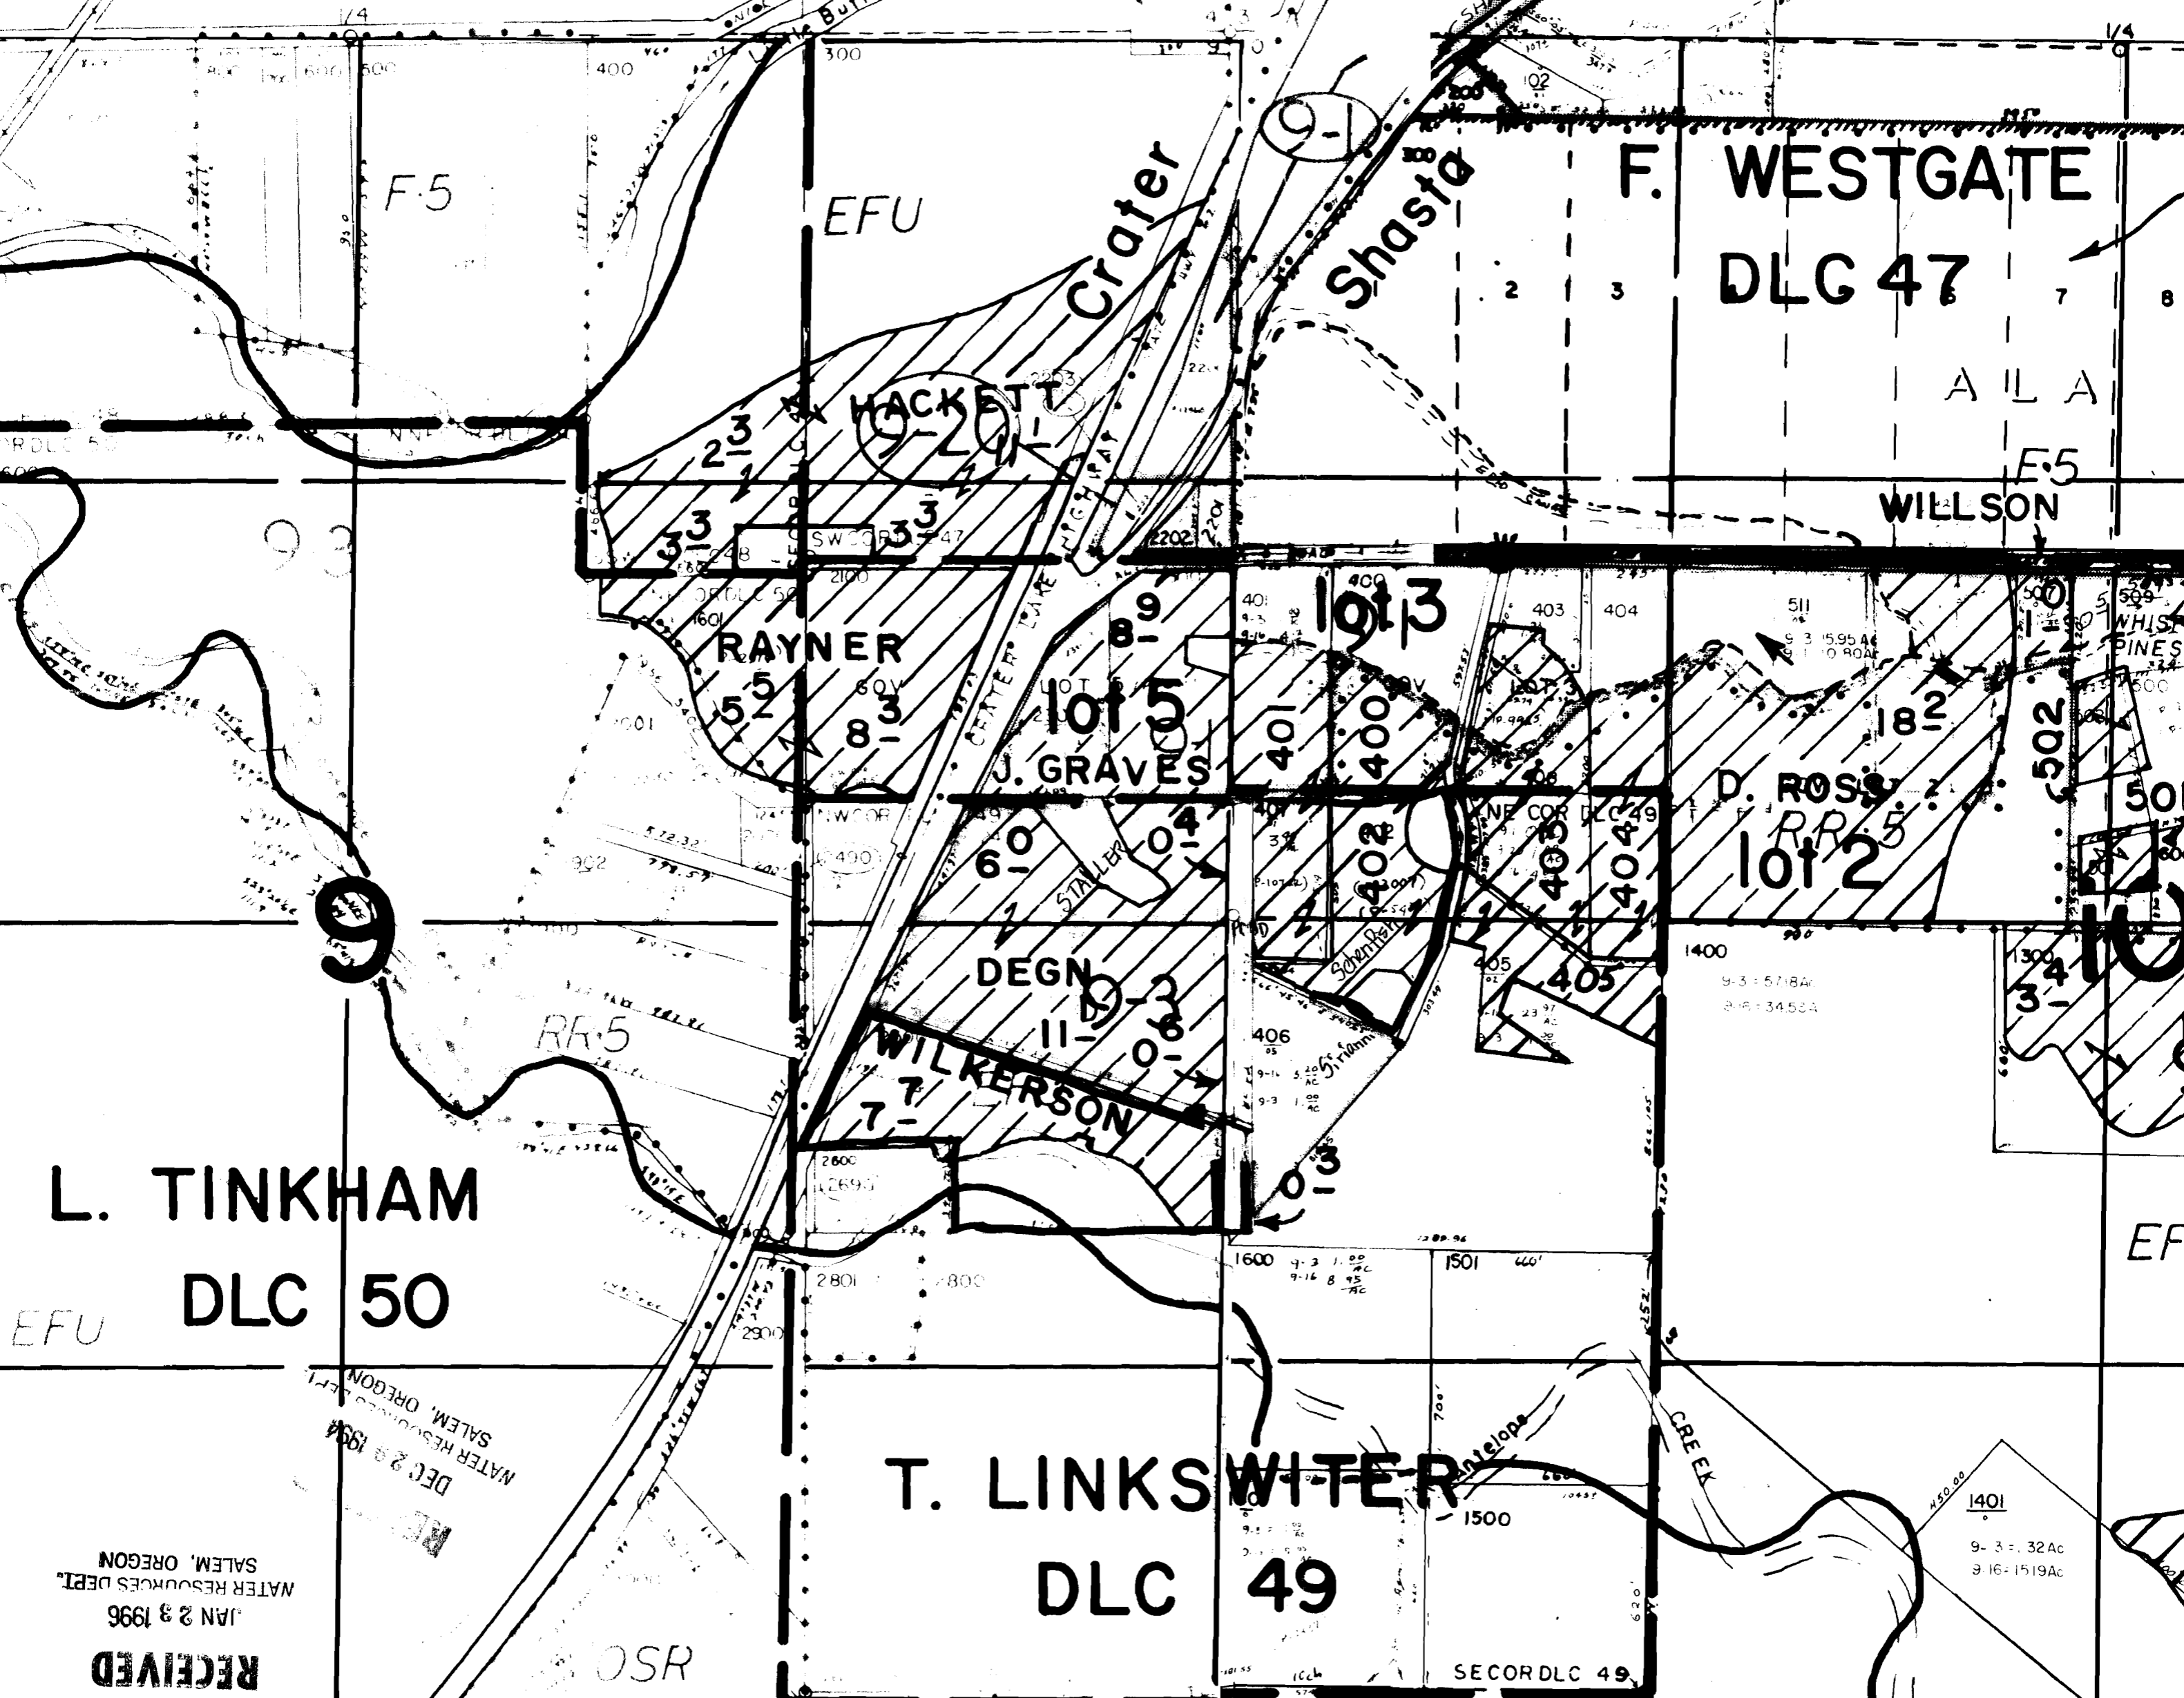

DEC 2 1994
MATER RESOURCES DEPT.
SALEM, OREGON

JAN 2 1996
MATER RESOURCES DEPT.
SALEM, OREGON

RECEIVED

(P-10094)
(P-10178)

EFU

EFU

SECOR DLC 49

CSR

1401
9-3 = 32Ac
9-16 = 1519Ac

WHISPER
PINES

501

500

500

No Final Proof Map available

No Permit Map available