

Application No. R-77135
Permit No.

CERTIFICATE NO. 70012

SEE MAP
2N2 35

WASHINGTON COUNTY
DEPT. OF REVENUE
ASSESSMENT DIVISION

SEP 07 1994

FOR ASSESSMENT PURPOSES ONLY - DO NOT RELY ON

FOR ASSESSMENT
PURPOSES ONLY.
DO NOT RELY ON
FOR ANY OTHER USE.

1-24

700
74.39 Ac.

801
43.98 Ac.

TERM. RELOCATION
C.R. 10 BK 4 P 79

800
15.98 Ac.

807
2.52 Ac.

1100
59.94 Ac.

805
2.05 Ac.

806
5.00 Ac.

804
9.00 Ac.

902
20.70 Ac.

1000
14.79 Ac.

901
42.83 Ac.

701
5.00 Ac.

1300
19.41 Ac.

SEE MAP
IN 2 3

RECEIVED
JAN 03 1995
WATERMASTER
HILLSBORO, OR

2N2 34


WASHINGTON COUNTY OREGON

JAN 03 1995

WASHINGTON COUNTY OF
70912
"CERTIFICATE NO. _____" SCALE 1"=400'

Application No. R-77135
Permit No.

M U L T N O M A H

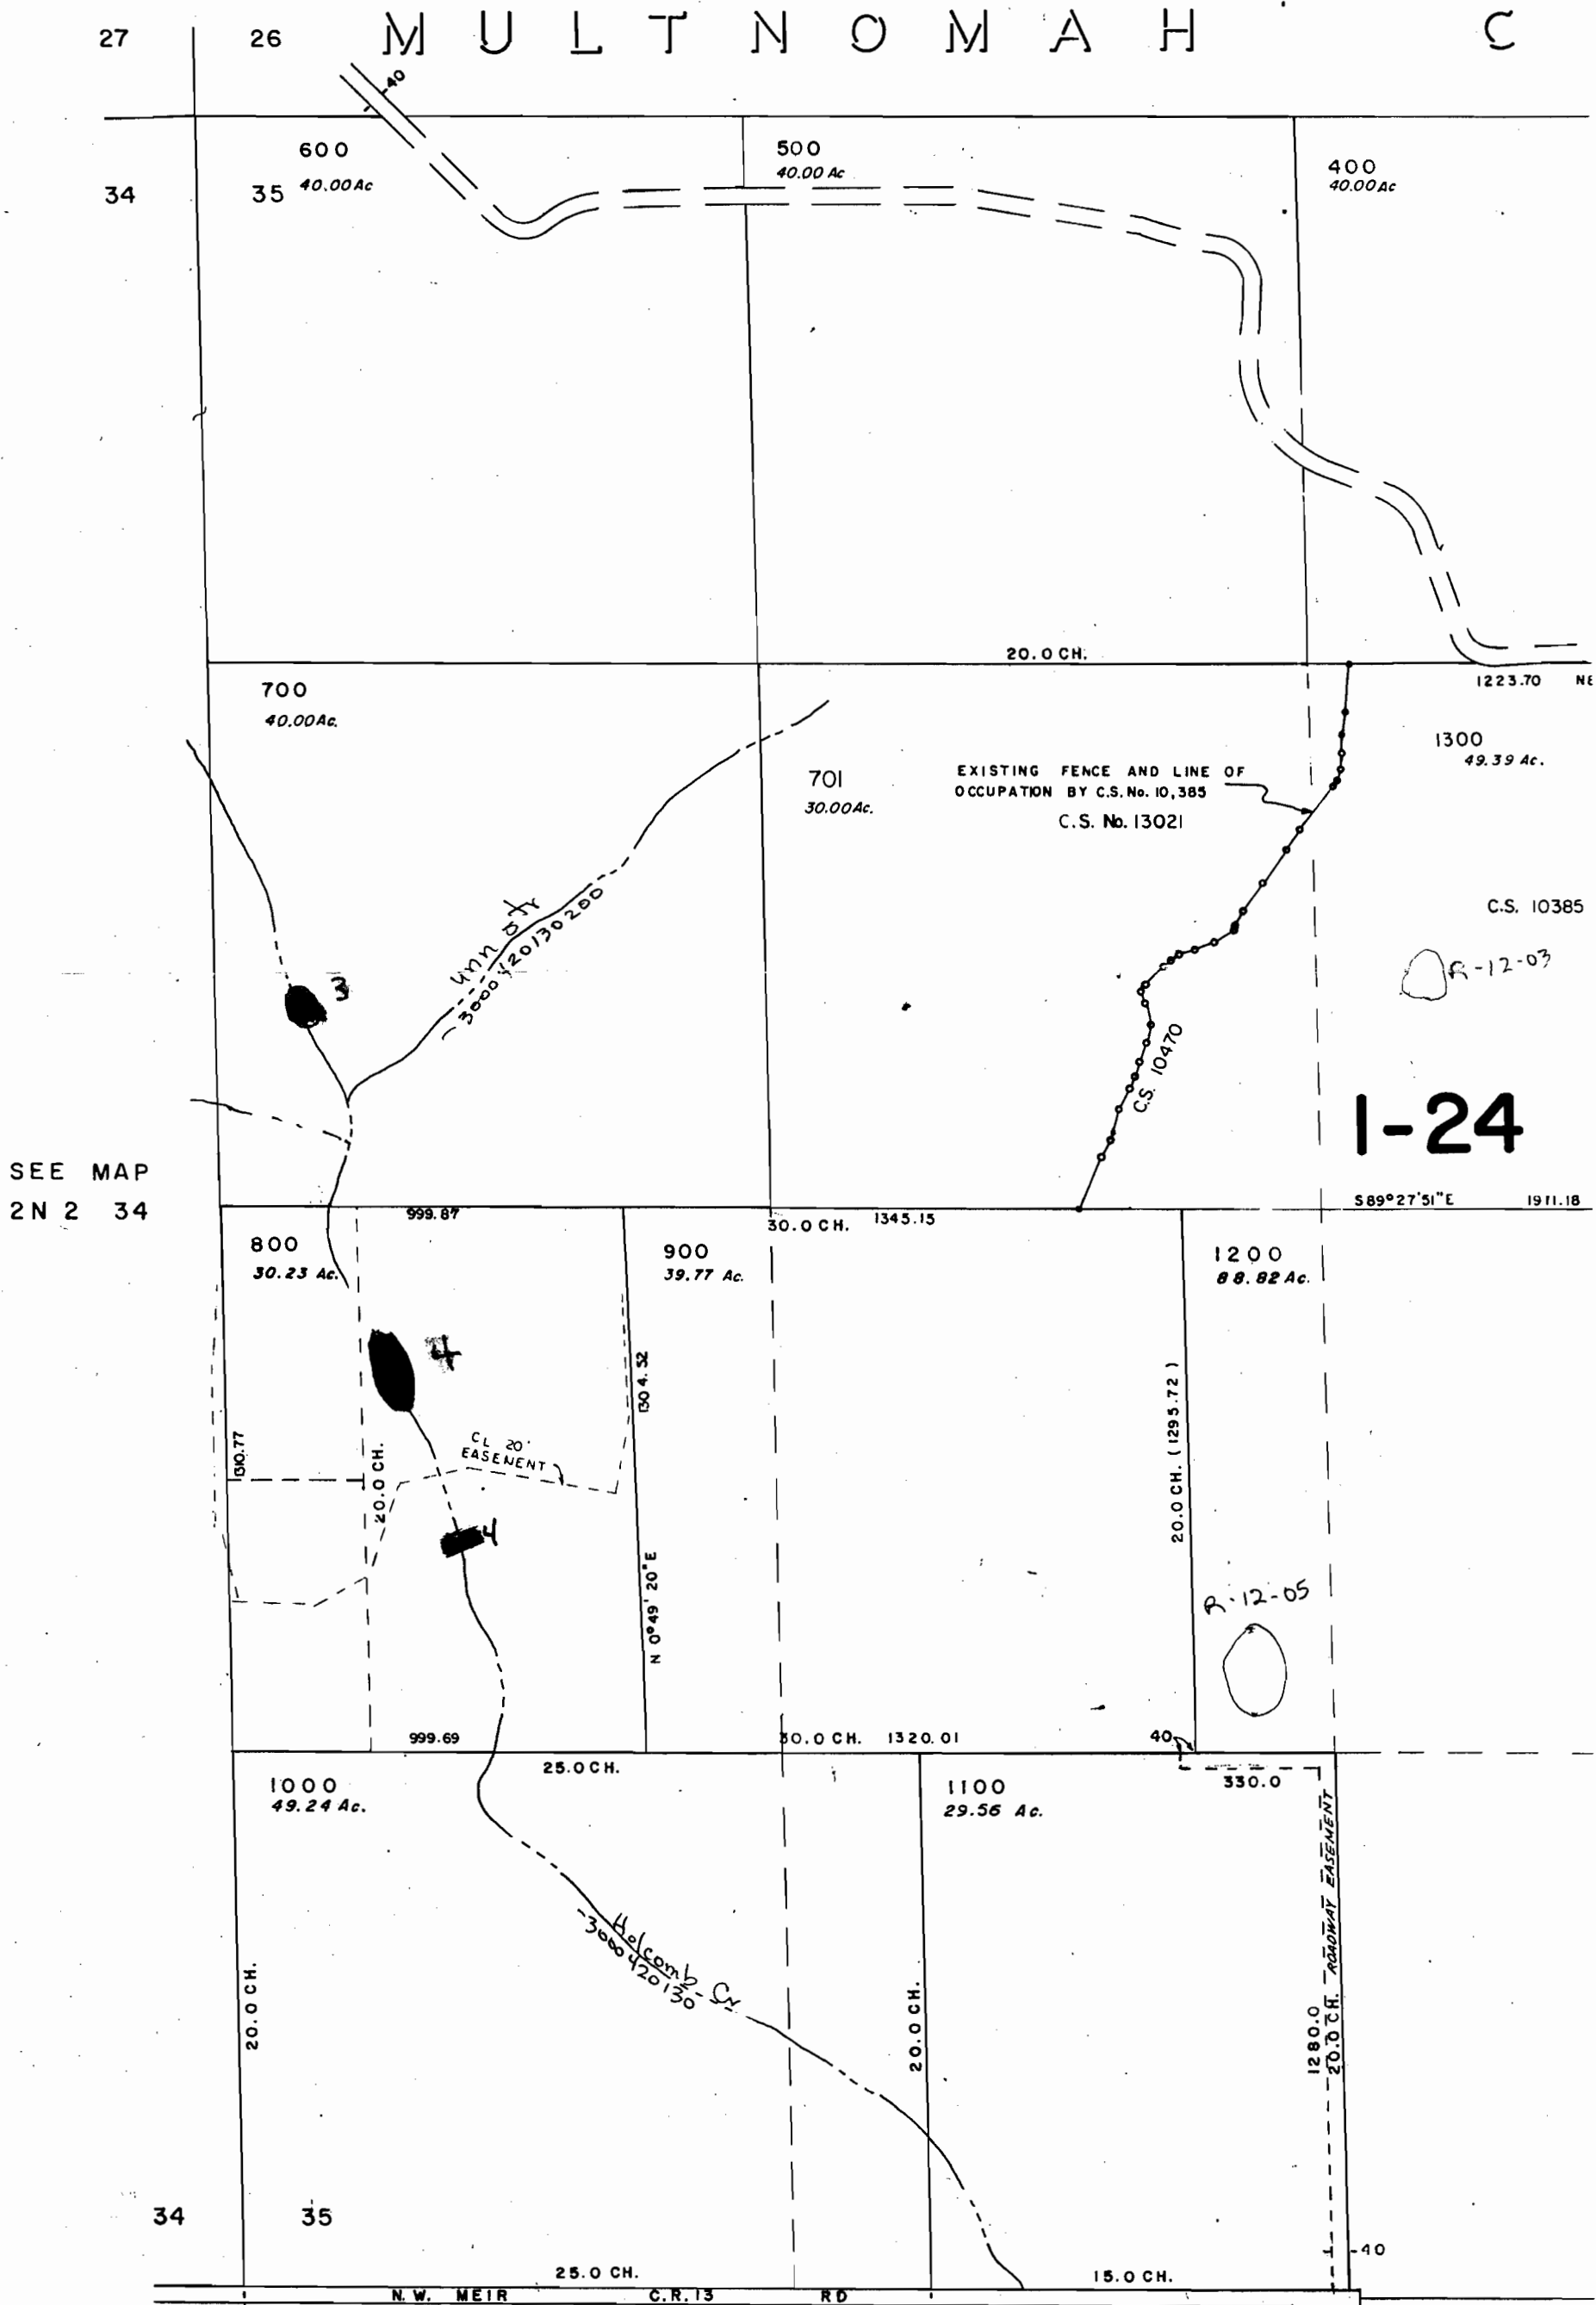

No Final Proof Map available

No Permit Map available