


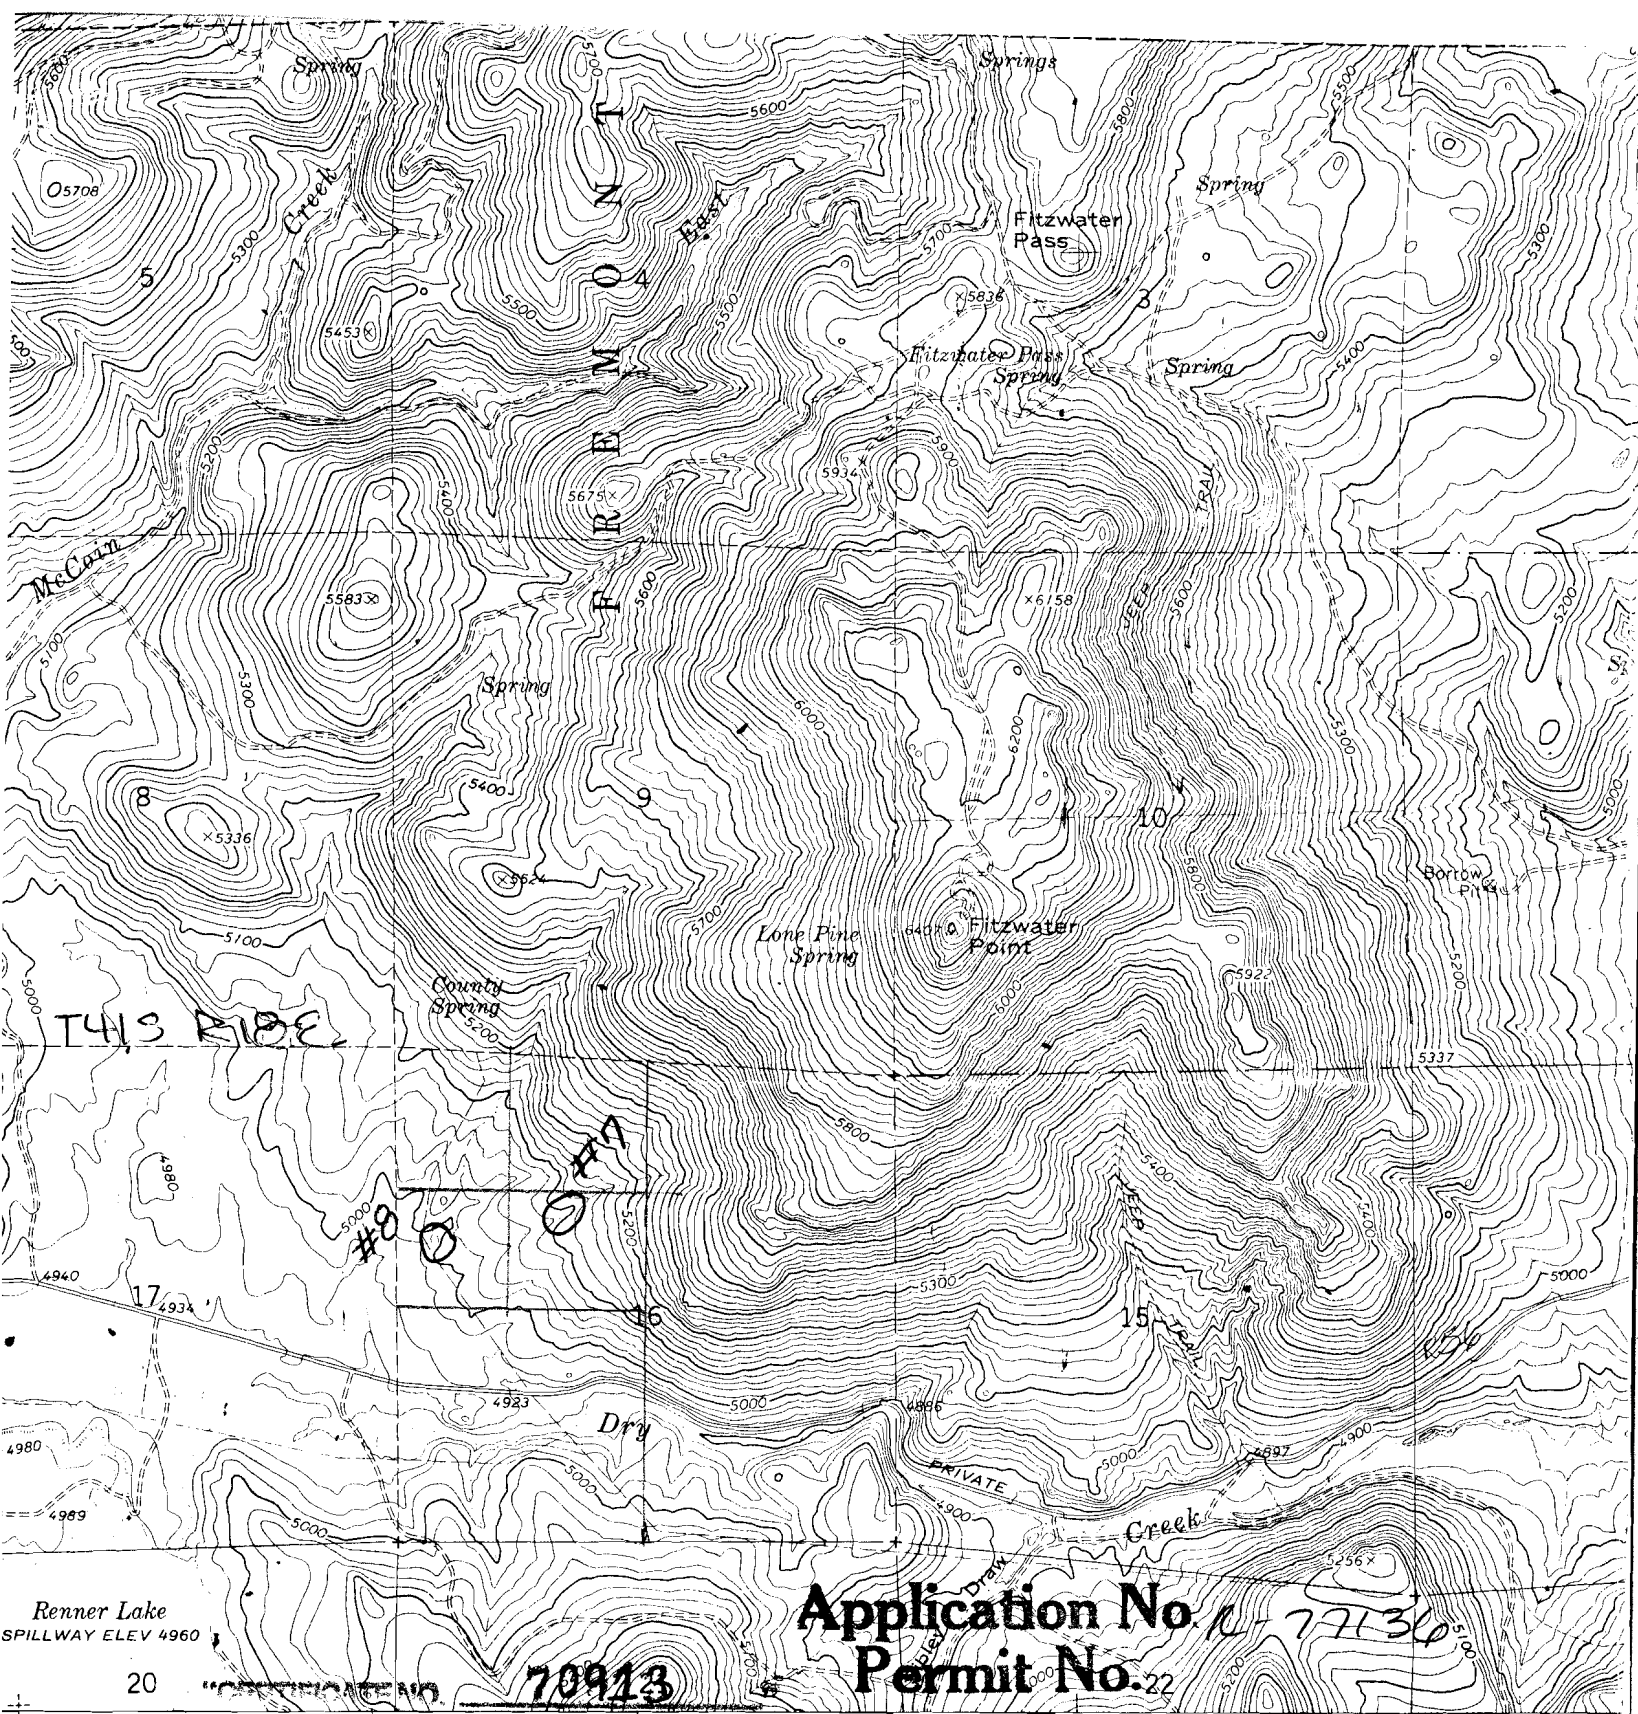

Renner Lake
SPILLWAY ELEV 4960

20

7°30" 697

Mapped, edited, and published by the Geological Survey
Control by USGS and NOS/NOAA

Topography by photogrammetric methods from aerial
photographs taken 1960 and 1962. Field checked 1964

Polyconic projection. 1927 North American datum
10,000-foot grid based on Oregon coordinate system,
south zone

1000-meter Universal Transverse Mercator grid ticks,
one 10, shown in blue

to place on the predicted North American Datum 1983
move the projection lines 18 meters north and


9 meters east as shown by dashed corner ticks

There may be private inholdings within the boundaries of
the National or State reservations shown on this map


70913

Application No. 77136
Permit No. 22

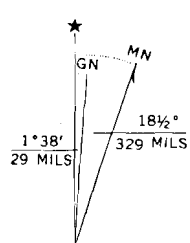

UTM GRID AND 1980 MAGNETIC NORTH
DECLINATION AT CENTER OF SHEET

RECEIVED

JAN - 4 1995

WATER RESOURCES DIV
SALEM, OREGON

CONTOUR INTERVAL
DOTTED LINES REPRESENT
NATIONAL GEODETIC VERTICES

THIS MAP COMPLIES WITH NATIONAL
FOR SALE BY U.S. GEOLOGICAL SURVEY, DENVER
A FOLDER DESCRIBING TOPOGRAPHIC MAPS