

This map was prepared for assessment purposes only


LAKE COUNTY

8 INDEX 4019

1" = 2000'

CANCELLED NO
500 7301
600 7302
2500
7300A1

SCALE 1:40000
RECEIVED
JAN - 4 1995
WATER RESOURCES DISTRICT
SHEM, OREGON

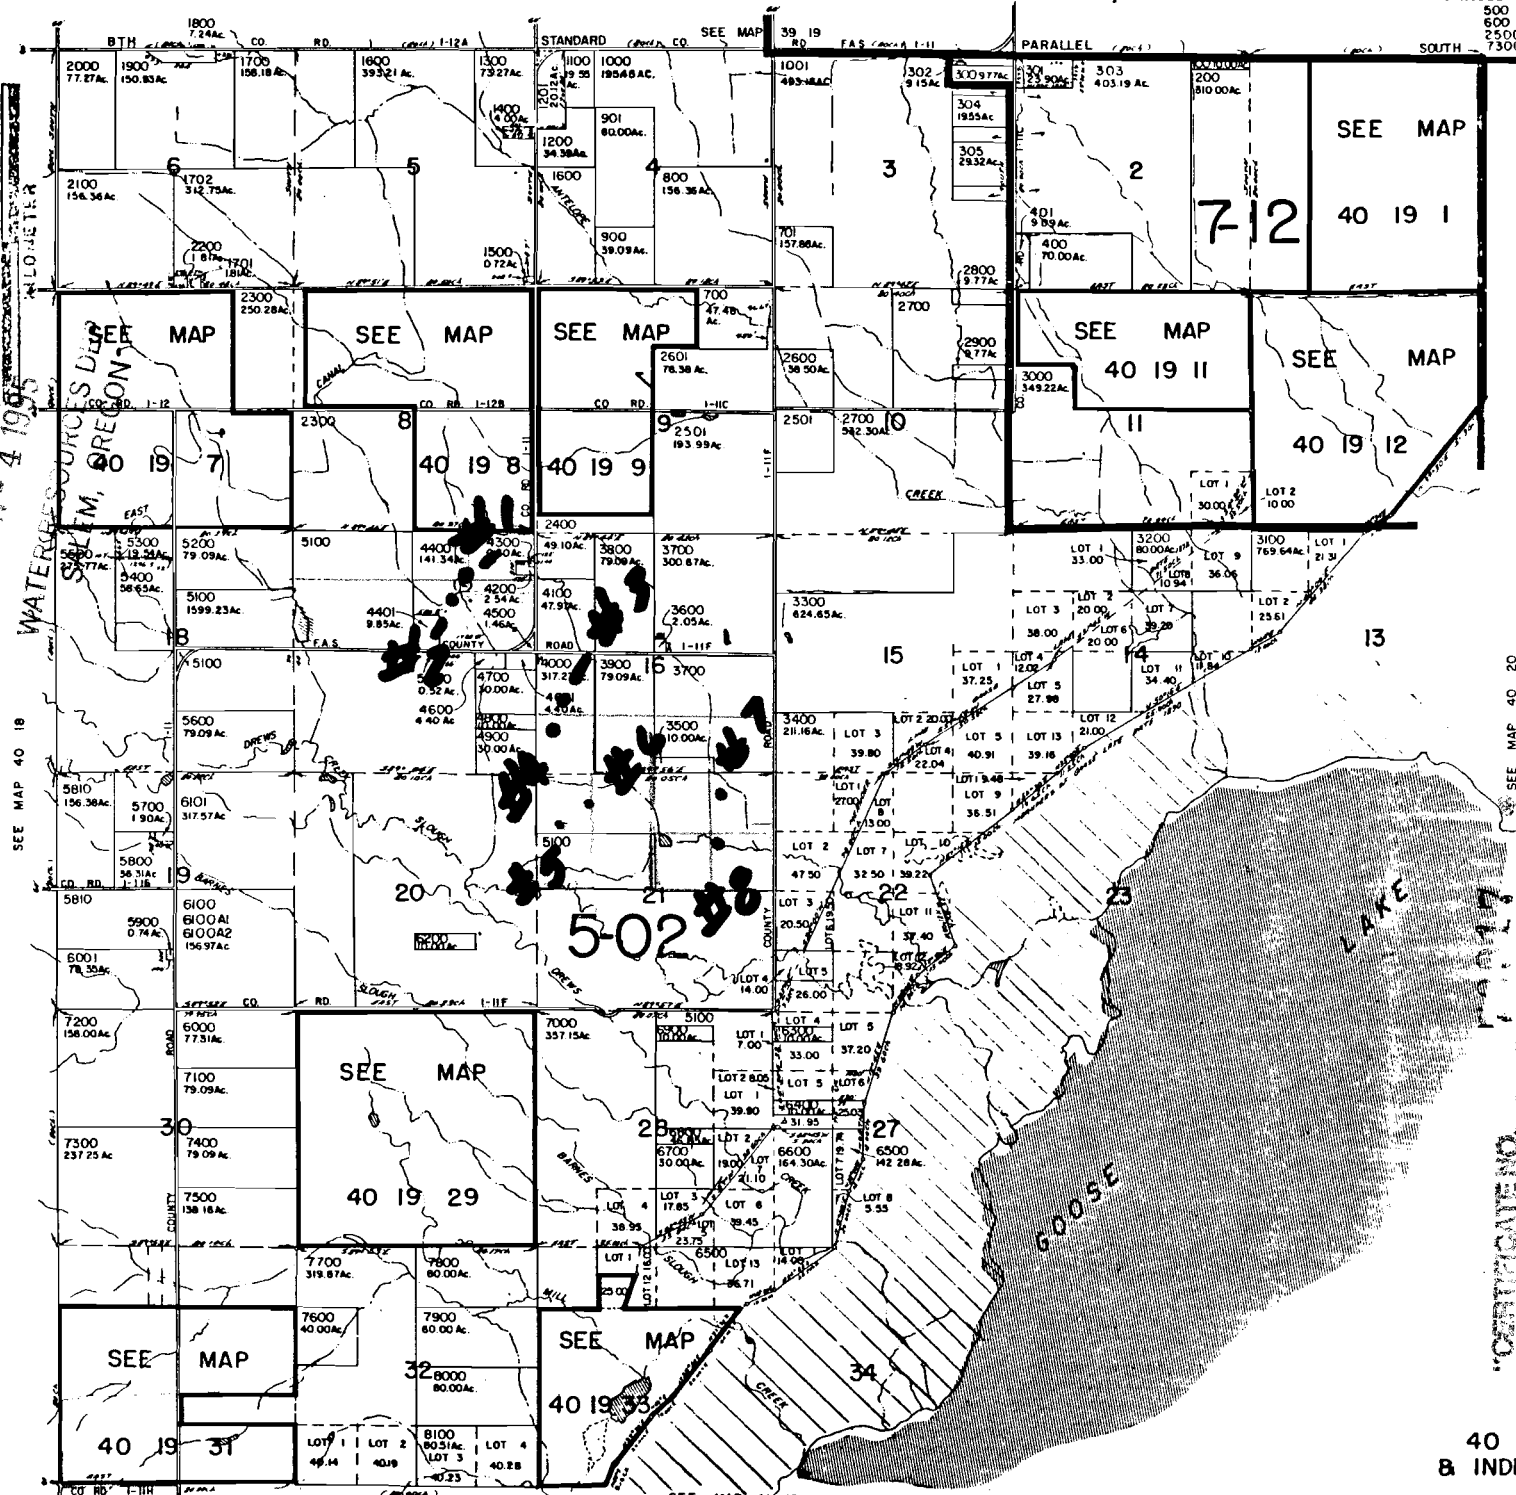

SEE MAP 40 19
SEE MAP 40 20

Application No. R-27148
Permit No.

40 19
& INDEX

No Final Proof Map available

No Permit Map available