

RECEIVED

JAN - 5 1995

WATER RESOURCES

This map was prepared for assessment purpose only



LAKE COUNTY

1" = 2000'

8 & INDEX 4019

CANCELLED NO
500 7301
600 7302
2500
7300A1

SCALE 1:40000

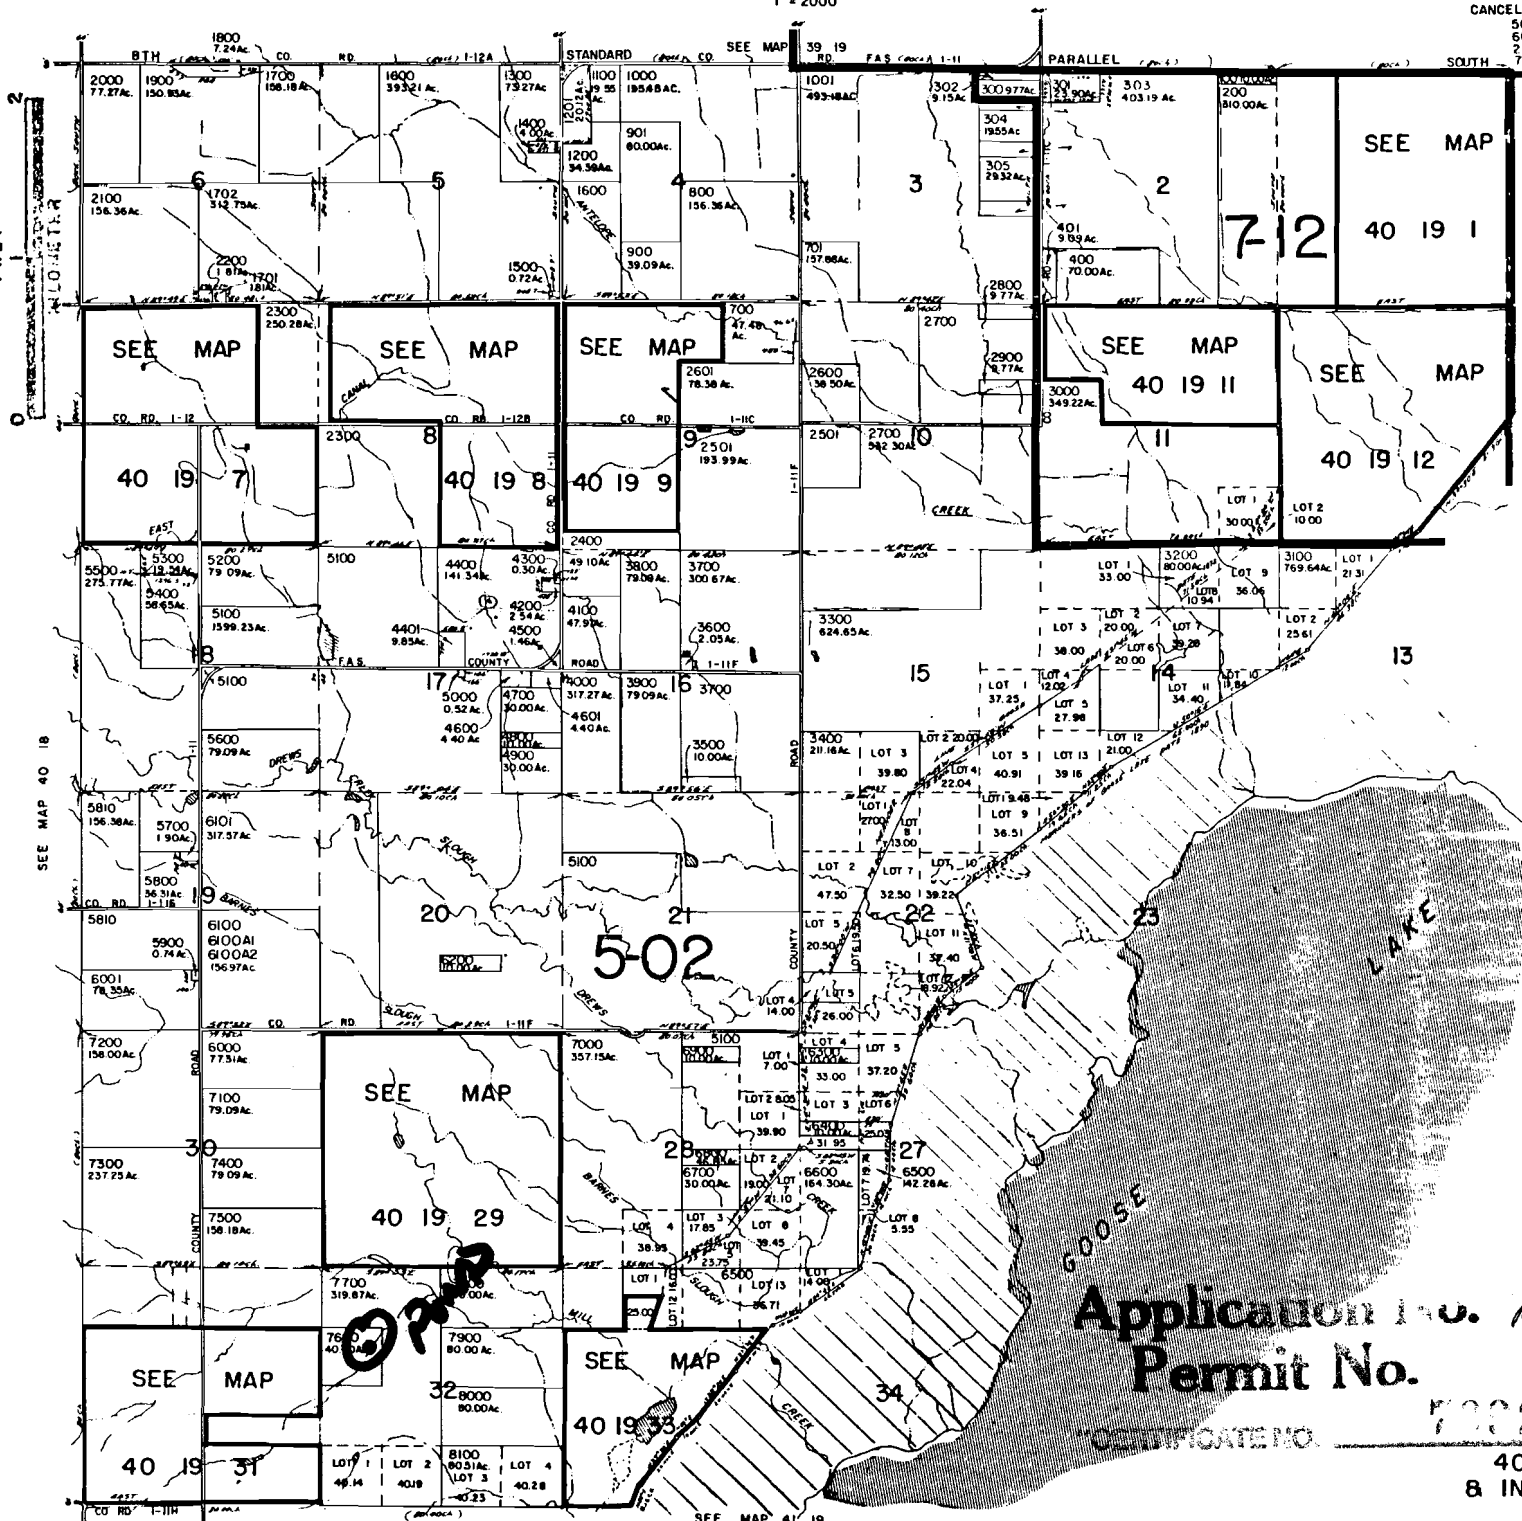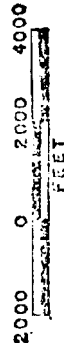

Application No. R-77143
Permit No.

73020

40 19
& INDEX

No Final Proof Map available

No Permit Map available