


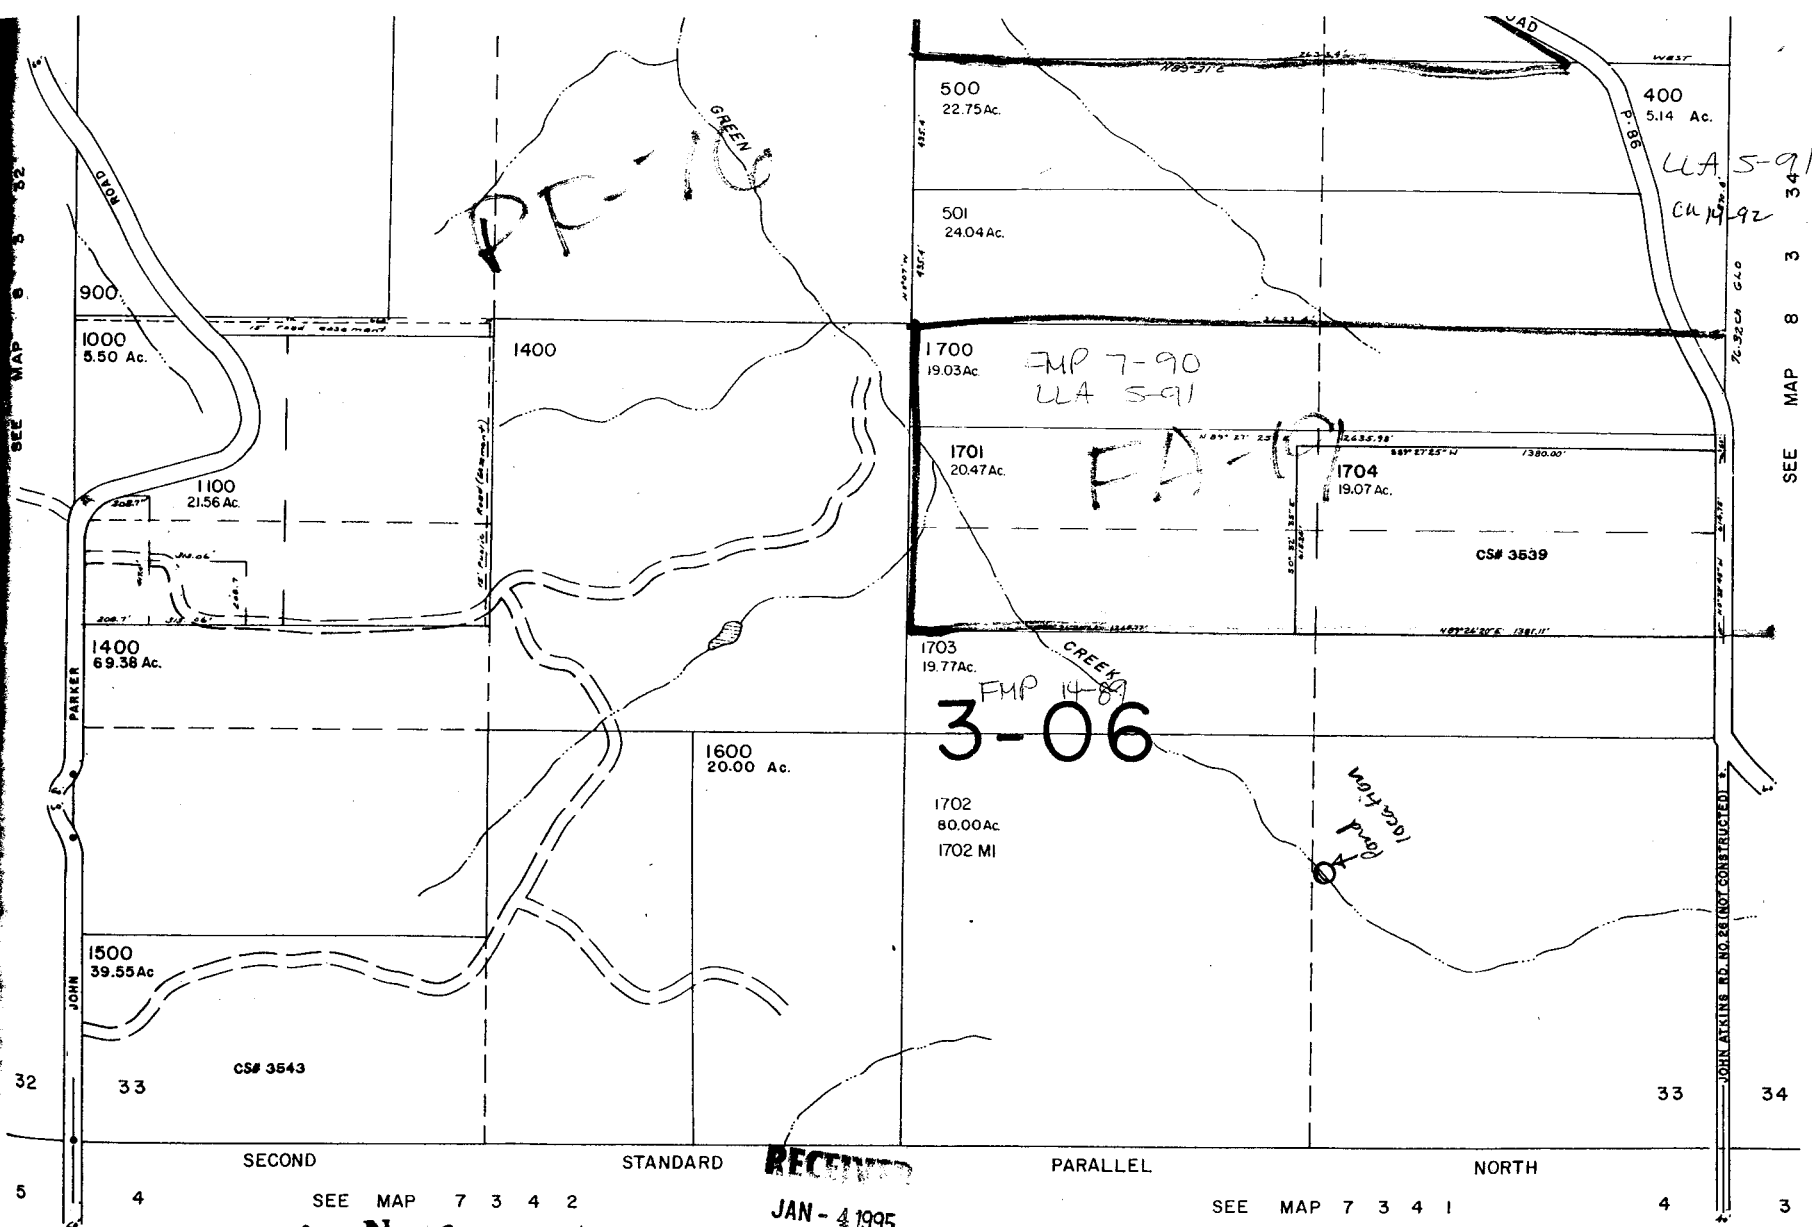

LA 5-91
CH 1492

FMP 7-90
LA 5-91

FA-10

FMP 14-80
3-06

location
road

RECEIVED
JAN 03 1995
WATERMASTER
HILLSBORO, OR

RECEIVED

JAN - 4 1995
WATER RESOURCES
SALEM, OREGON

CERTIFICATE NO. 70921

Application No R-77144
Permit No.

8 3 33