

HB 2153

R77137

Application No. R-77154 30805  
Permit No. ~~30805~~


T. 39S. R. 8W. W.M.

RECEIVED

JAN 31 1995

WATER RESOURCES DEPT.  
SALEM, OREGON

70931

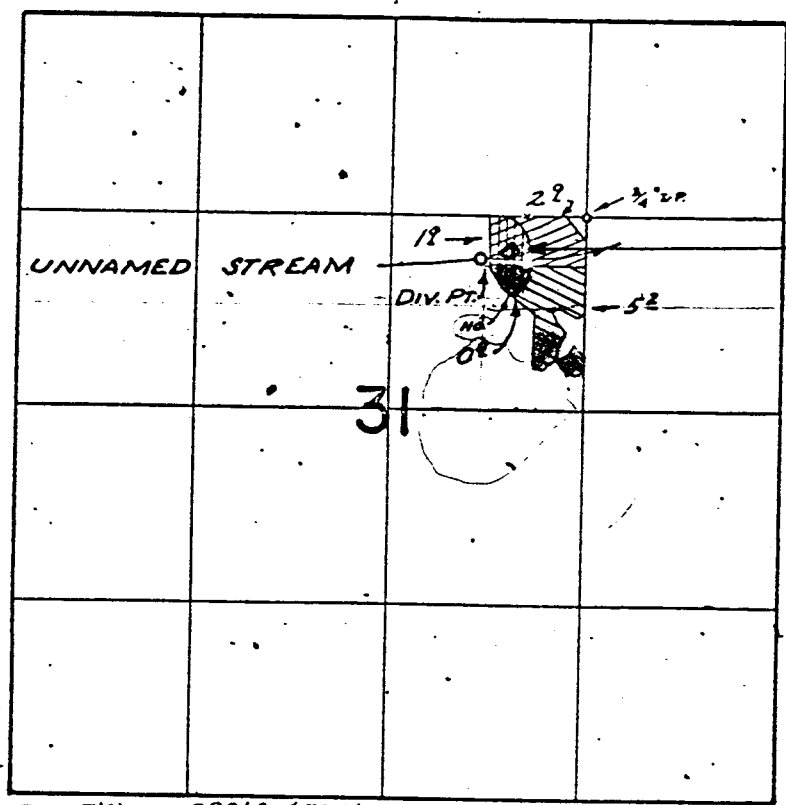

DIV. PT. LOC: 290'S. & 720'W. FROM NE. COR. SW 1/4 NE 1/4 SEC. 31

- APPL. 41186 - APPL. 42635 - SUPPLEMENTAL

= Remaining Right. See attached

FINAL PROOF SURVEY  
UNDER

Application No. 41186 42635 Permit No. 30805 31969 Cancelled  
IN NAME OF

AUBREY A. LOGAN

Surveyed JUNE 16, 1971, by G. BACA

DEC 1 1994