


No Final Proof Map available

No Permit Map available



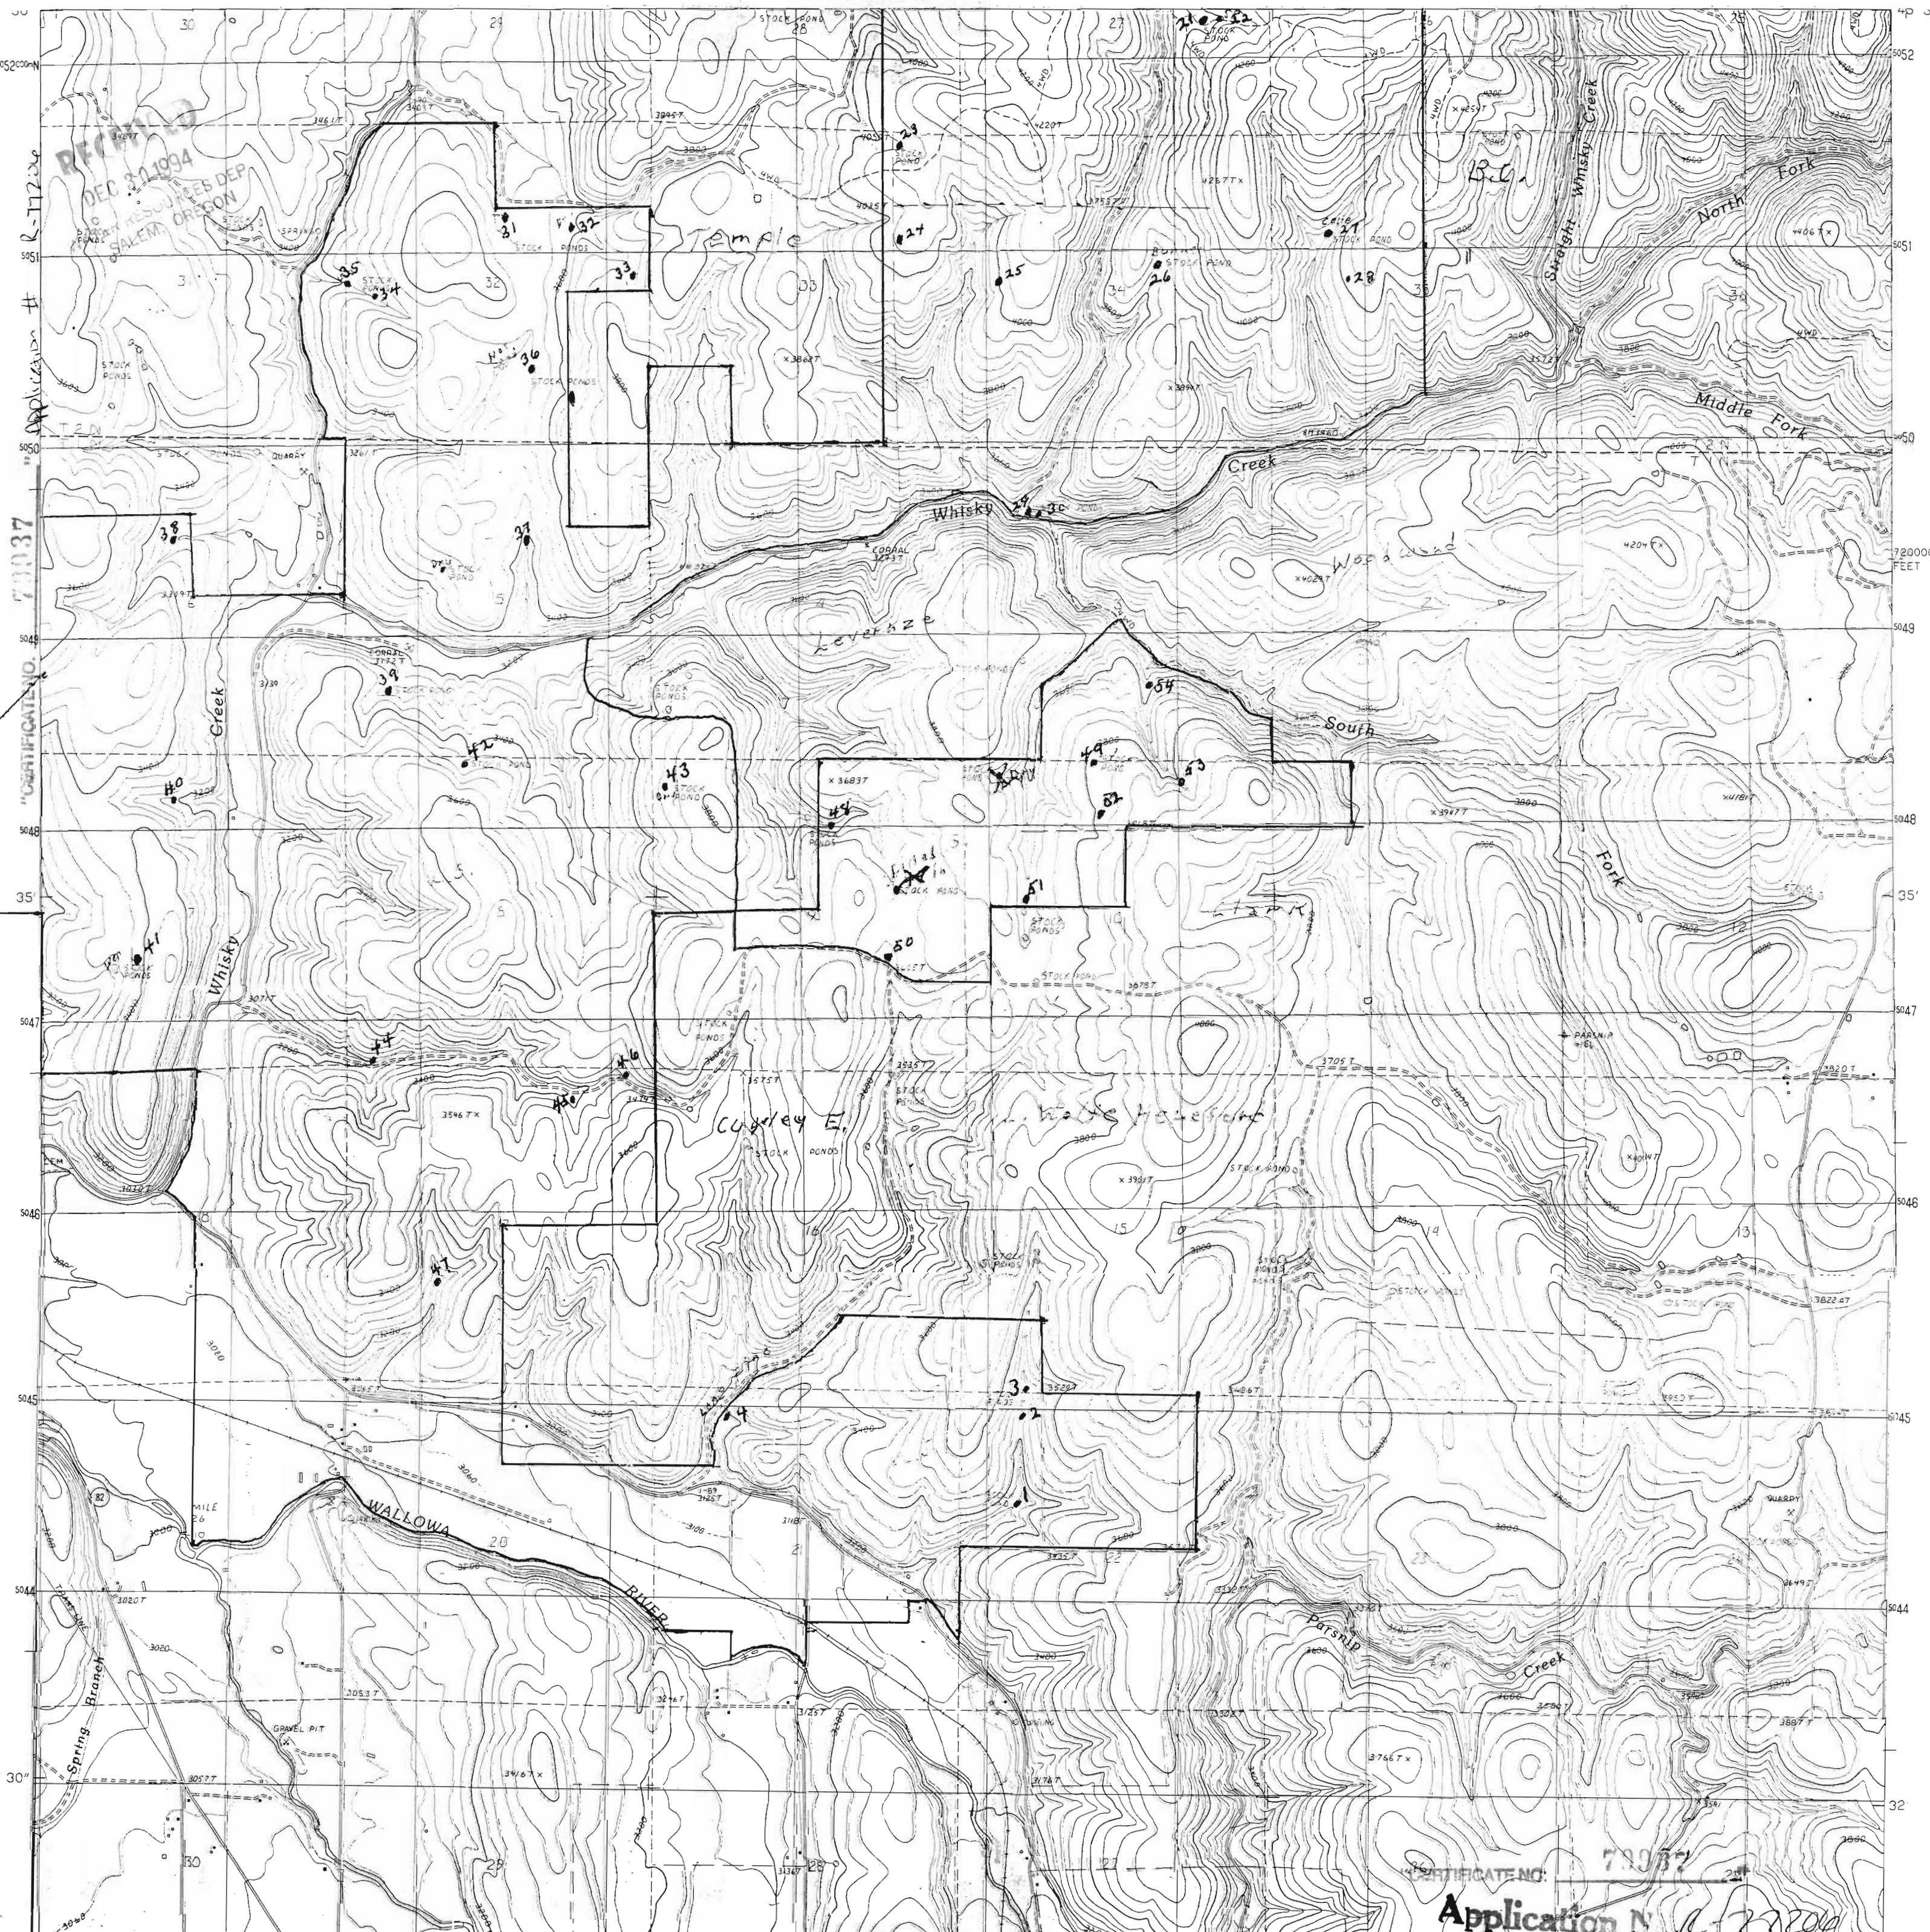



CERTIFICATE NO. 70037

Application # R-77204

CERTIFICATE NO. 70037

Application # R-77204