

Application No R-77208
Permit No.

CERTIFICATE NO. 52030


RECEIVED

DEC 8 0 1994

WATER RESOURCES DIVISION
SALEM, OREGON

Menchum

27

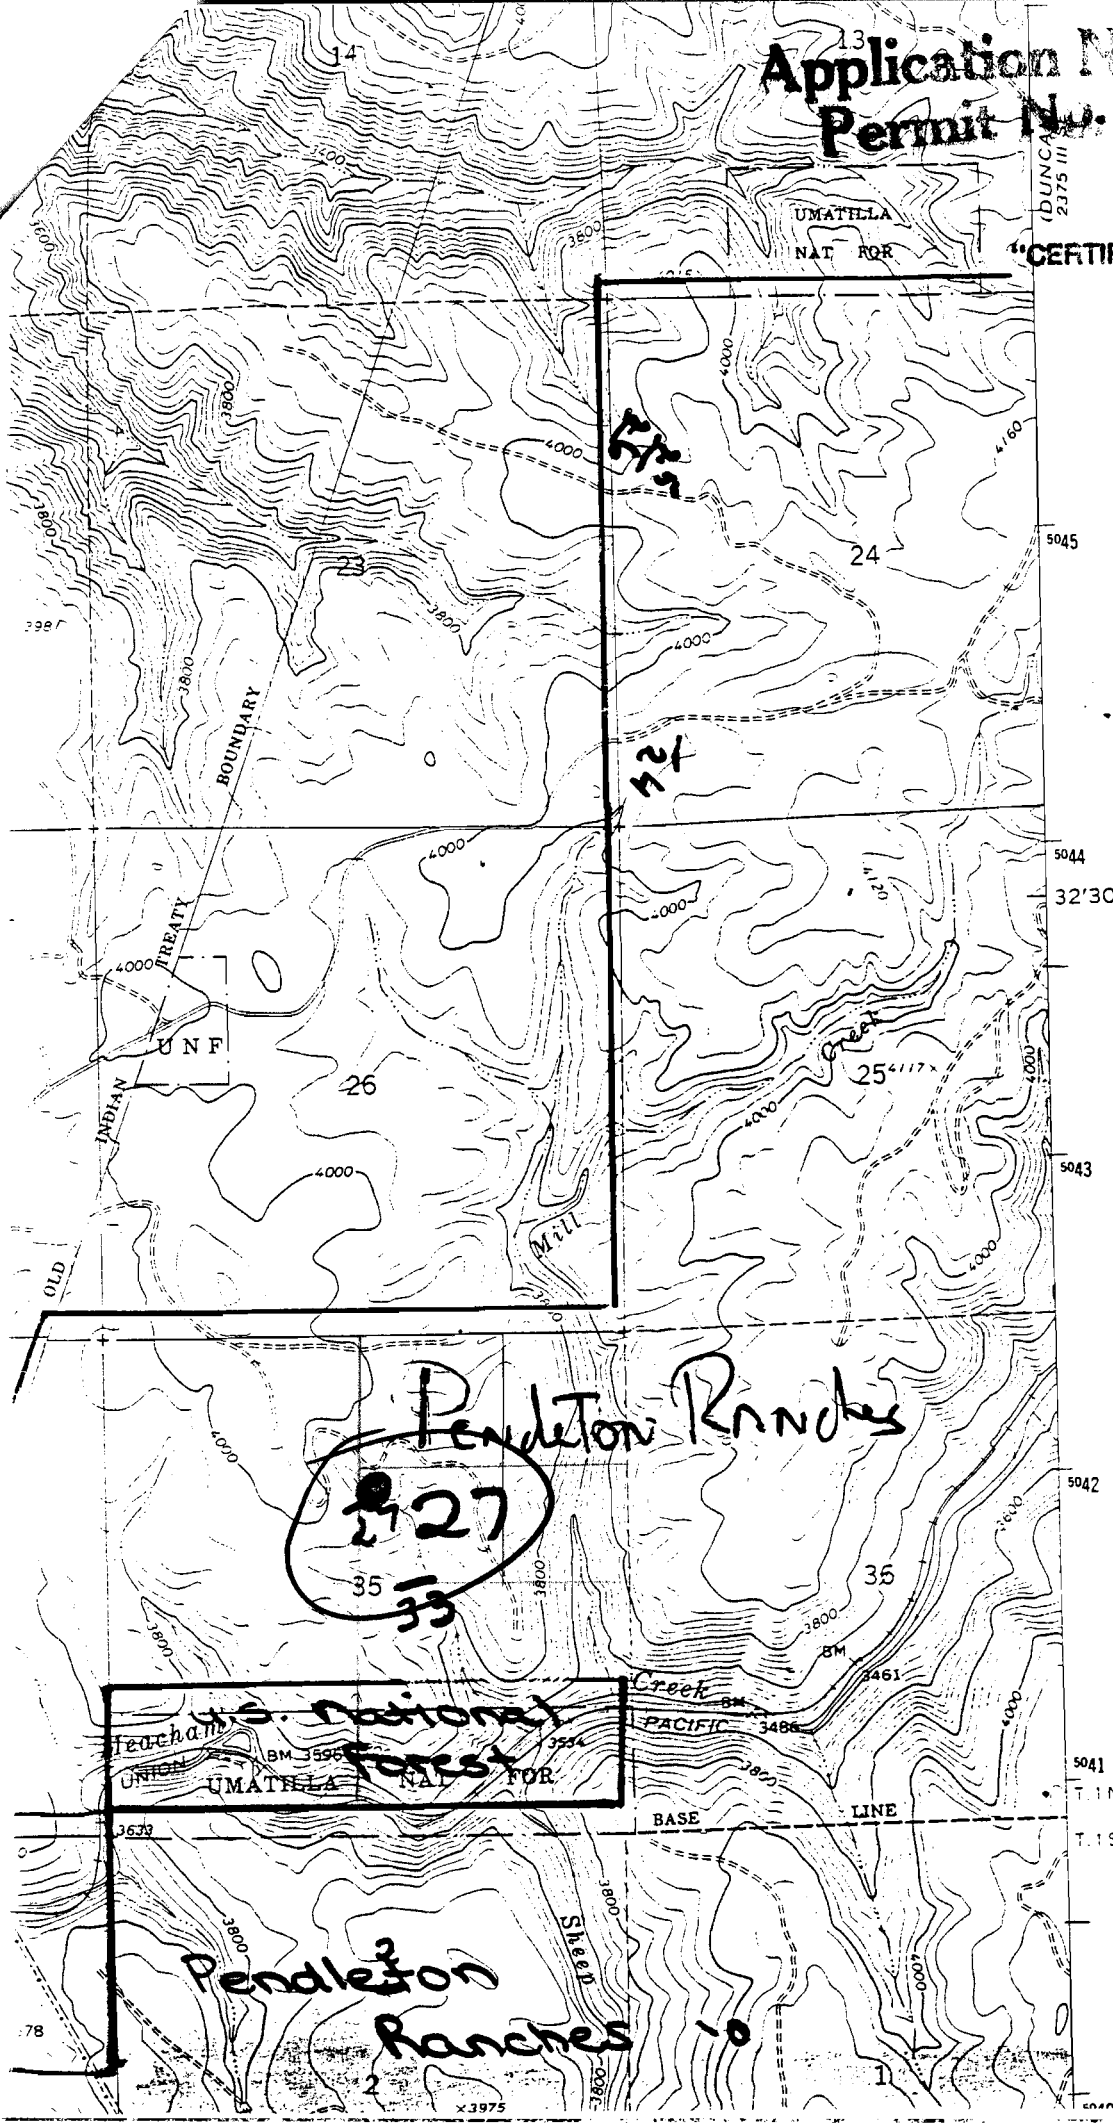

Application No. R-77208
Permit No.

RECEIVED

DEC 30 1994

WATER RESOURCES DEPT.
SALEM, OREGON

W.H. "CERTIFICATE NO."

W.H.

70939

AIR STRIP TANKWELL

McCUTCHEON
#1

20 29
25 30

Beckner West

Beckner EAST

PENDLETON RANCHES

30 29
31 32

W.T. well

Beckner West
Application No. 8-77208
Permit No.

"CERTIFICATE NO. 70939"

PENDLETON RANCHES

Beckner EAST

Hoke Ranches
Fix (West)

Beckner EAST

30
31

W. J. Hall

-R30E

RECEIVED
DEC 9 0 1994
WATER RESOURCES DEPT.
SALEM, OREGON

MINNICHAM SHEEP CO.

DUMP
SOUTH

Application No. R-77208
Permit No.

"CERTIFICATE NO. 73239"

RECEIVED

DEC 30 1994

WATER RESOURCES DEPT.
SALEM, OREGON

← Rosenberg
EAST #1

PENDLETON RANCHES, INC.

ROSENBERG
EAST

MINNICHAM SHEEP CO.

ROSENBERG
WEST

MOORE
RANCHES

No Final Proof Map available

No Permit Map available