

Application No. R-77211
Permit No.

"CERTIFICATE NO. _____"


10013

HURON

#10

T 1 S 15 R 11 W

T 2 S 25

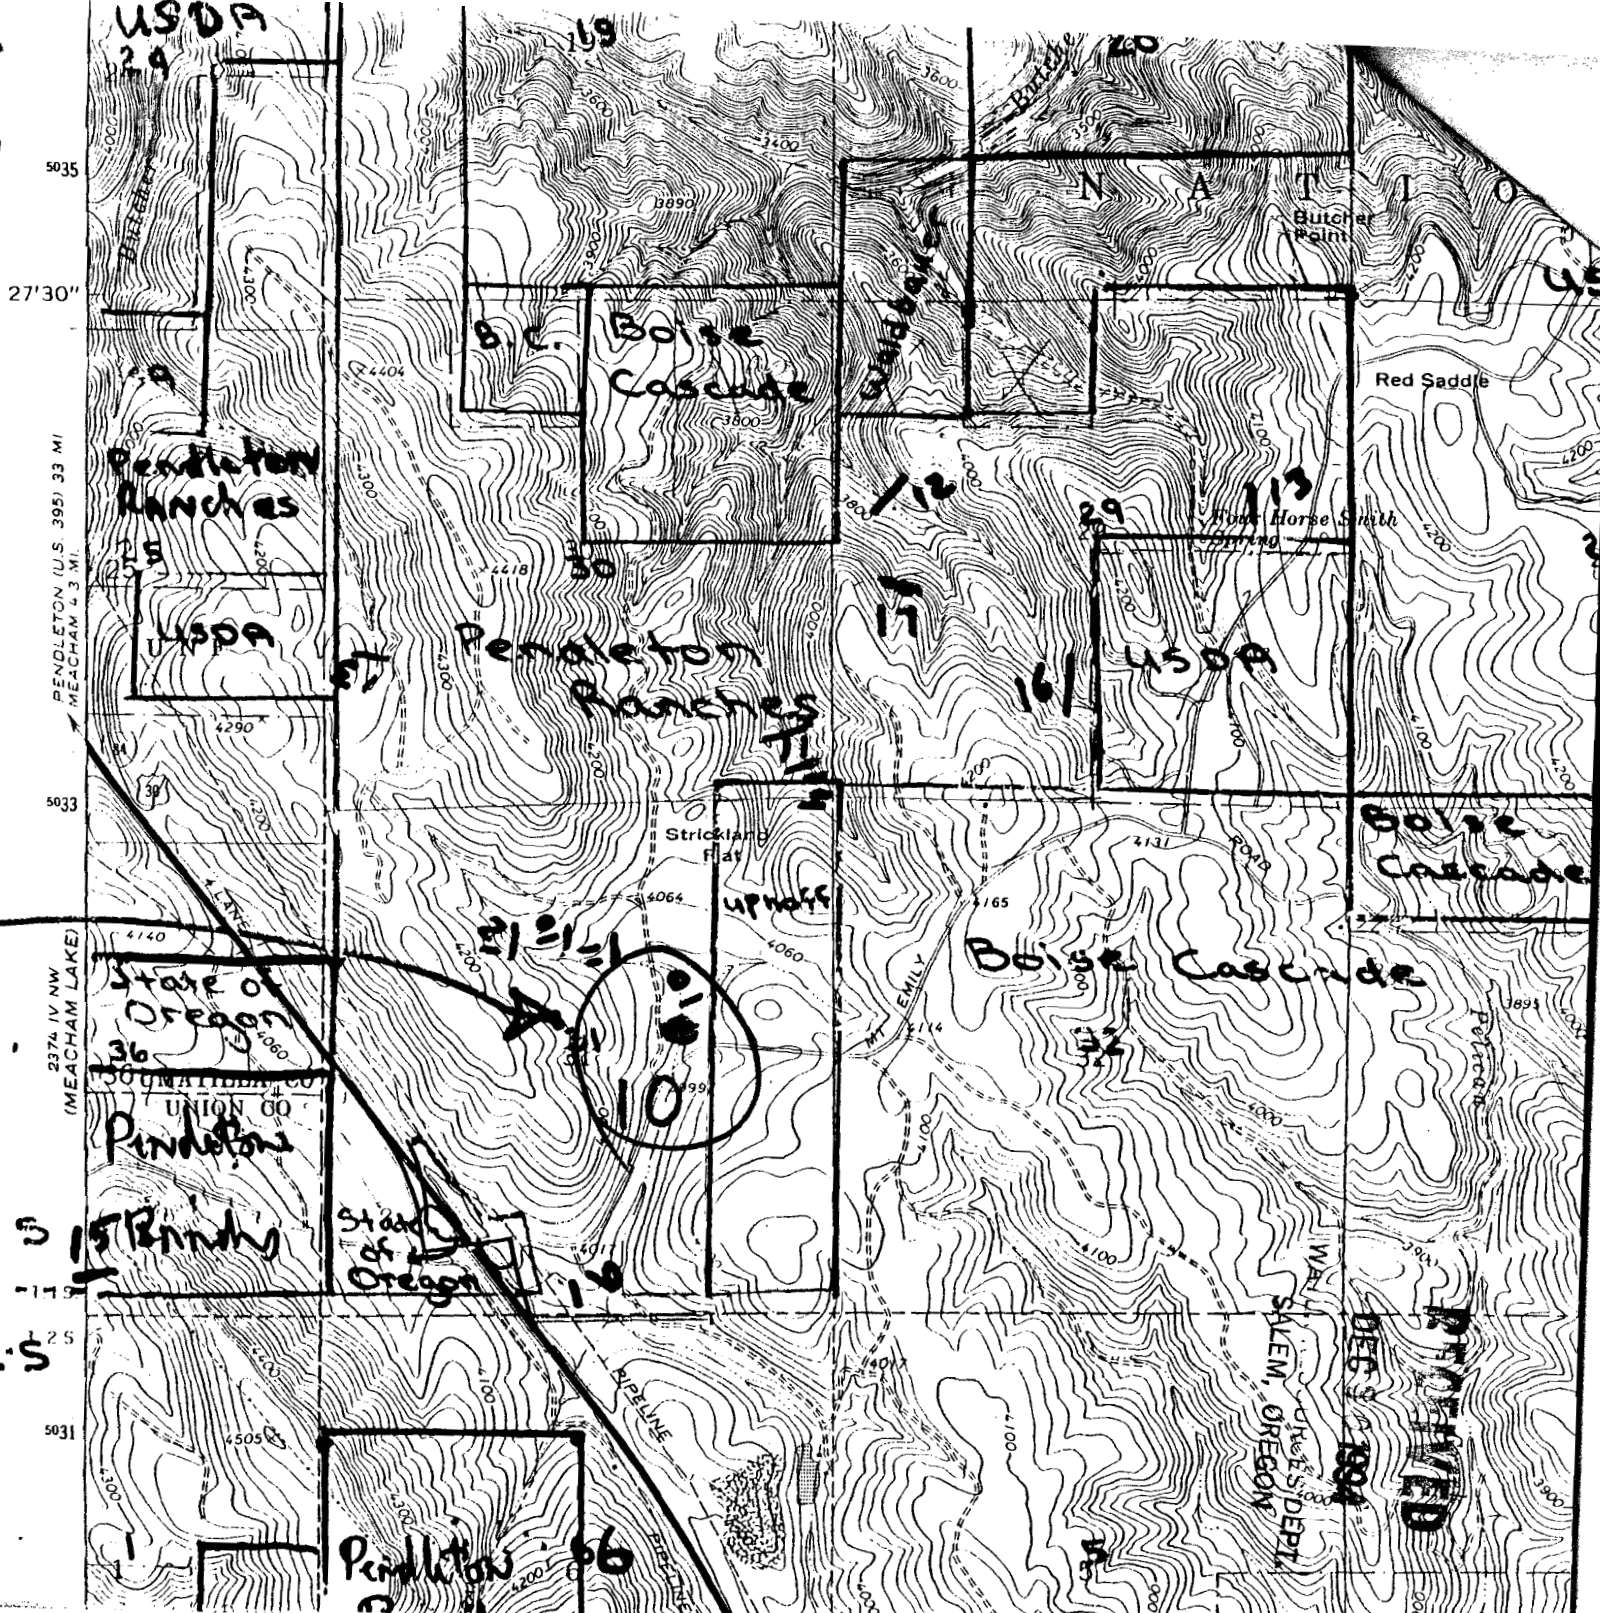

RECEIVED

DEC 1 1964

OREGON DEPT. OF LANDS
SALEM, OREGON

RECEIVED

DEC 30 1994

WATER RESOURCES DEPT.
SALEM, OREGON


CERTIFICATE NO.

FIG 12

Application No. R-77211
Permit No.

T 1 S
T 2 S

HURON
#11

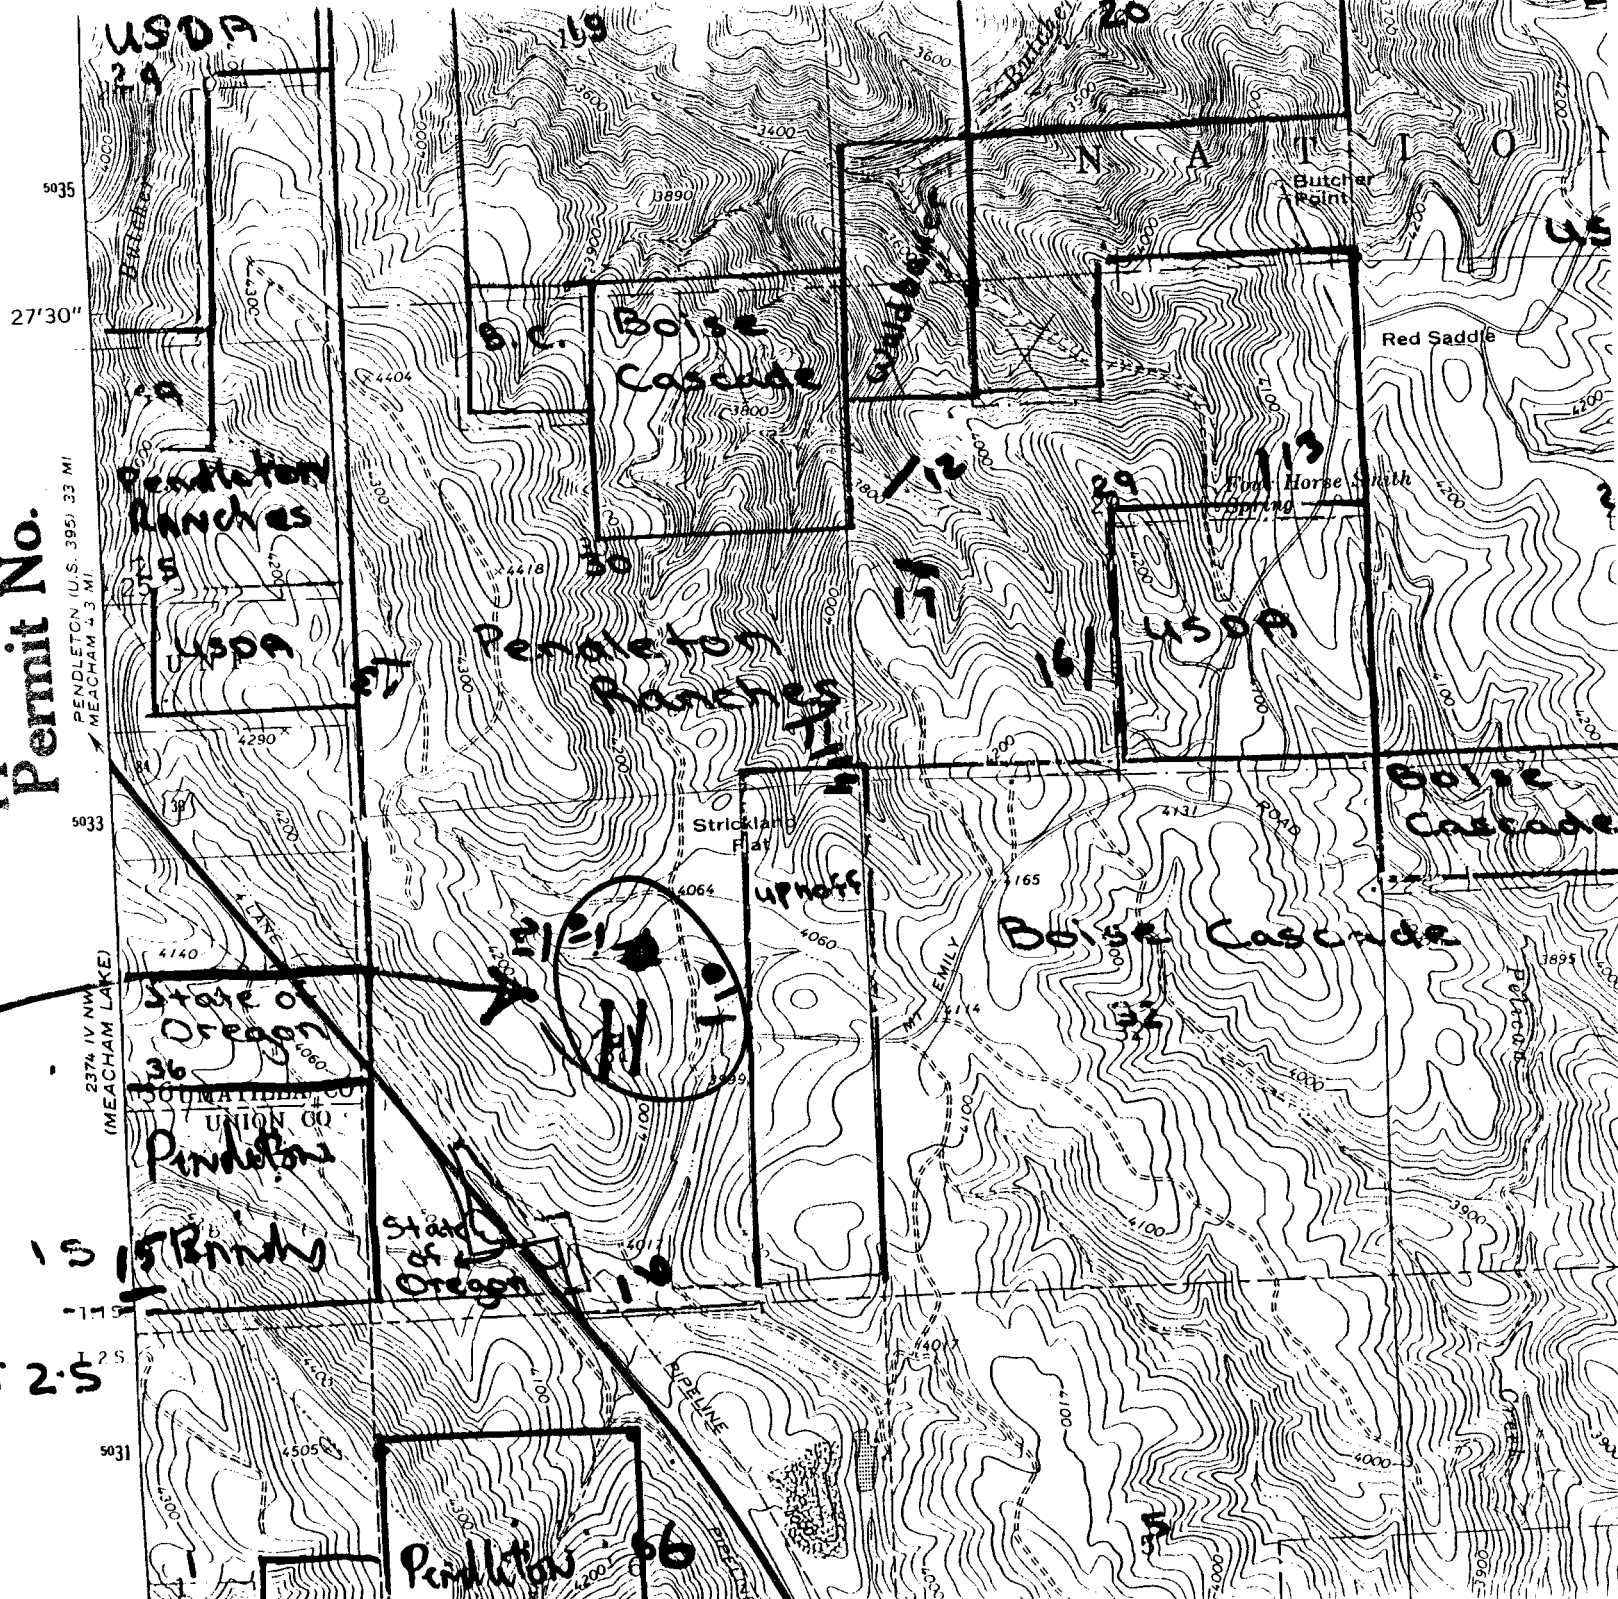

RECEIVED

DEC 30 1994

WATER RESOURCES DEPT.
SALEM, OREGON

12

Application No R-77211

Permit No.


PENDLETON (U.S. 395) 33 MI.
MEACHAM 43 MI.

Huron

#12

T 13

T 2 S

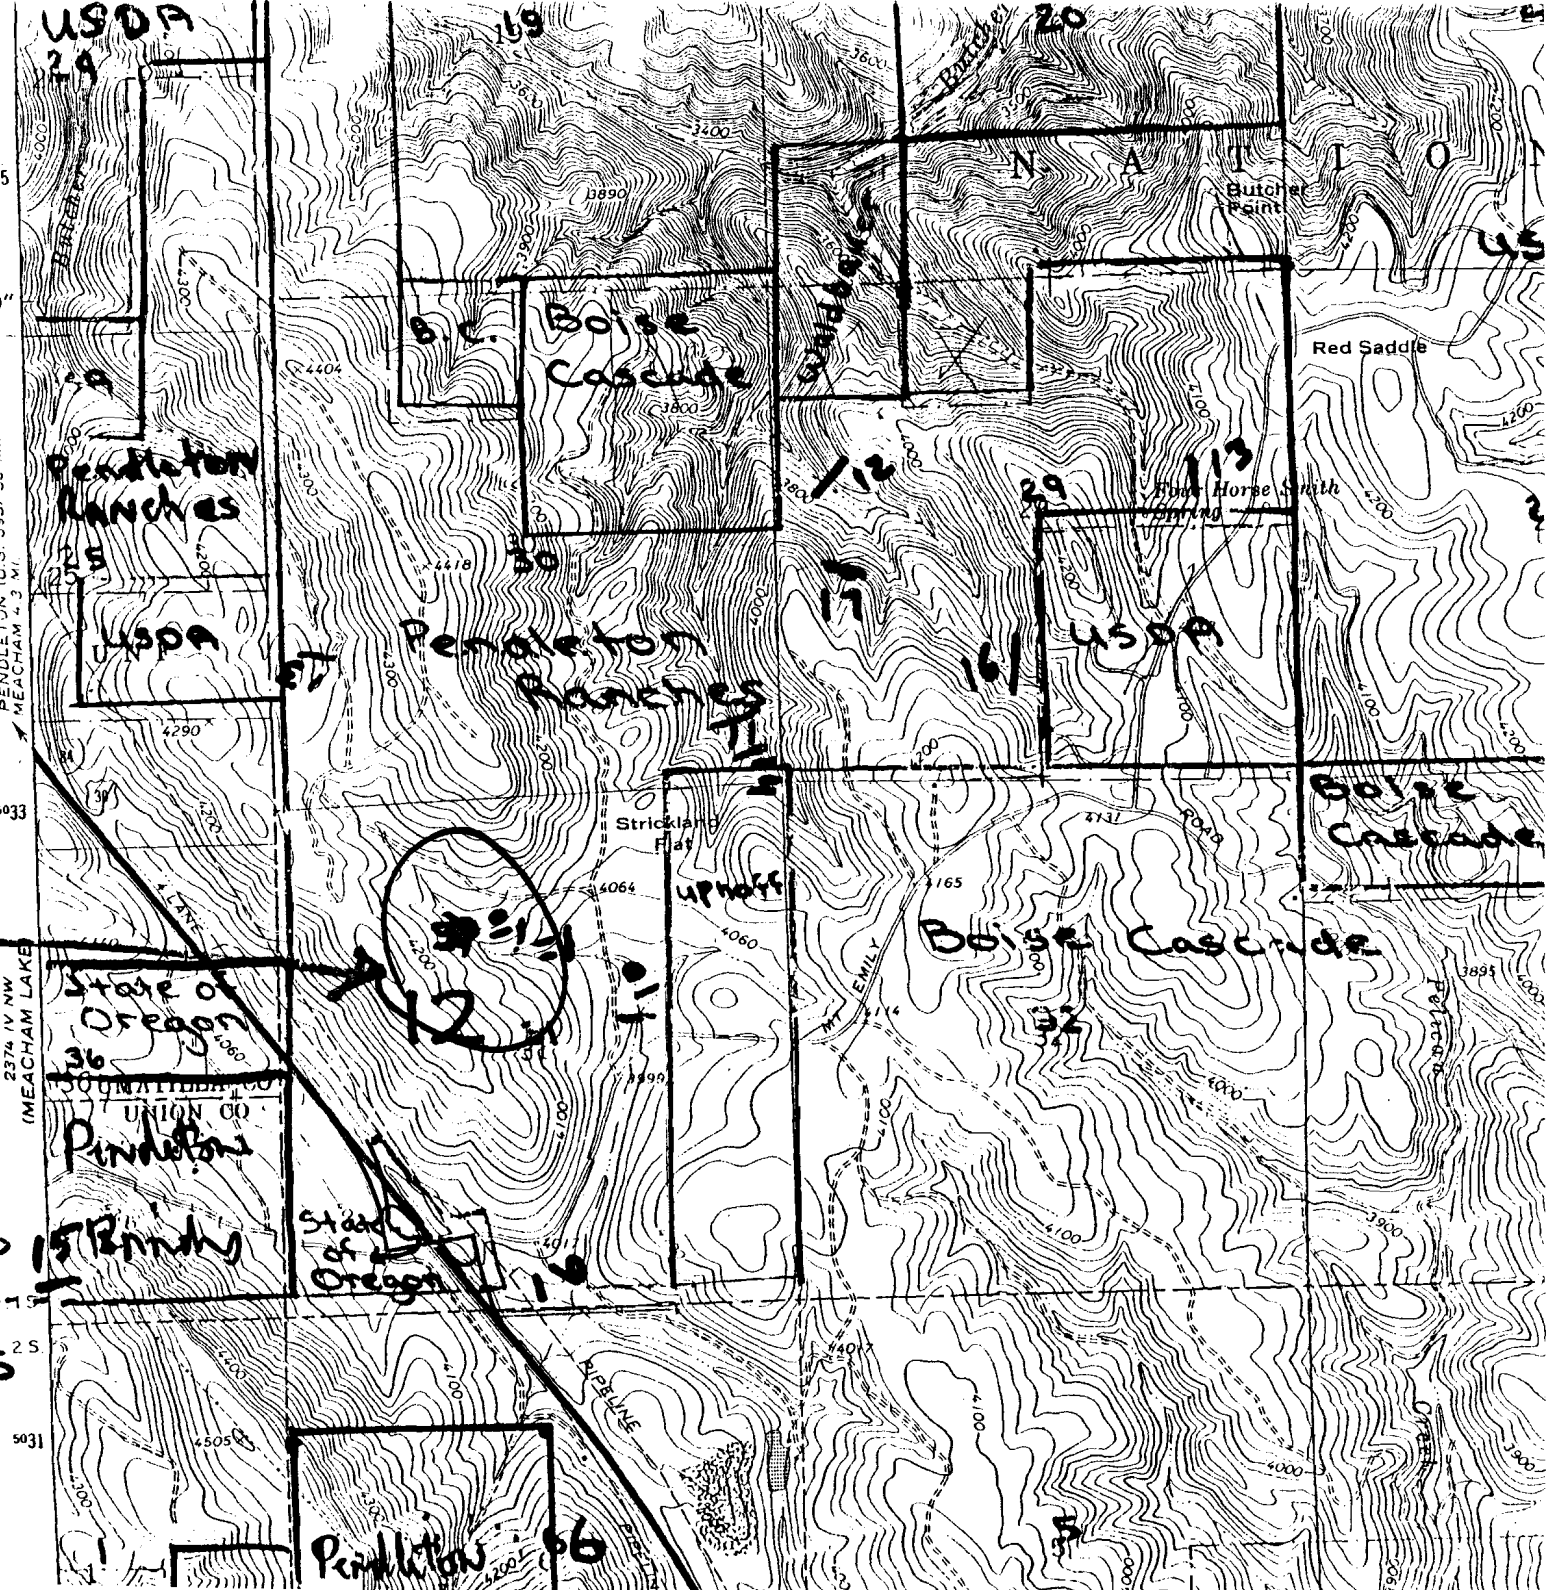

RECEIVED

DEC 30 1994

WATER RESOURCES DEPT.
SALEM, OREGON

WATER RESOURCES DEPT.
SALEM, OREGON

Application No. R-77211
Permit No.


PERMIT NO.

2374 IV NW
(MEACHAM LAKE)

State of Oregon
Union Co

State of Oregon

Permit No. 66

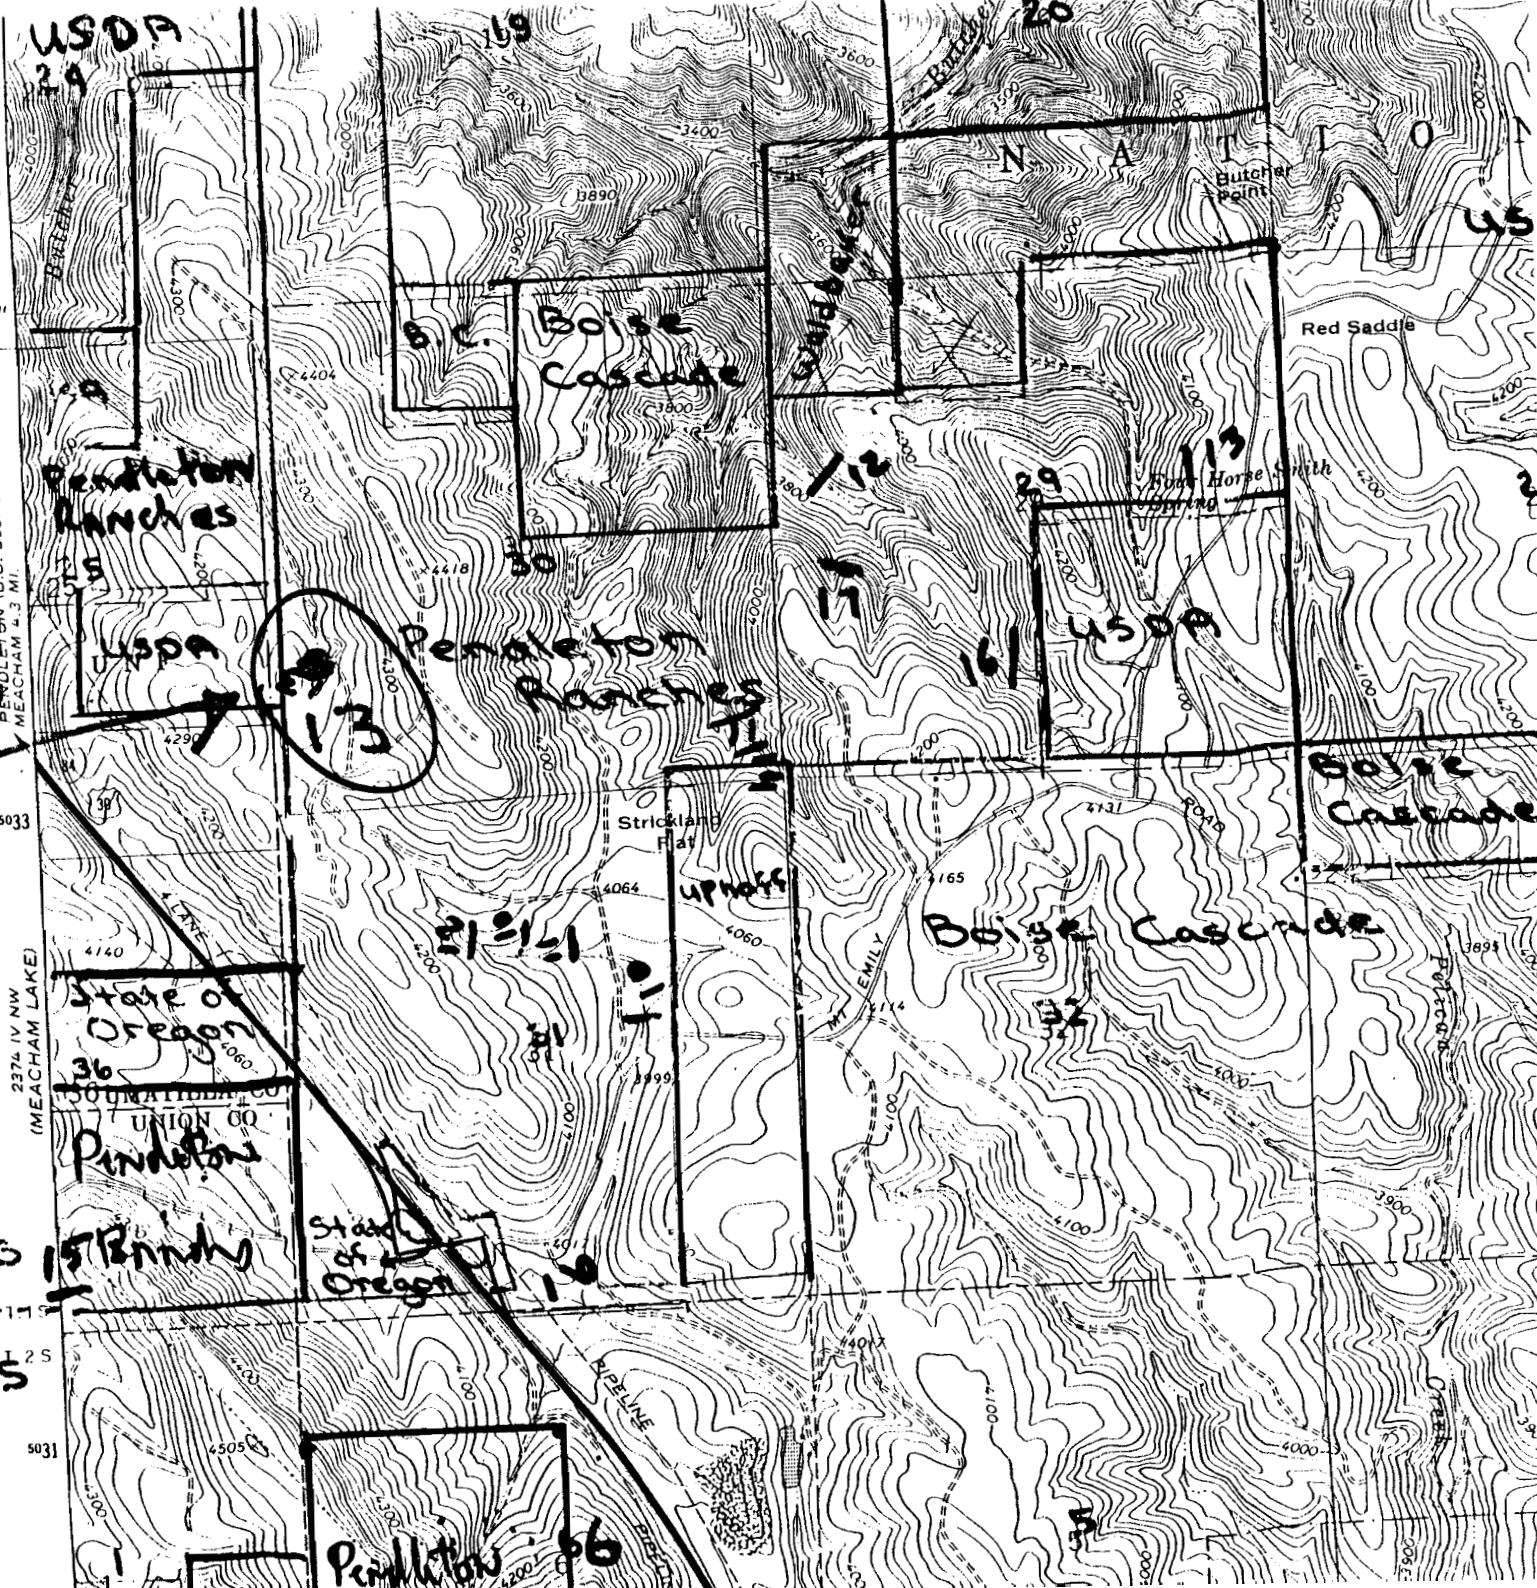

DEC 30 1994


WATER RESOURCES DEPT.
SALEM, OREGON

HURON
#11

#14

Application No. 12-77211
Permit No. _____

T 15
T 25

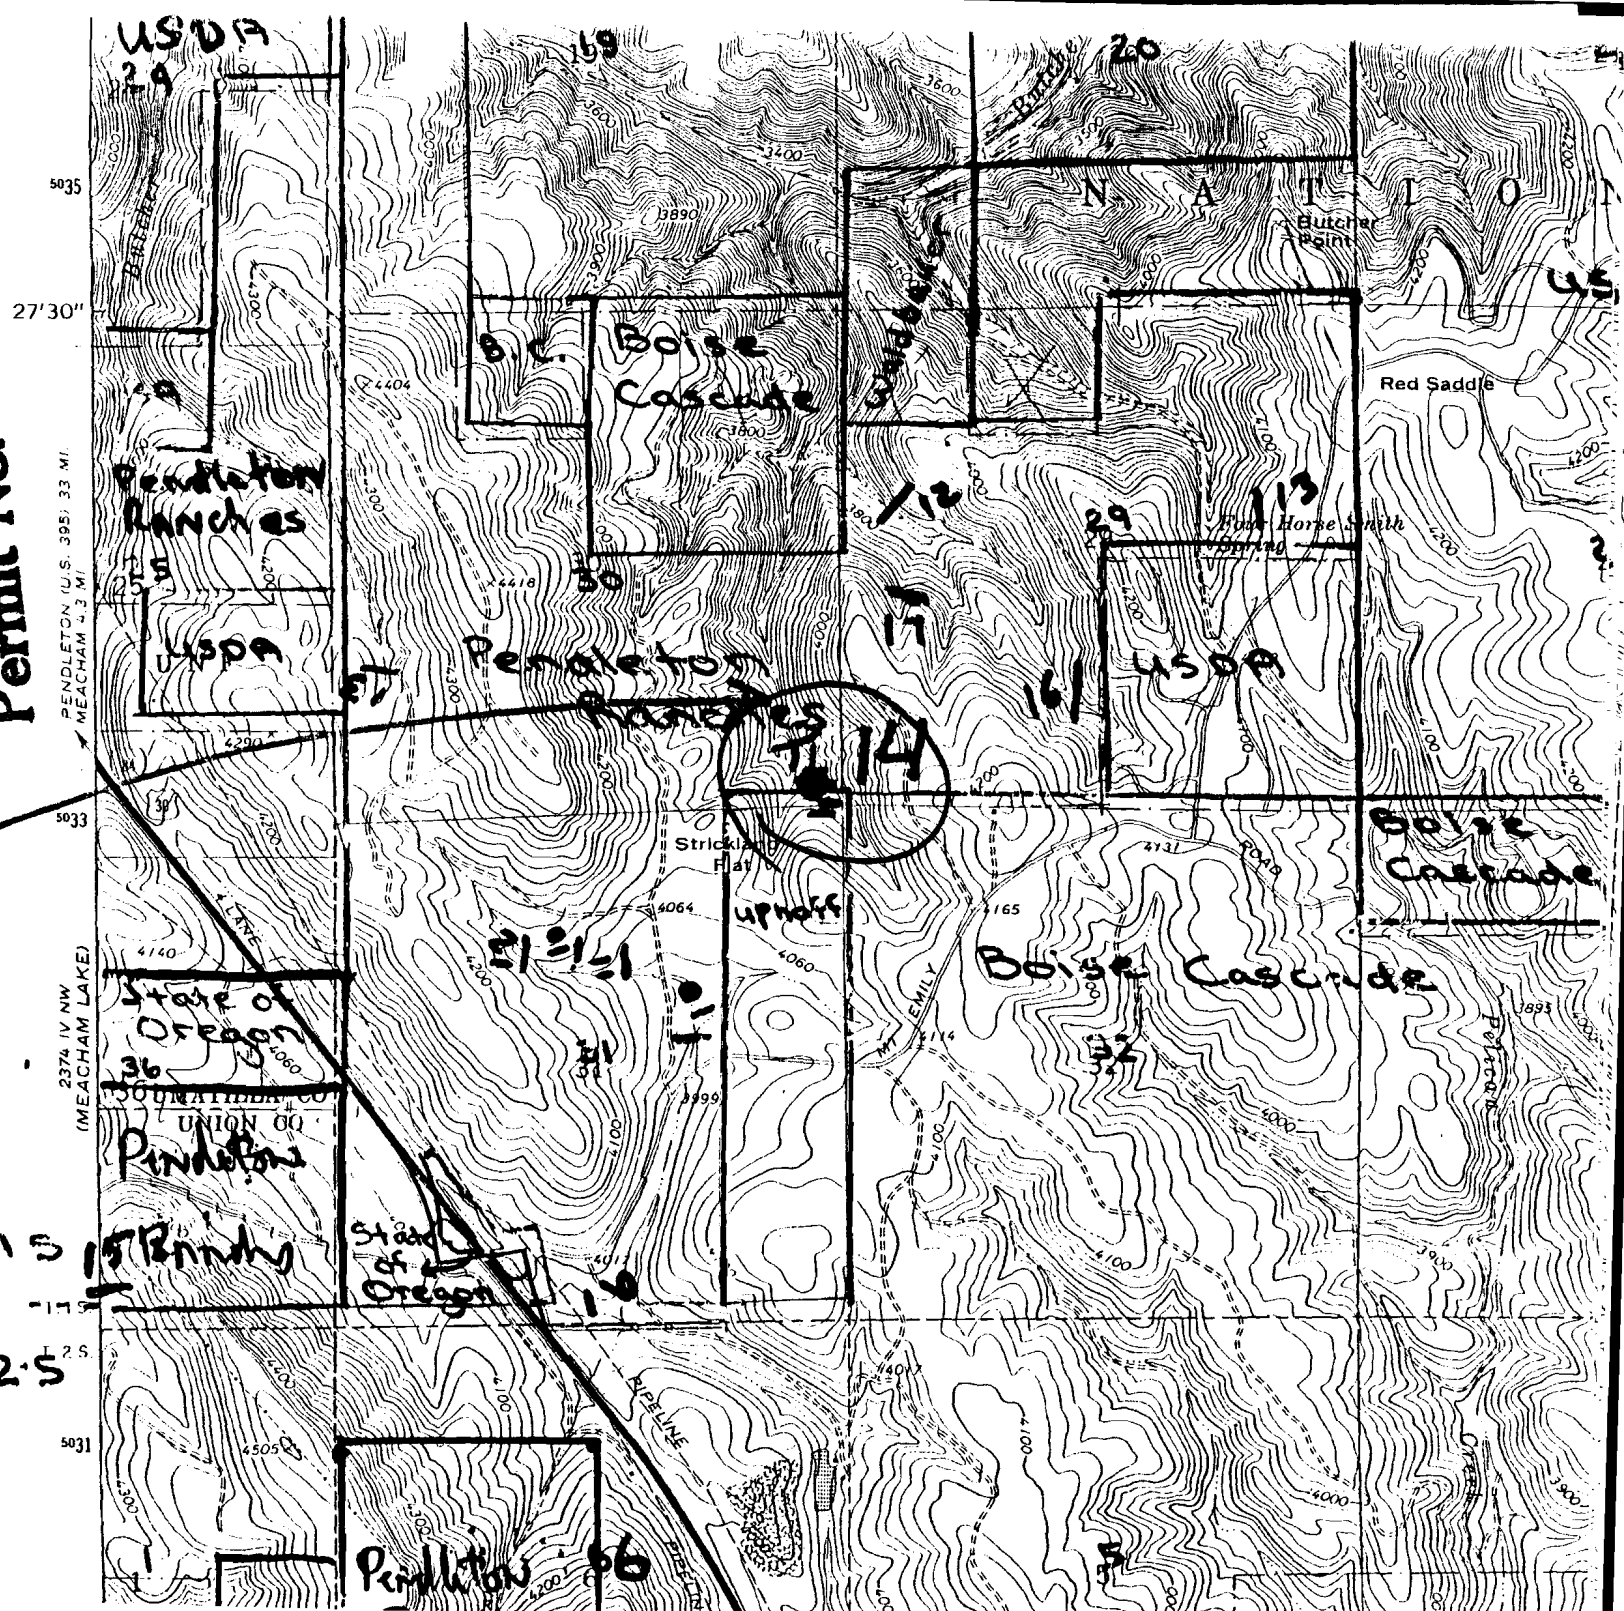

RECEIVED


DEC 30 1994

WATER RESOURCES DEPT.
SALEM, OREGON

Application No. R-77211
Permit No.

"CERTIFICATE NO. 10010"

T 1 S
T 2 S

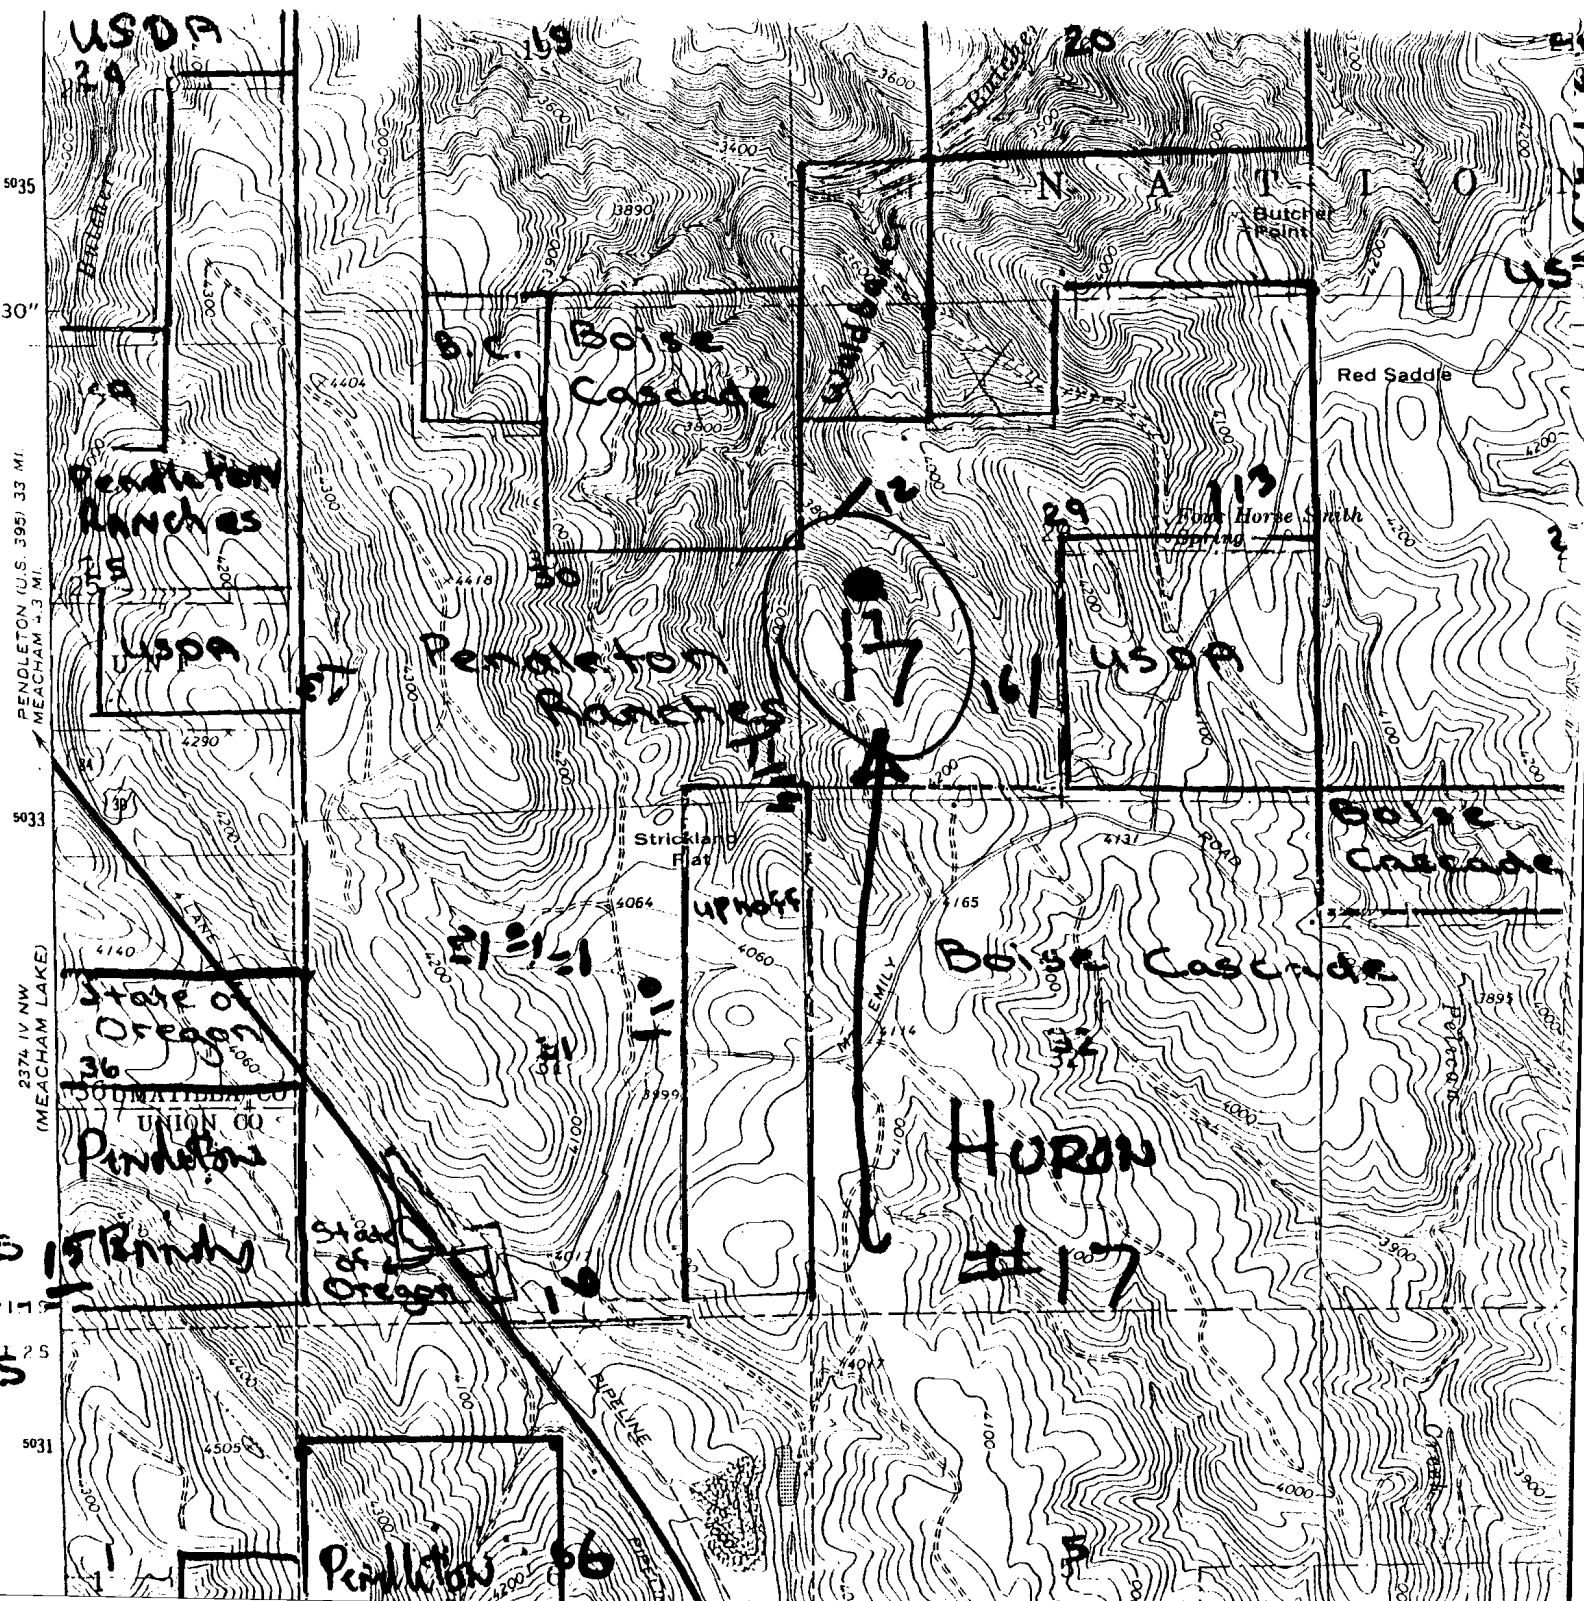

DEC 30 1994

2

CERTIFICATE NO.


#18

LAKES

Meachem

Application J Permit No.

Application No K-77211

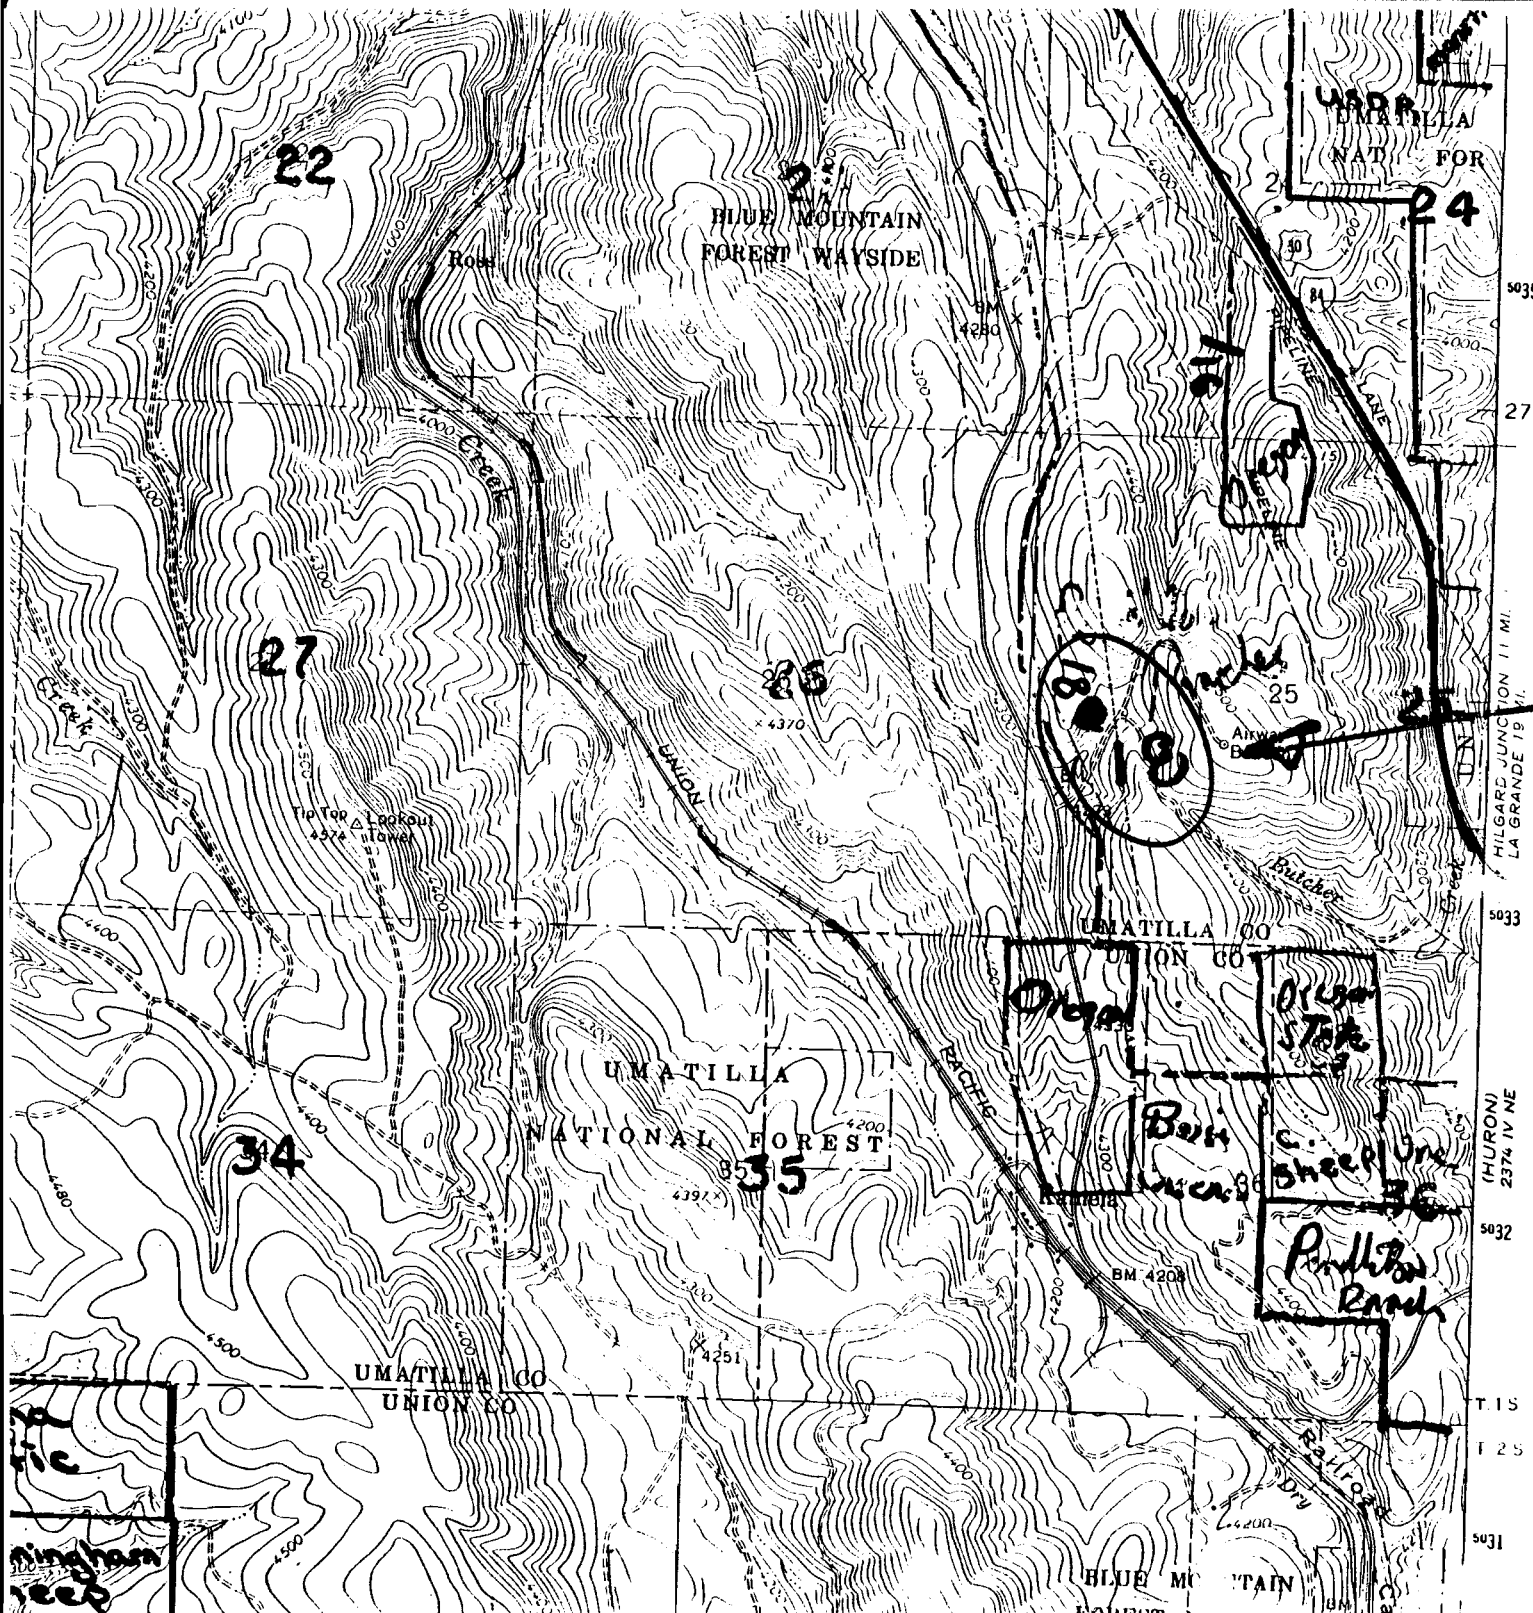

No Final Proof Map available

No Permit Map available