




640 000
FEET

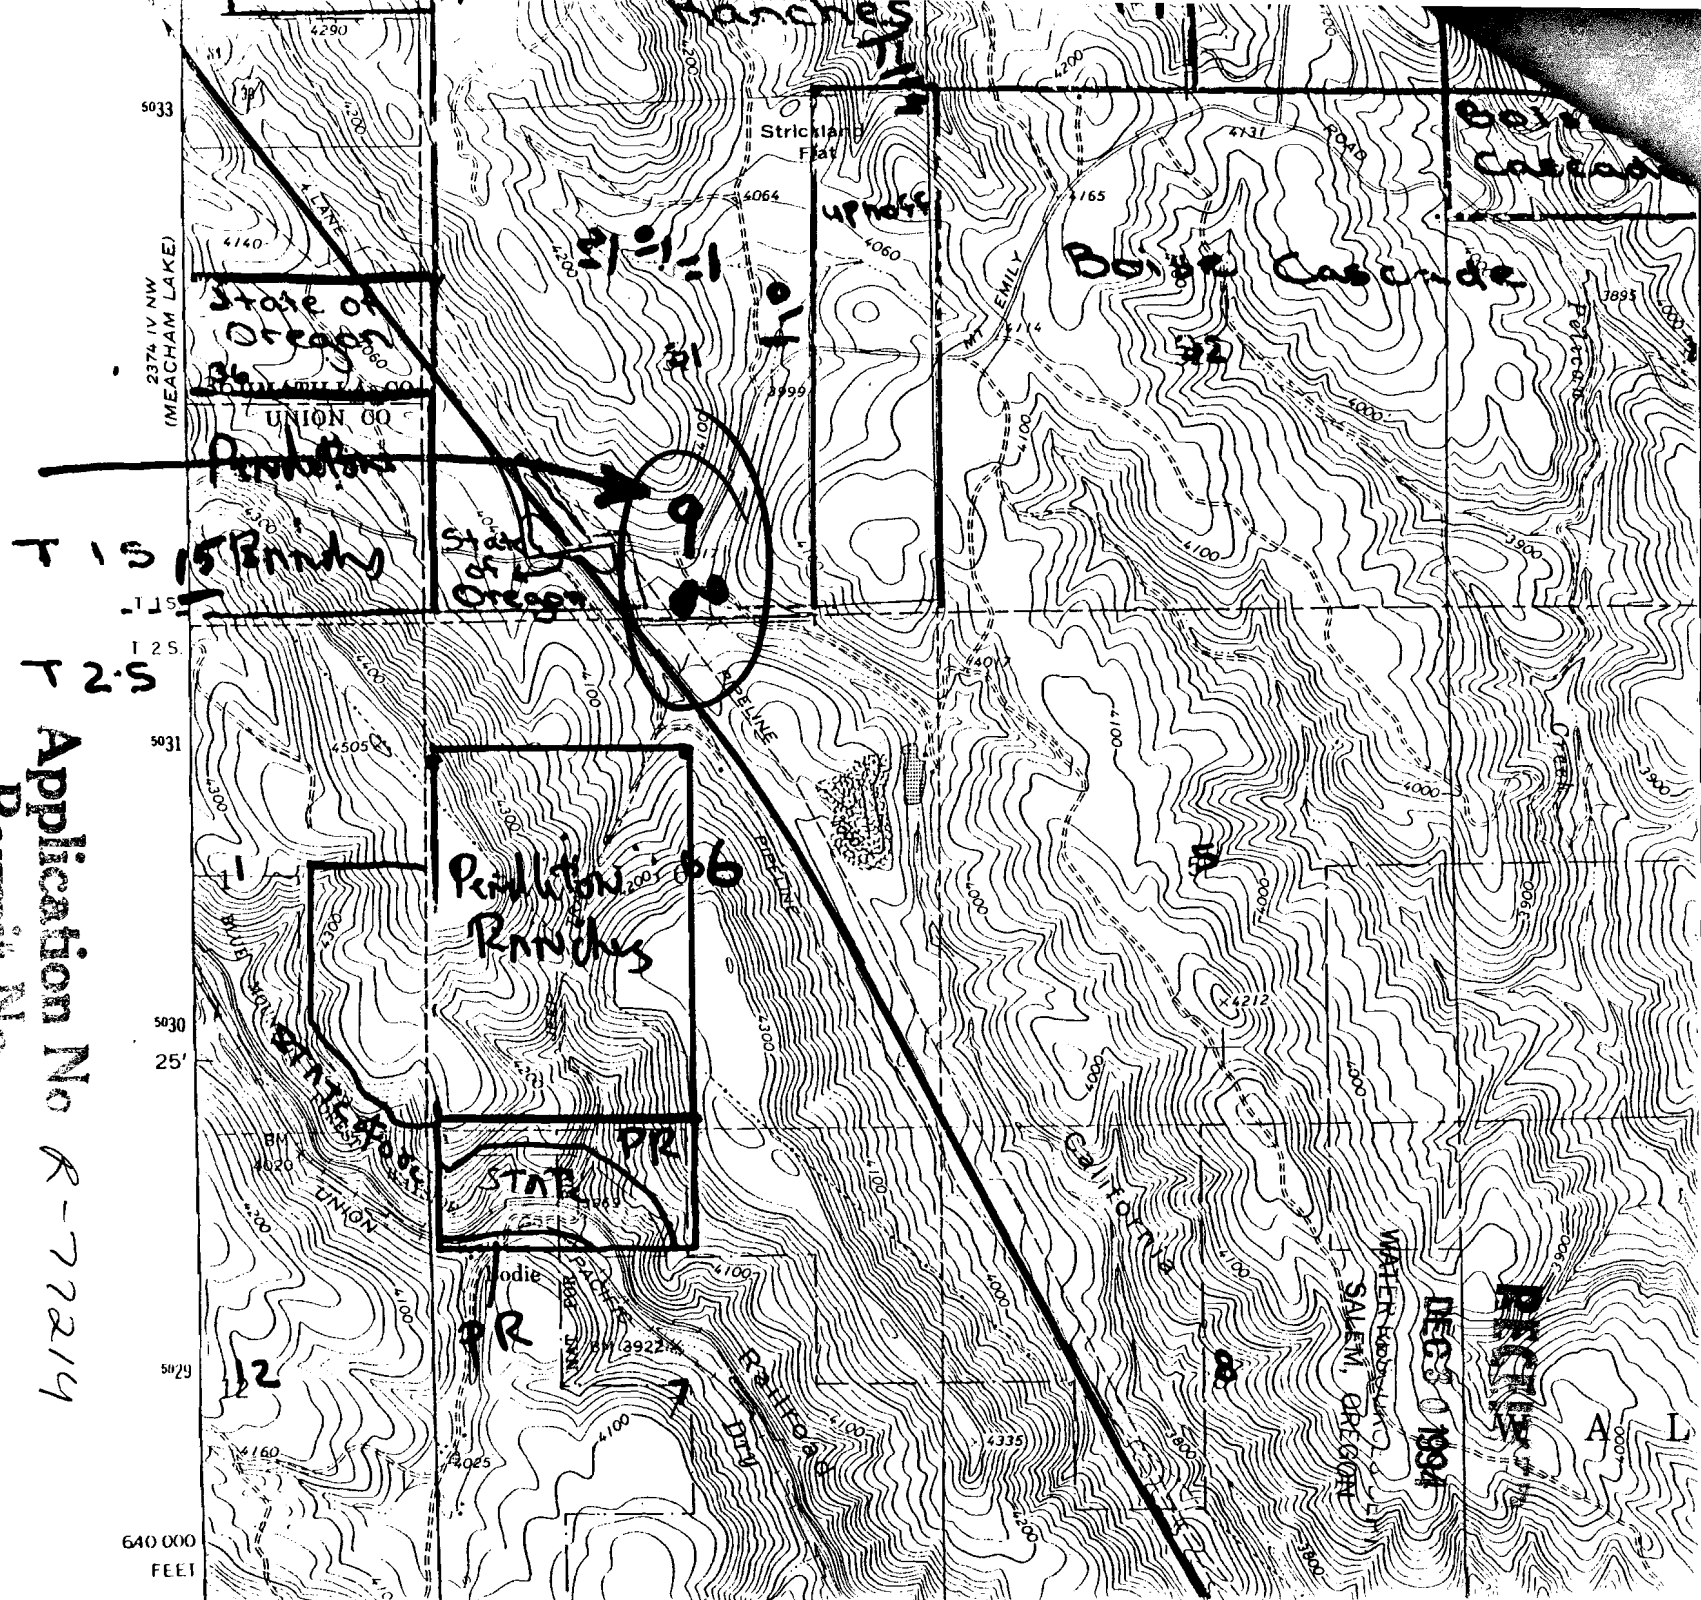



DEC 1994



T 1.5 1.5 Bandy
T 1.5
T 2.5 1.25

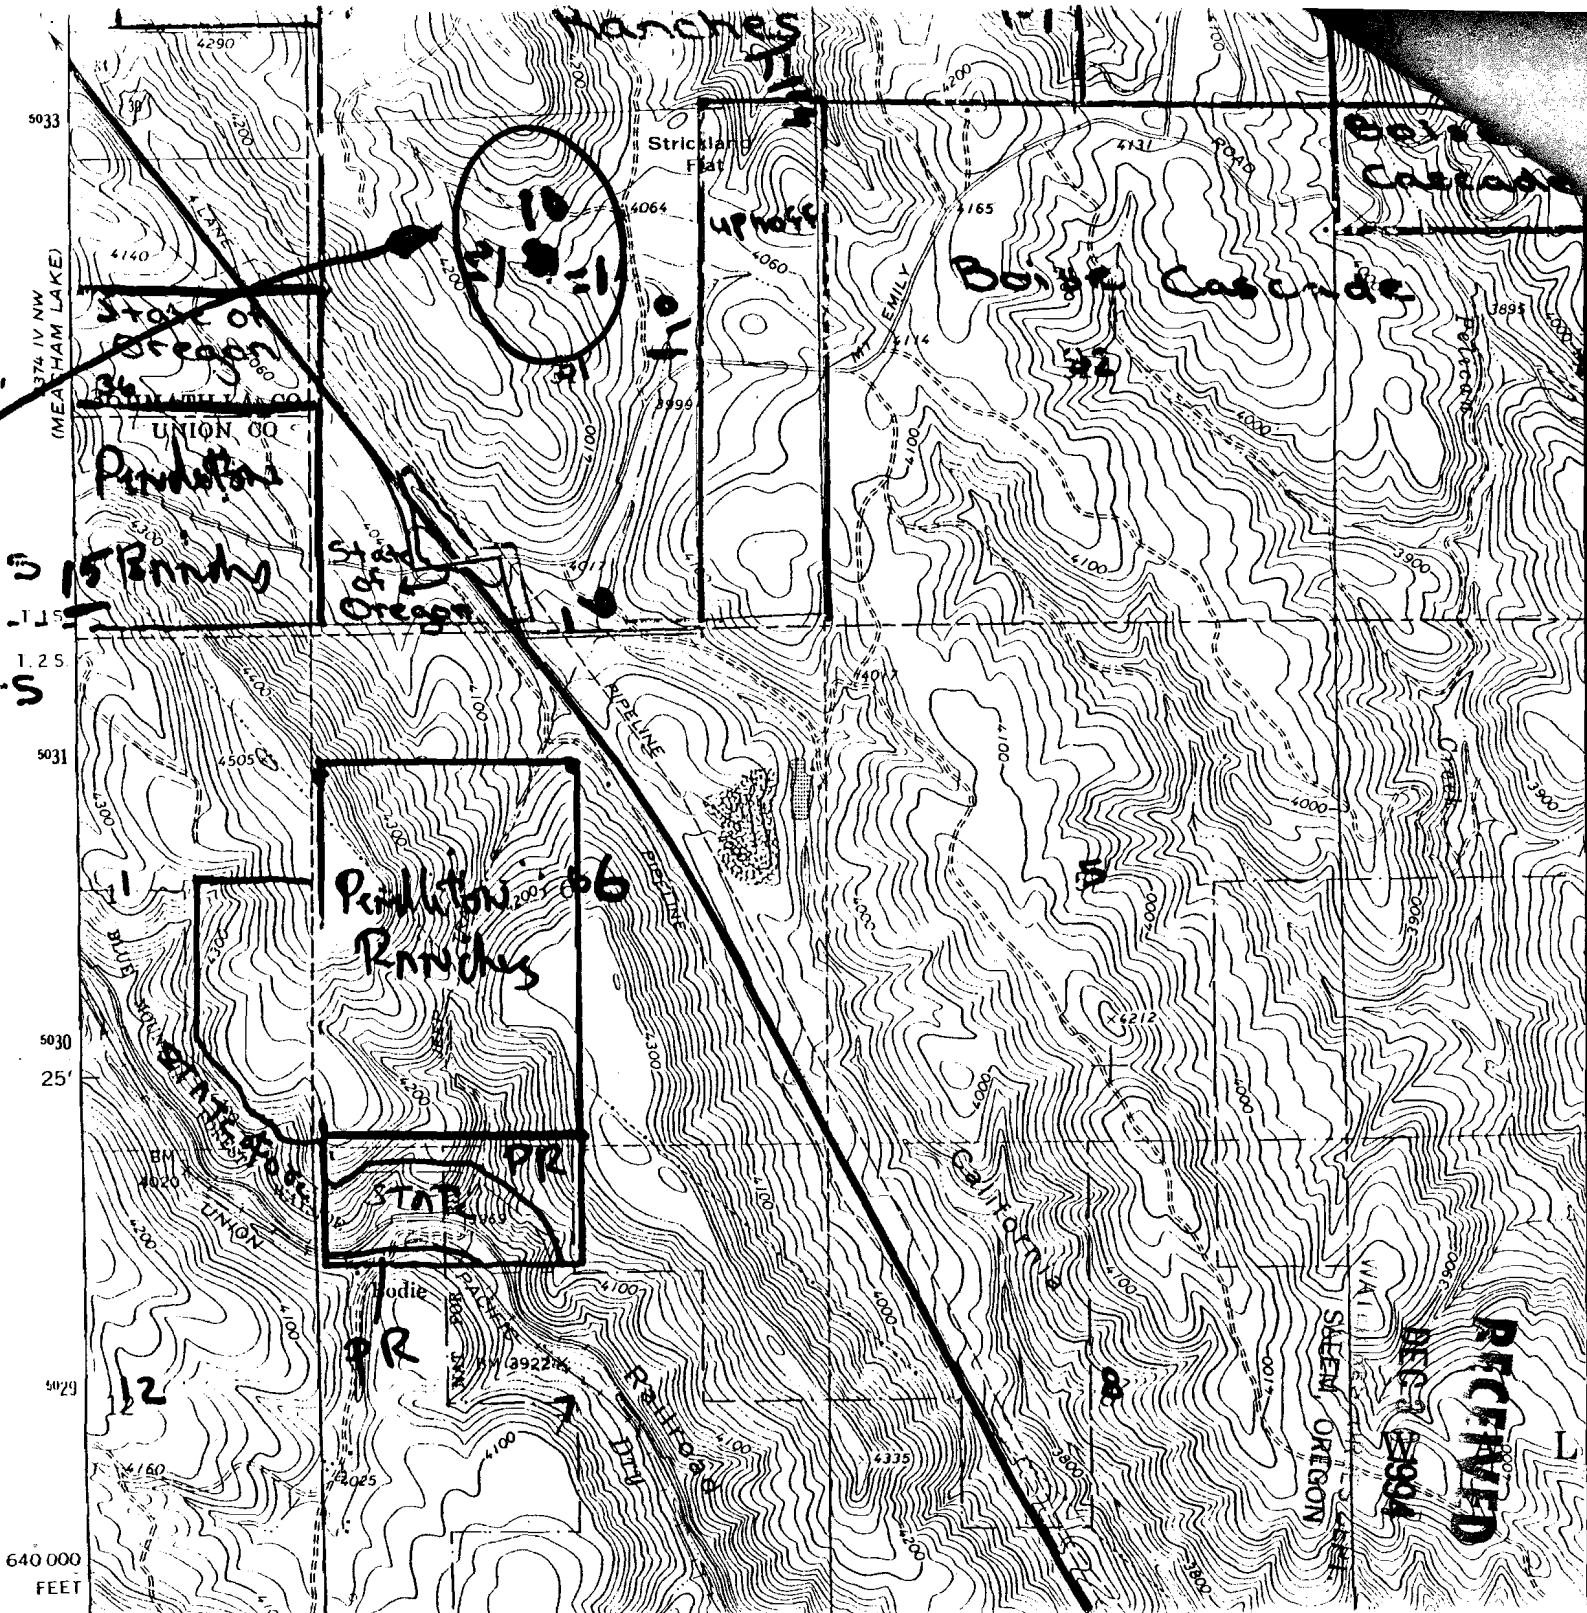

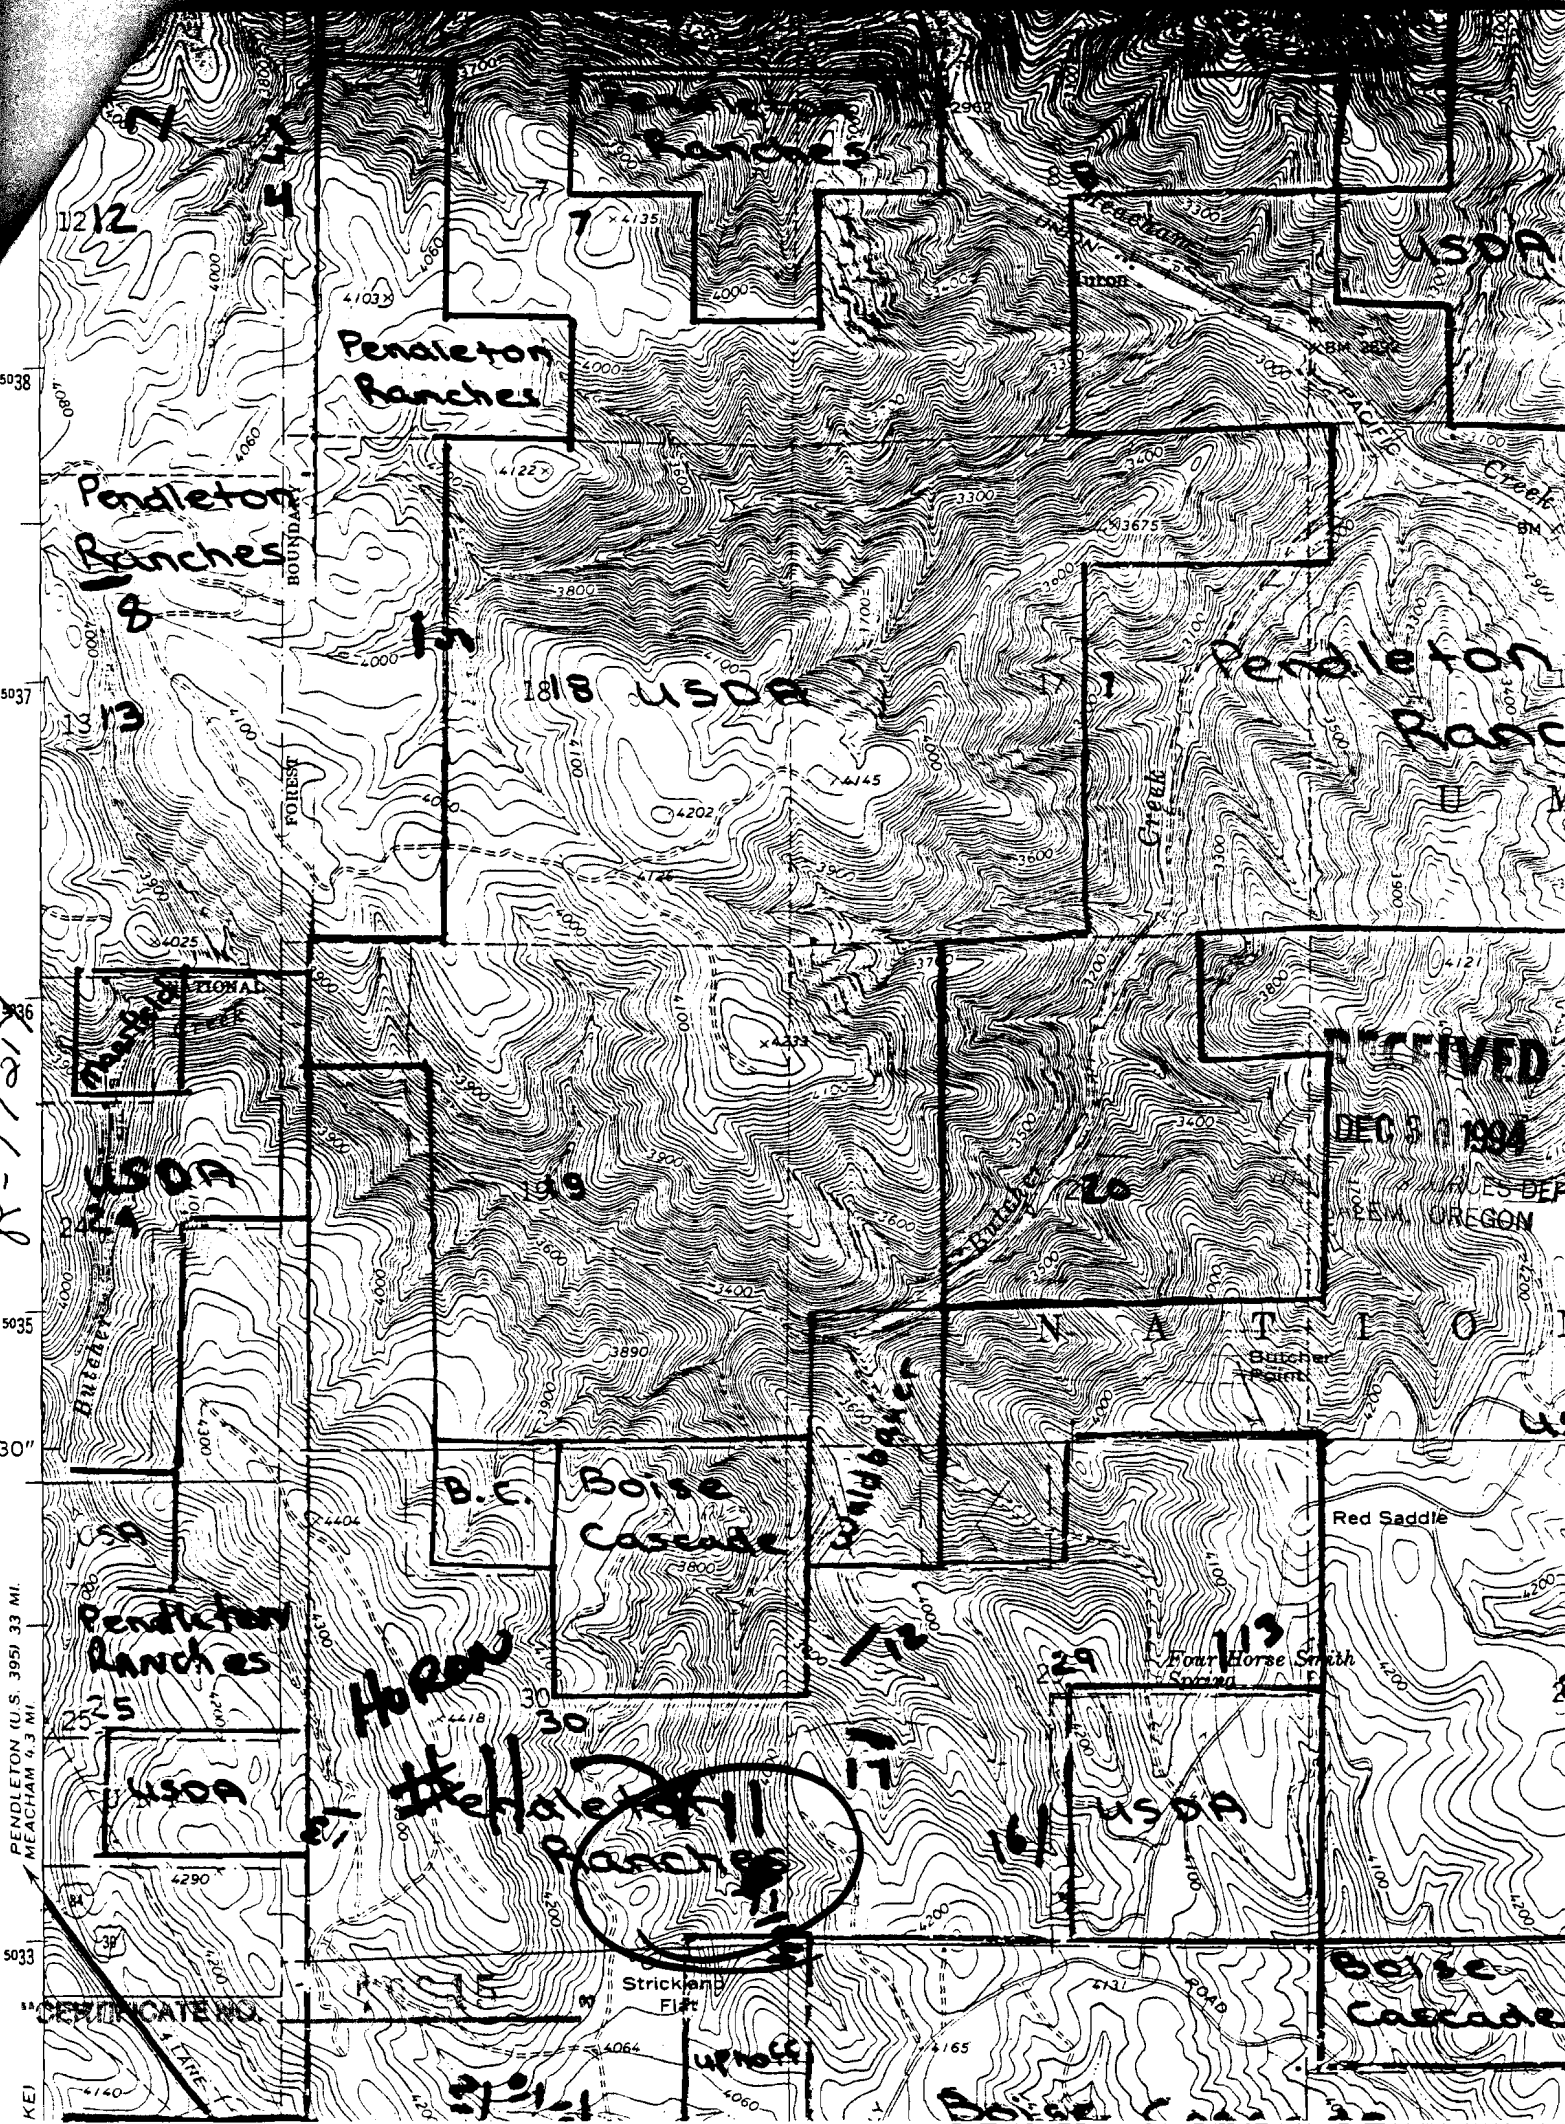

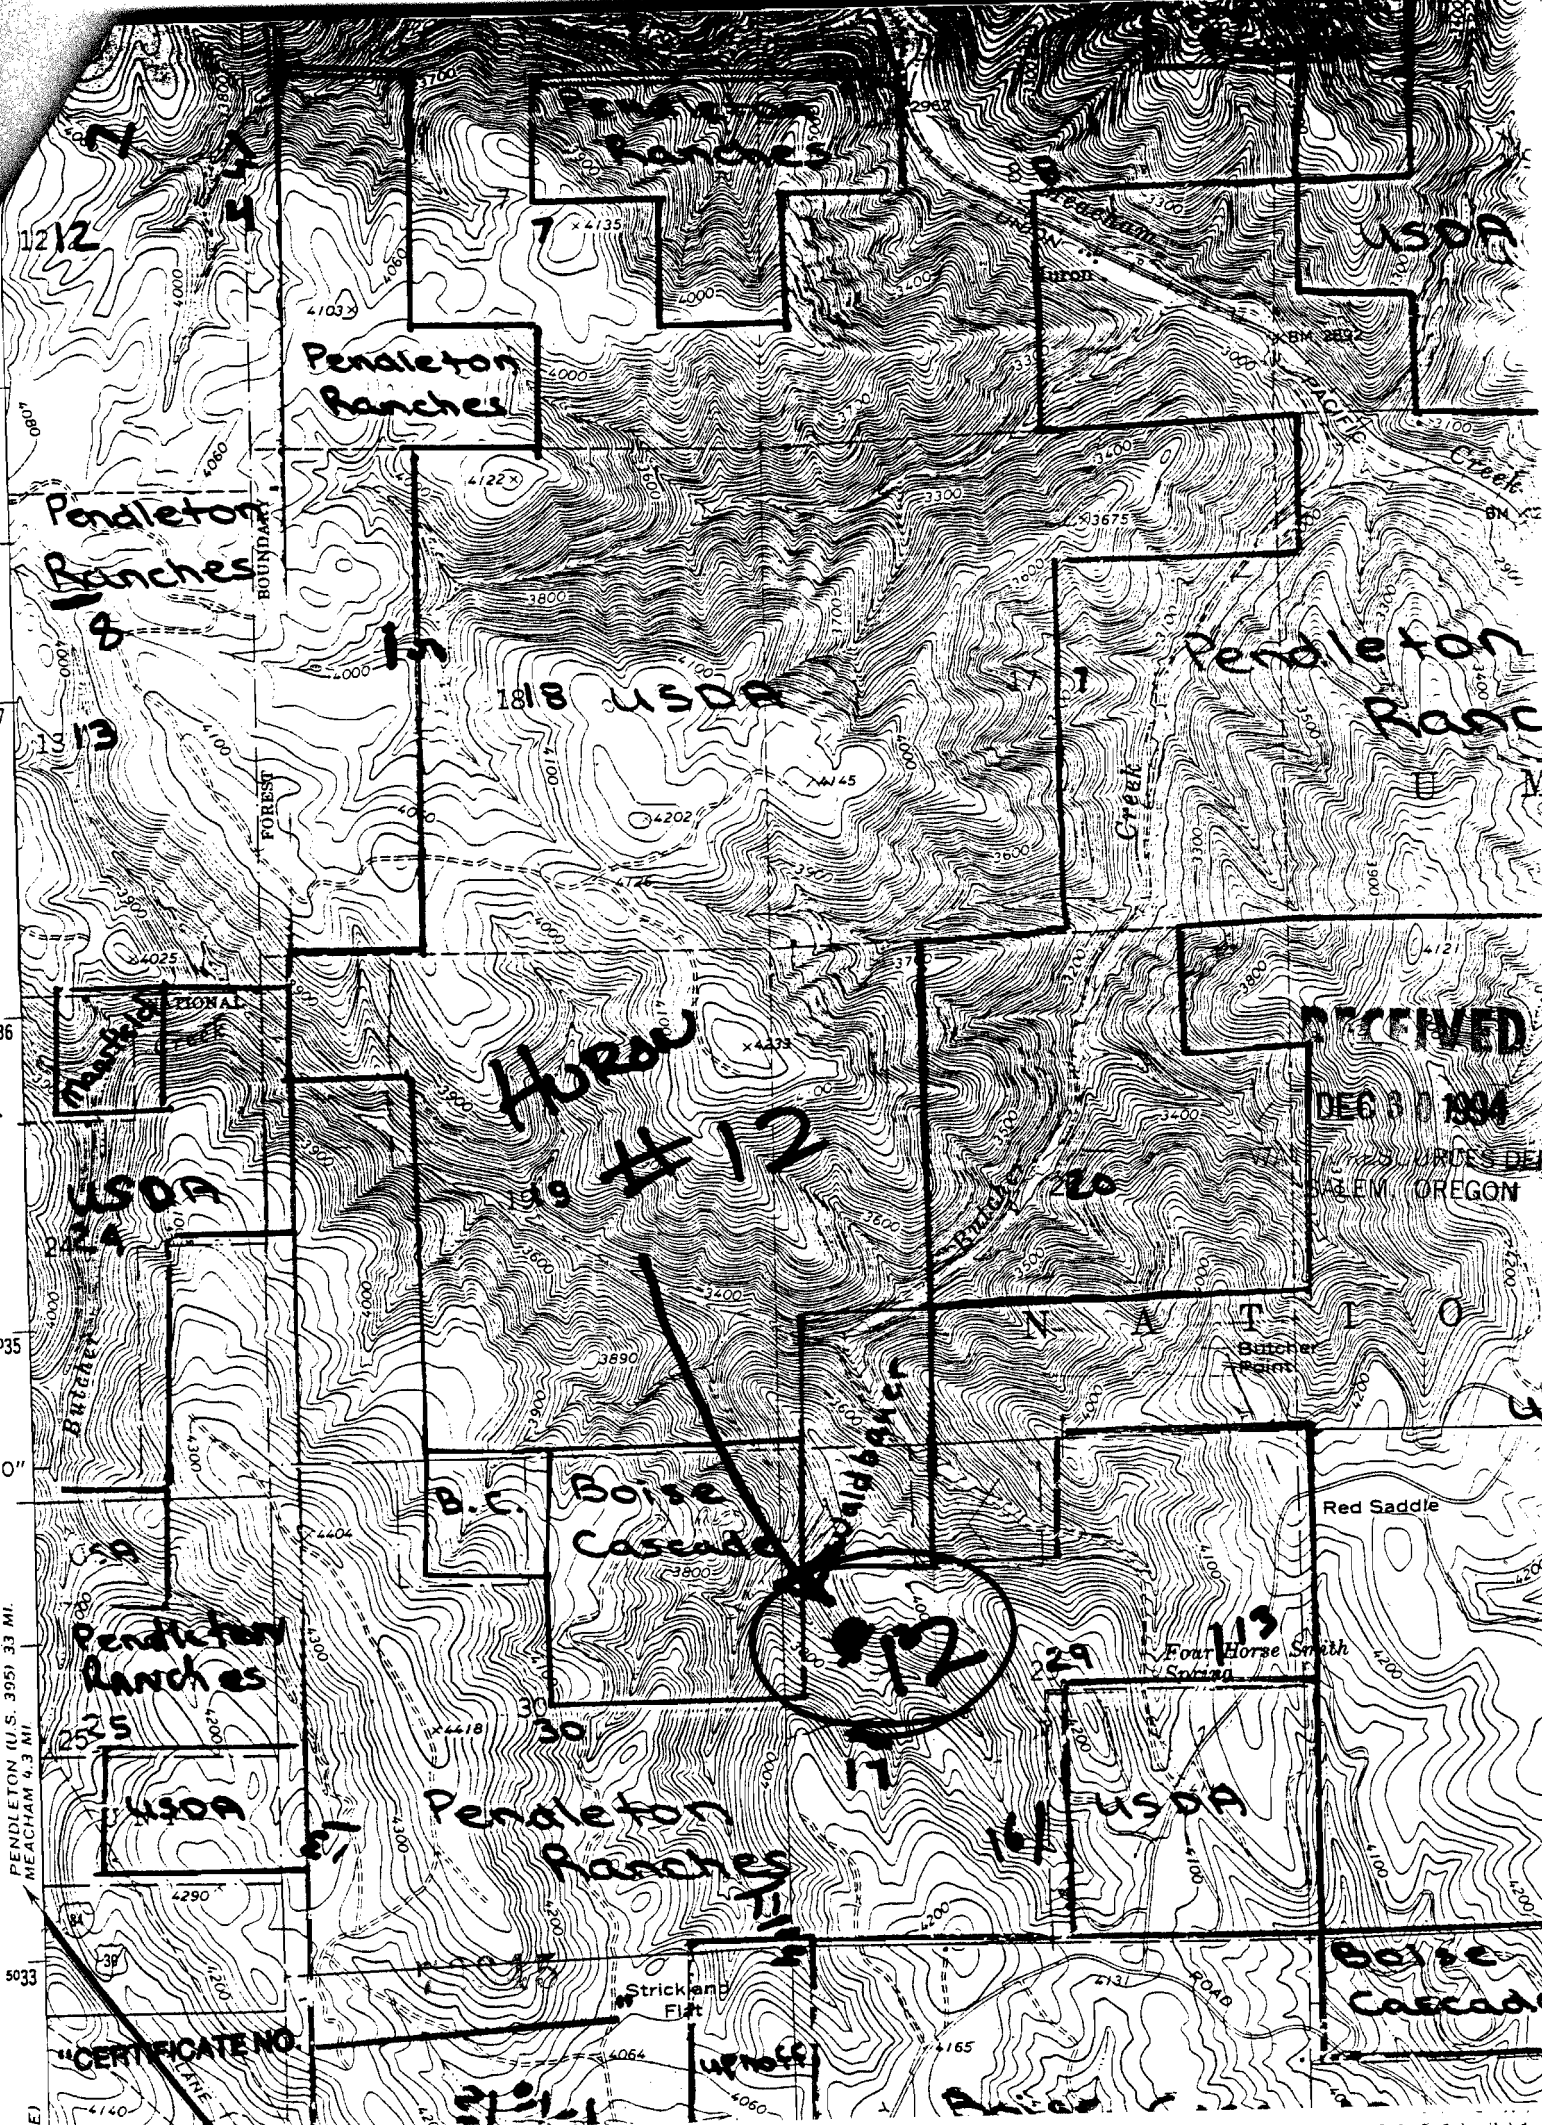

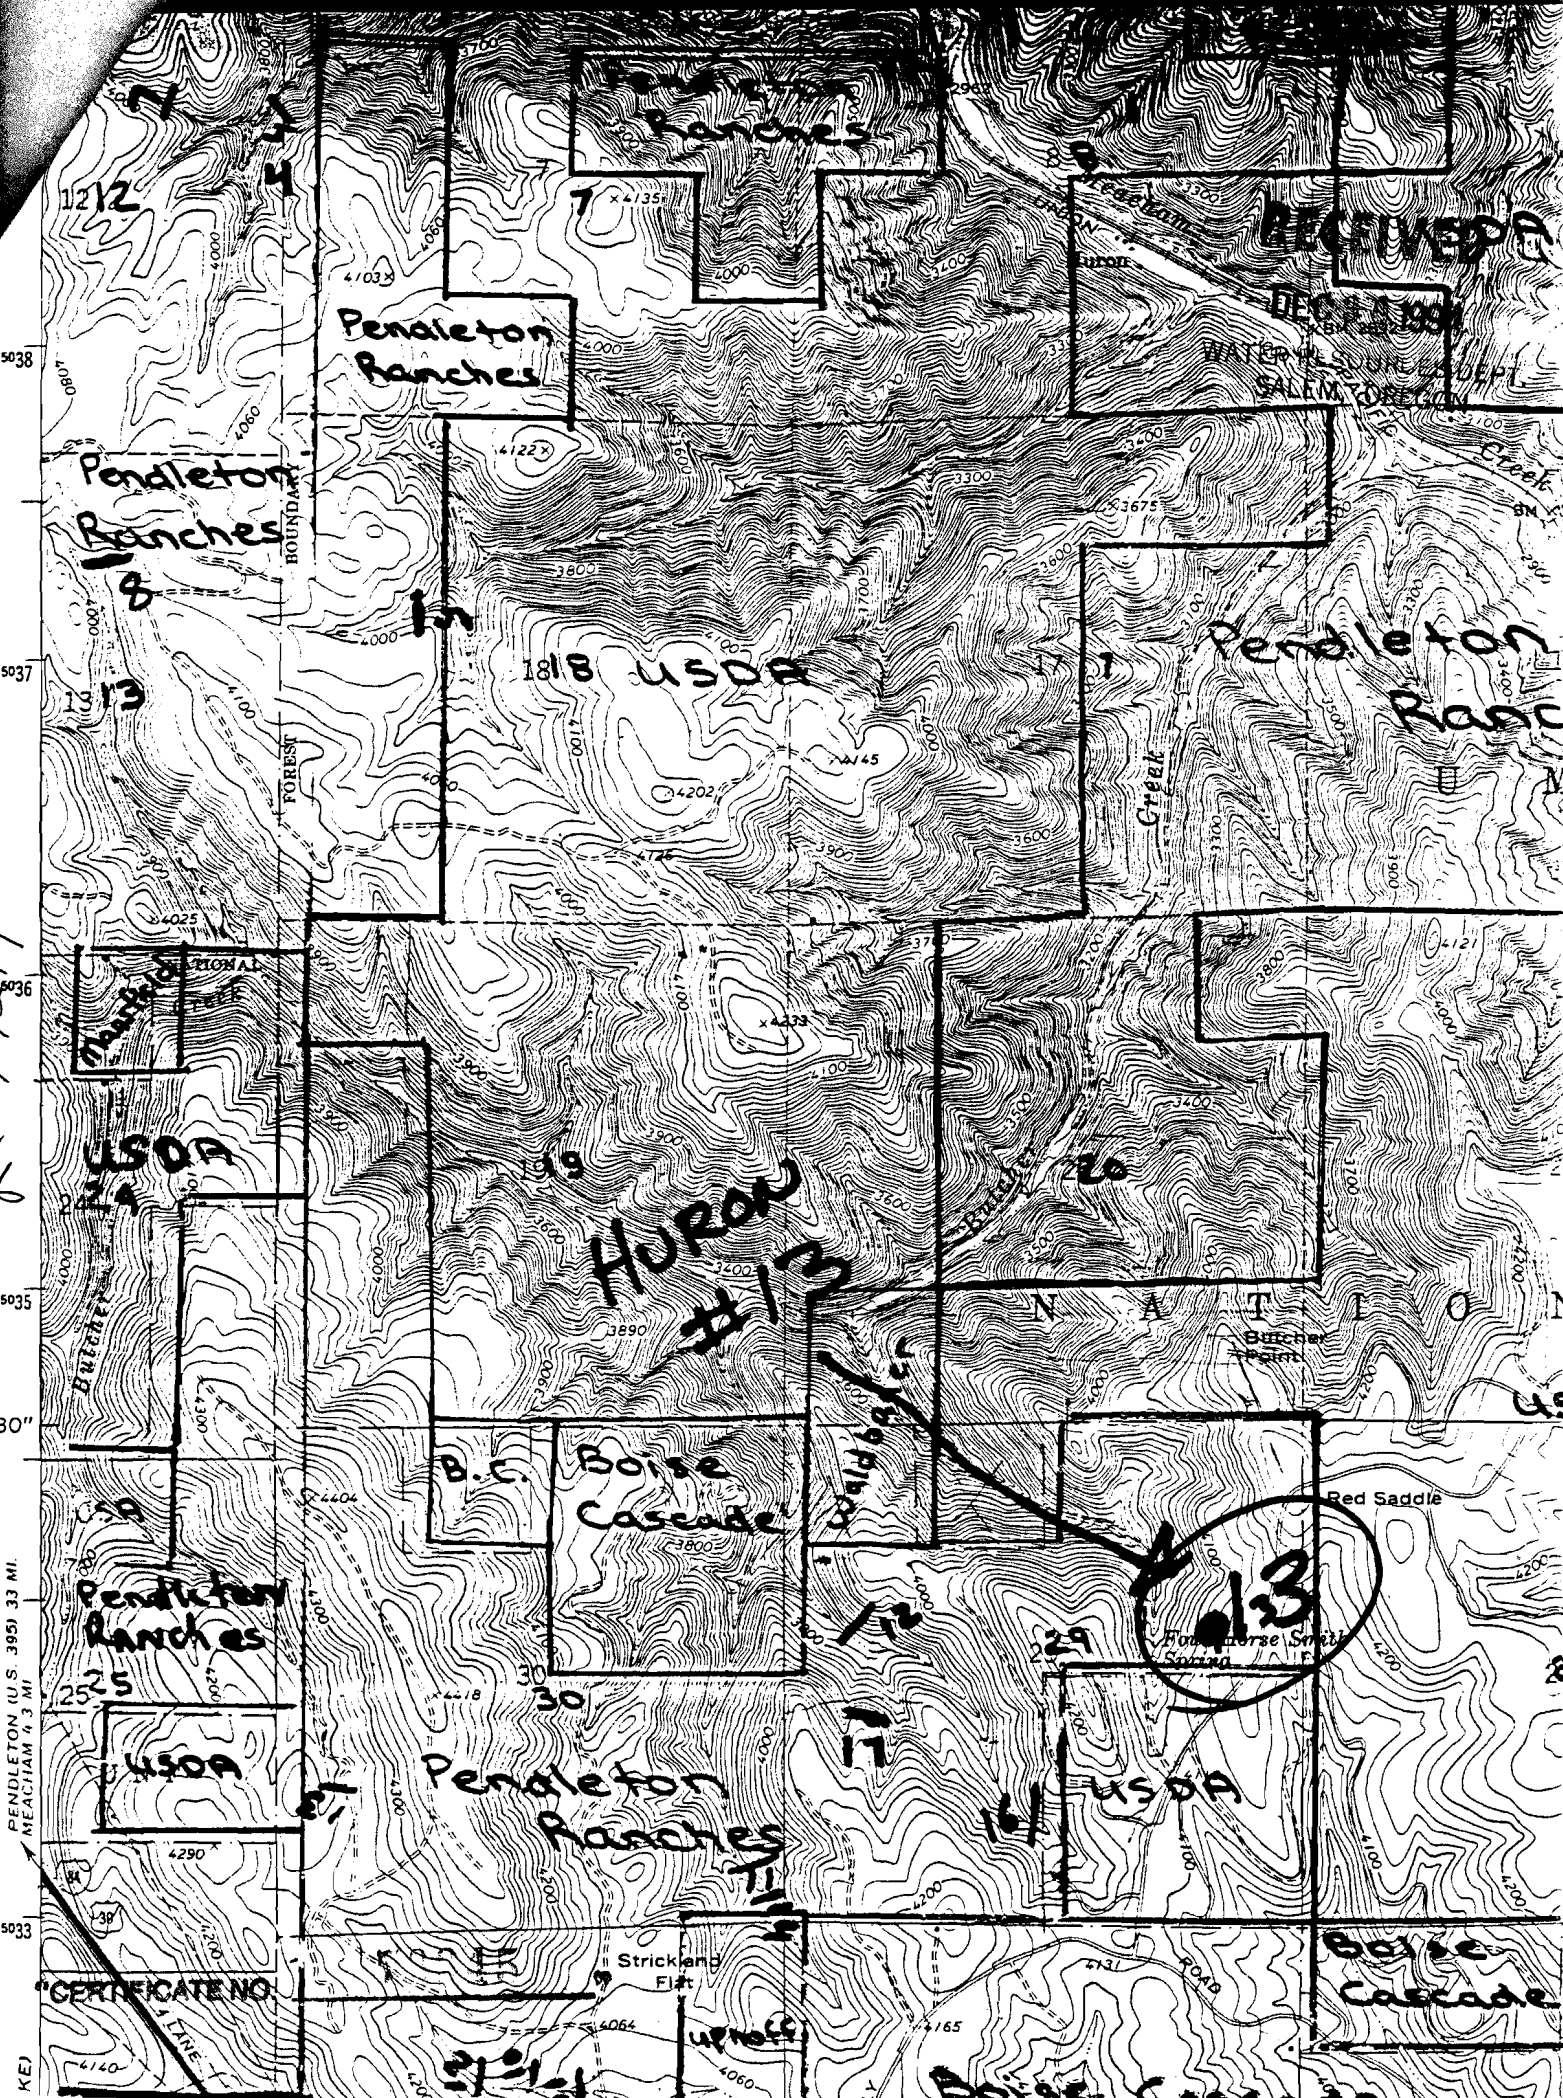

1212

7 x 4135

Pendleton Ranches

RECEIVED PA


WATER RESOURCES DEPT

Pendleton Ranches

Pendleton Ranches

1818 USDA

USDA

HURON #13

B.E. Boise Cascade

Pendleton Ranches

USDA

Pendleton Ranches


USDA

Boise Cascade

Strickland Flat

CERTIFICATE NO.

7.5 MINUTE SERIES (TOPOGRAPHIC)

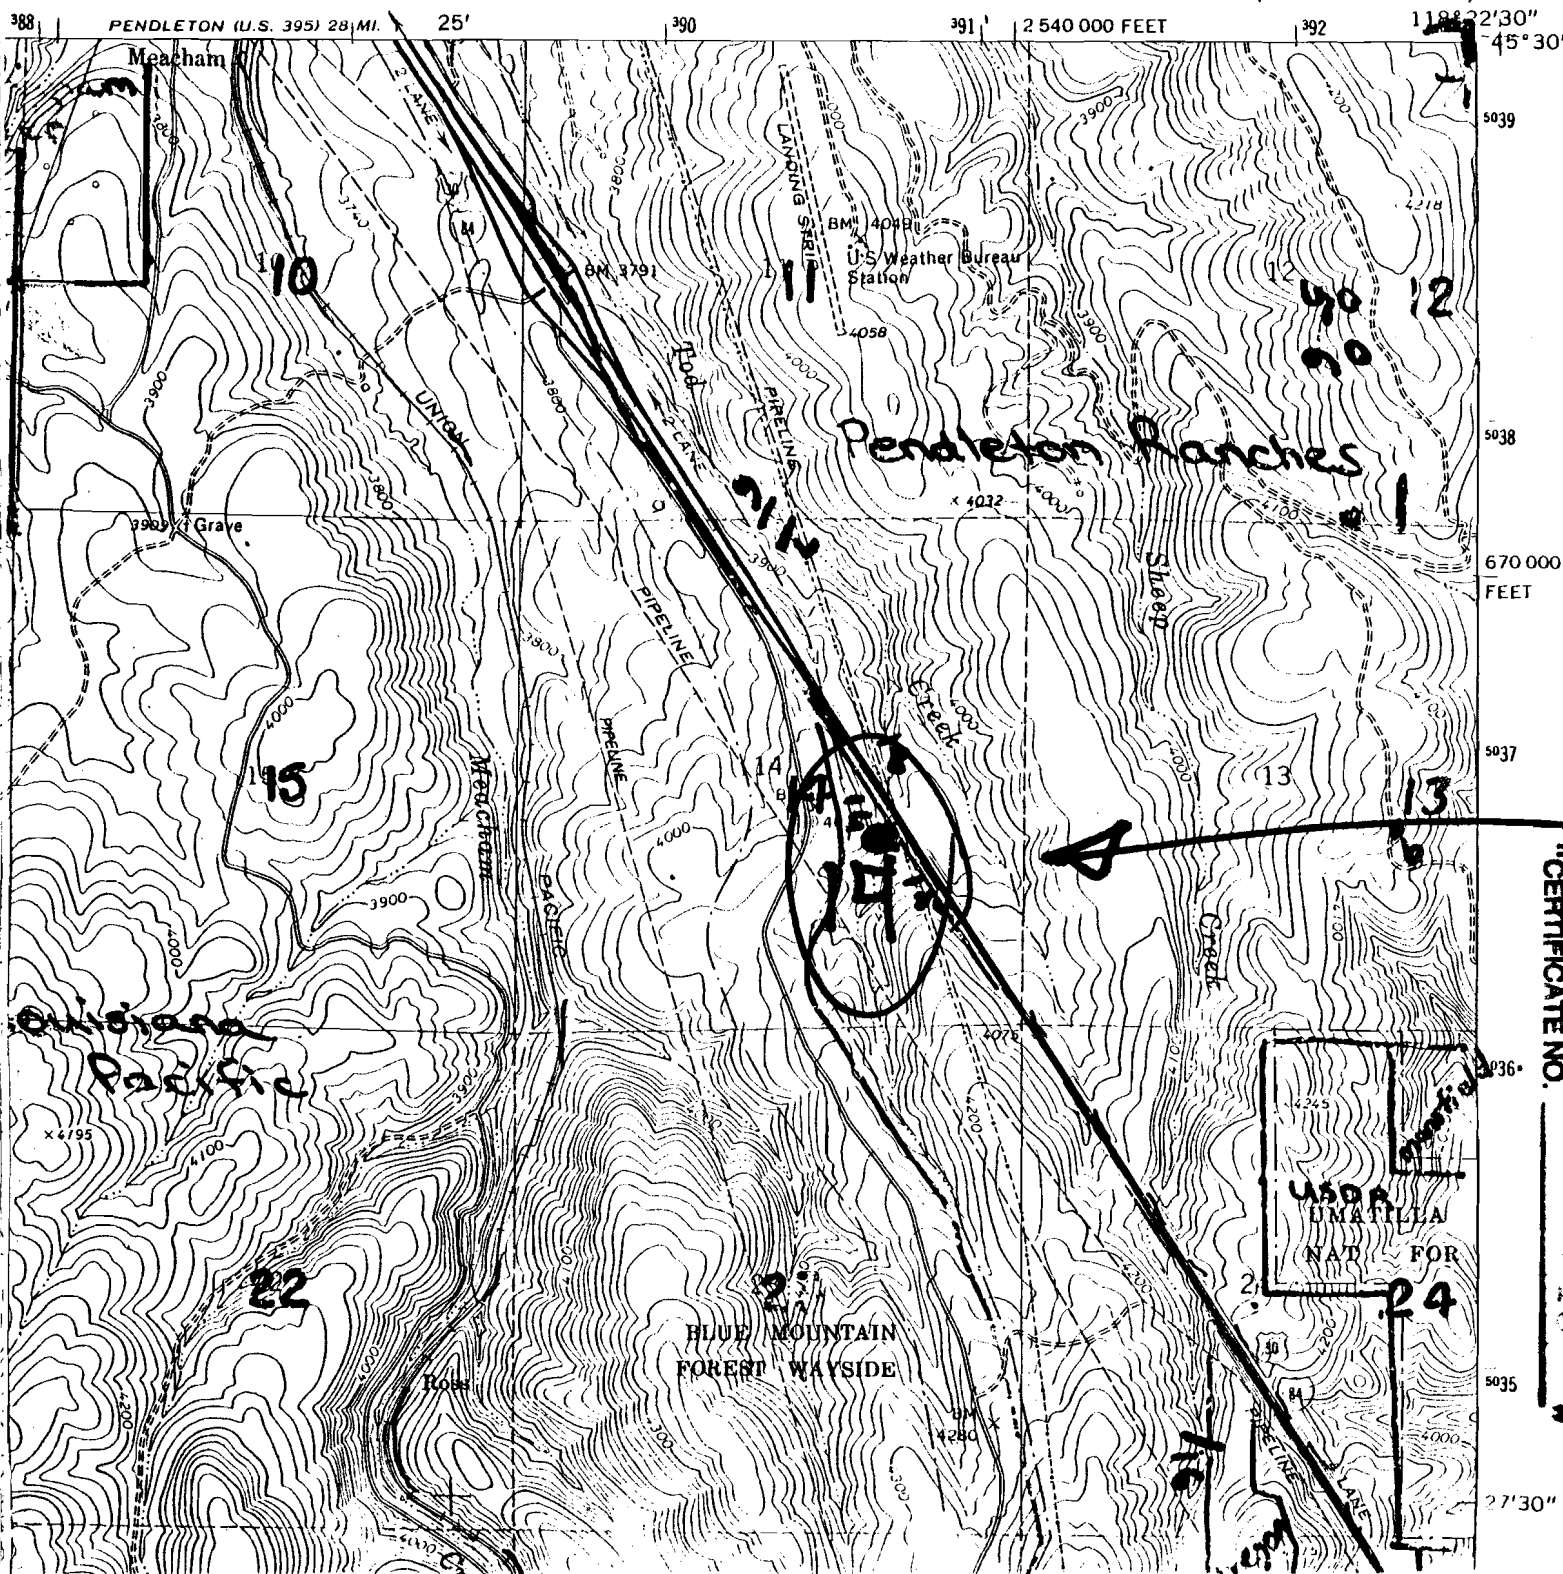

Application No. K-77214
Permit No.

RECEIVED

DEC 30 1994

WATER RESOURCES DEPT.
SALEM, OREGON


Meachem
LAKE
#14

WATER RESOURCES DEPT.
SALEM, OREGON

CERTIFICATE NO.

10

27'30"

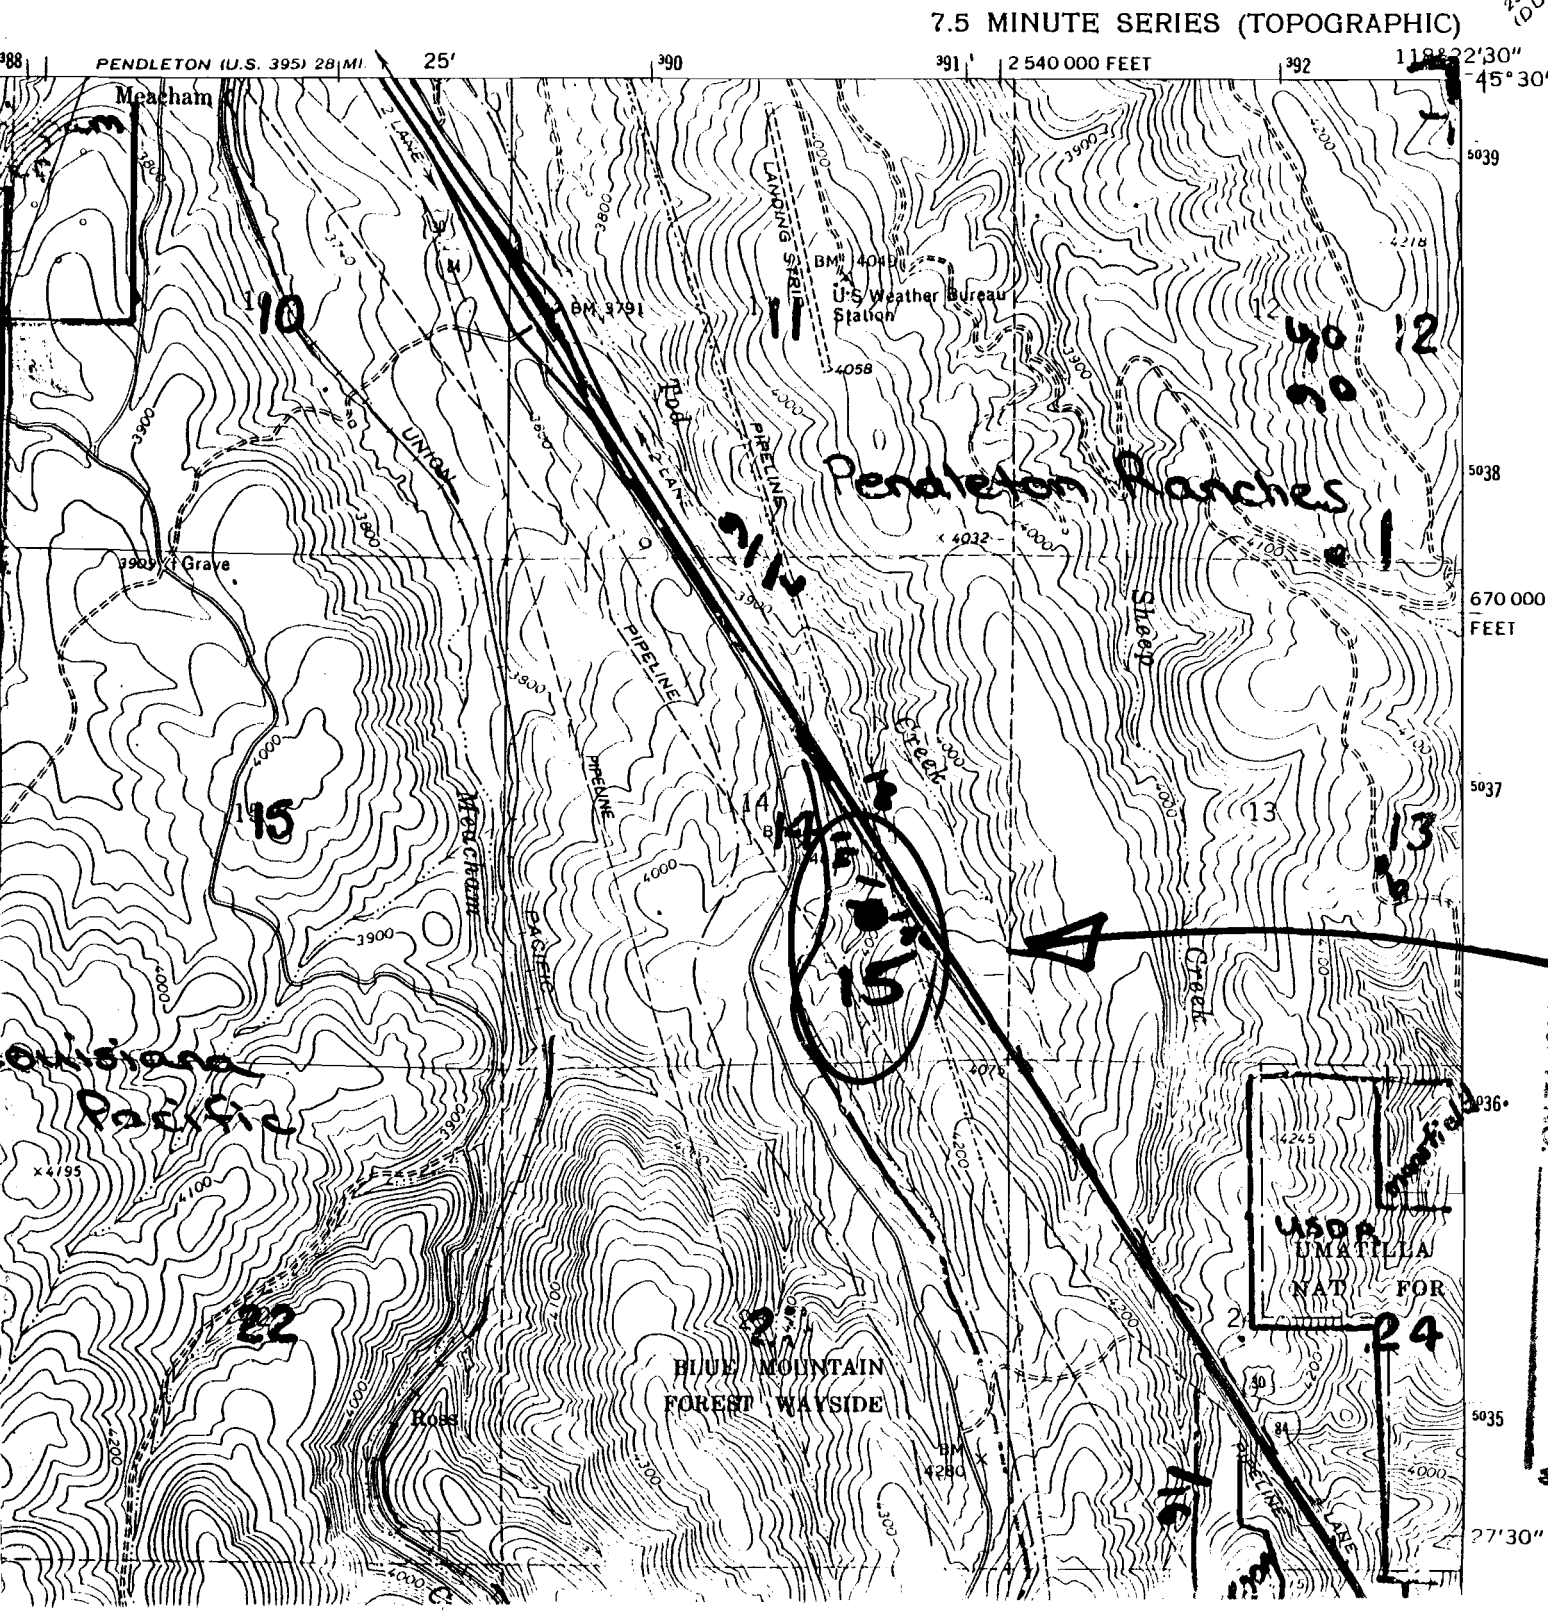

This is a topographic map of the Pendleton Ranches area. The map features contour lines indicating elevation, with labels such as 3900, 4000, and 4100 feet. Key locations and features include:

- Meacham**: Located in the upper left corner.
- Union**: A road or boundary line running diagonally across the map.
- Pendleton Ranches**: The central area of the map, with a large handwritten '21' and '11' overlaid.
- U.S. Weather Bureau Station**: Located near the center-right.
- Blue Mountain Forest Wayside**: Located in the lower center.
- Original Pacific**: A handwritten note in the lower left.
- USDA Umatilla Nat. For**: A rectangular area in the lower right, with a handwritten '16' and '24' overlaid.
- Handwritten Annotations**: Various numbers and letters are written throughout the map, including '10', '11', '12', '13', '14', '15', '16', '21', '22', '24', '25', '26','99', '100'.

Application No. R-77214
Permit No.

MEACHAM
LAKE

RECEIVED
DEC 30 1994
WATER RESOURCES DEPT
SALEM, OREGON

CERTIFICATE NO.

5

50

27'30"

