


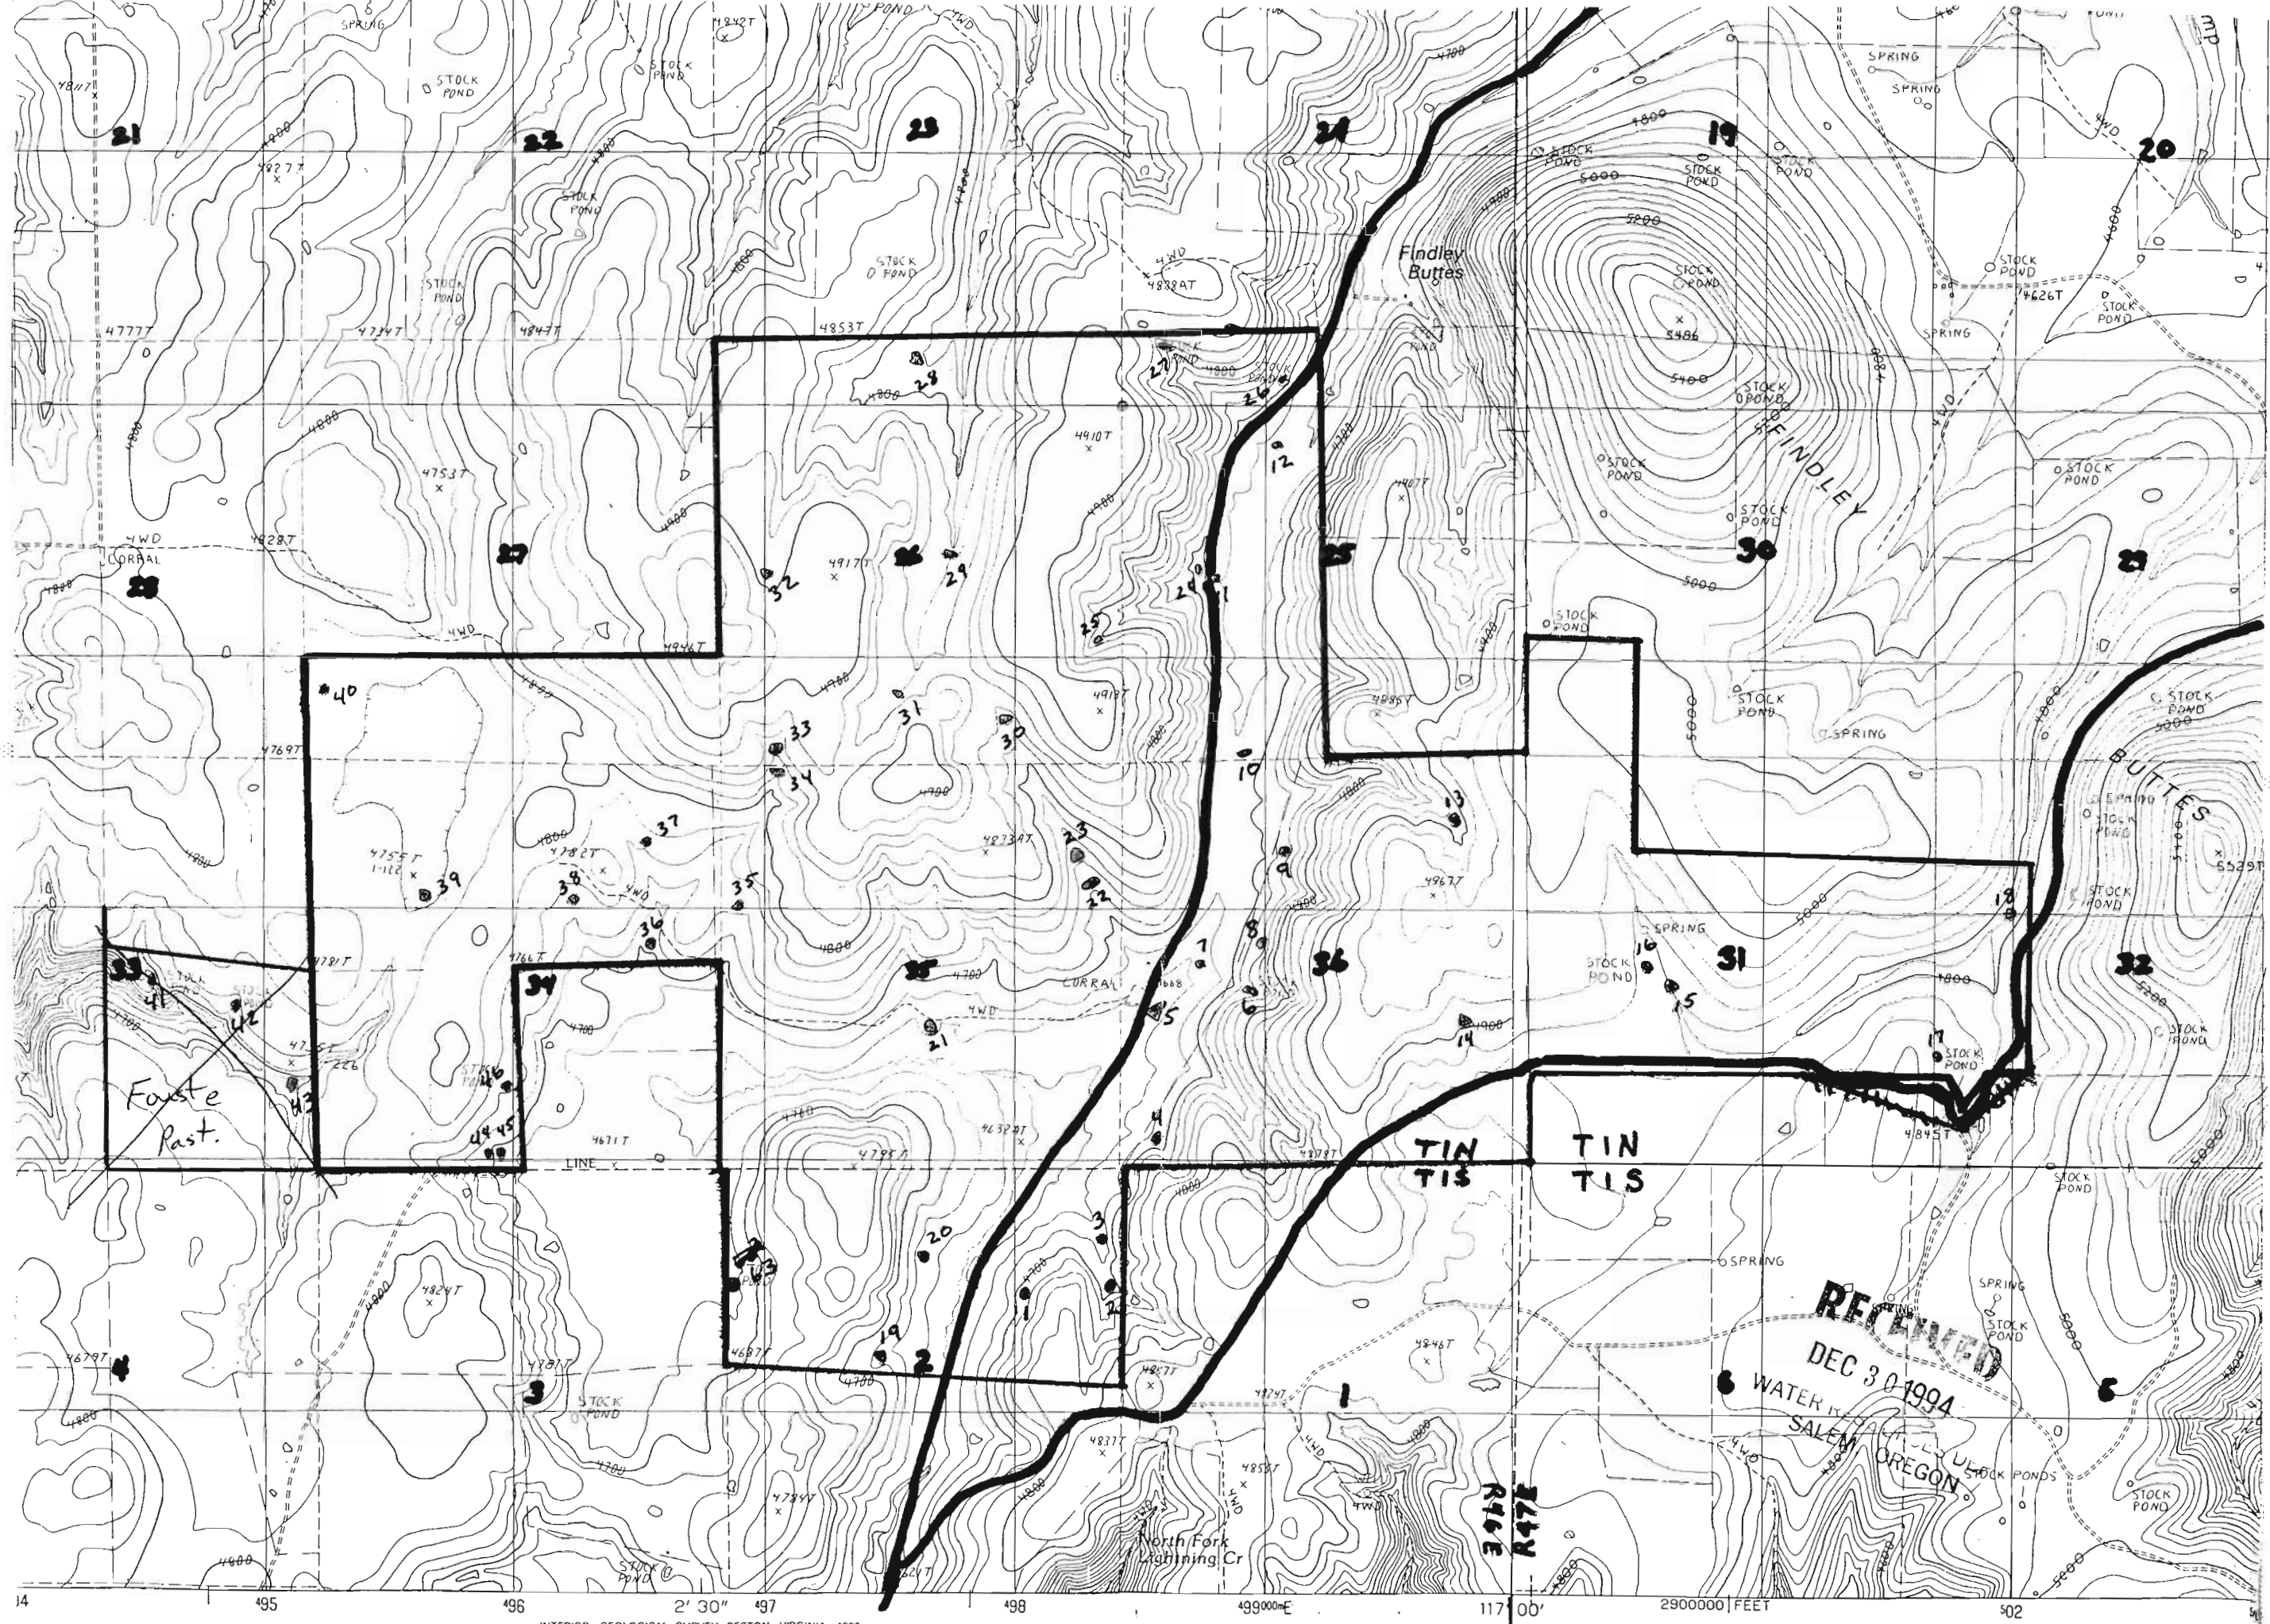

"CERTIFICATE NO.

77046

Application No. R-77215
Permit No.

RECEIVED
DEC 30 1994
WATER RESOURCES
SALEM, OREGON

No Final Proof Map available

No Permit Map available