


No Final Proof Map available

No Permit Map available

Application No. R-772110
Permit No.

CERTIFICATE NO.

77017

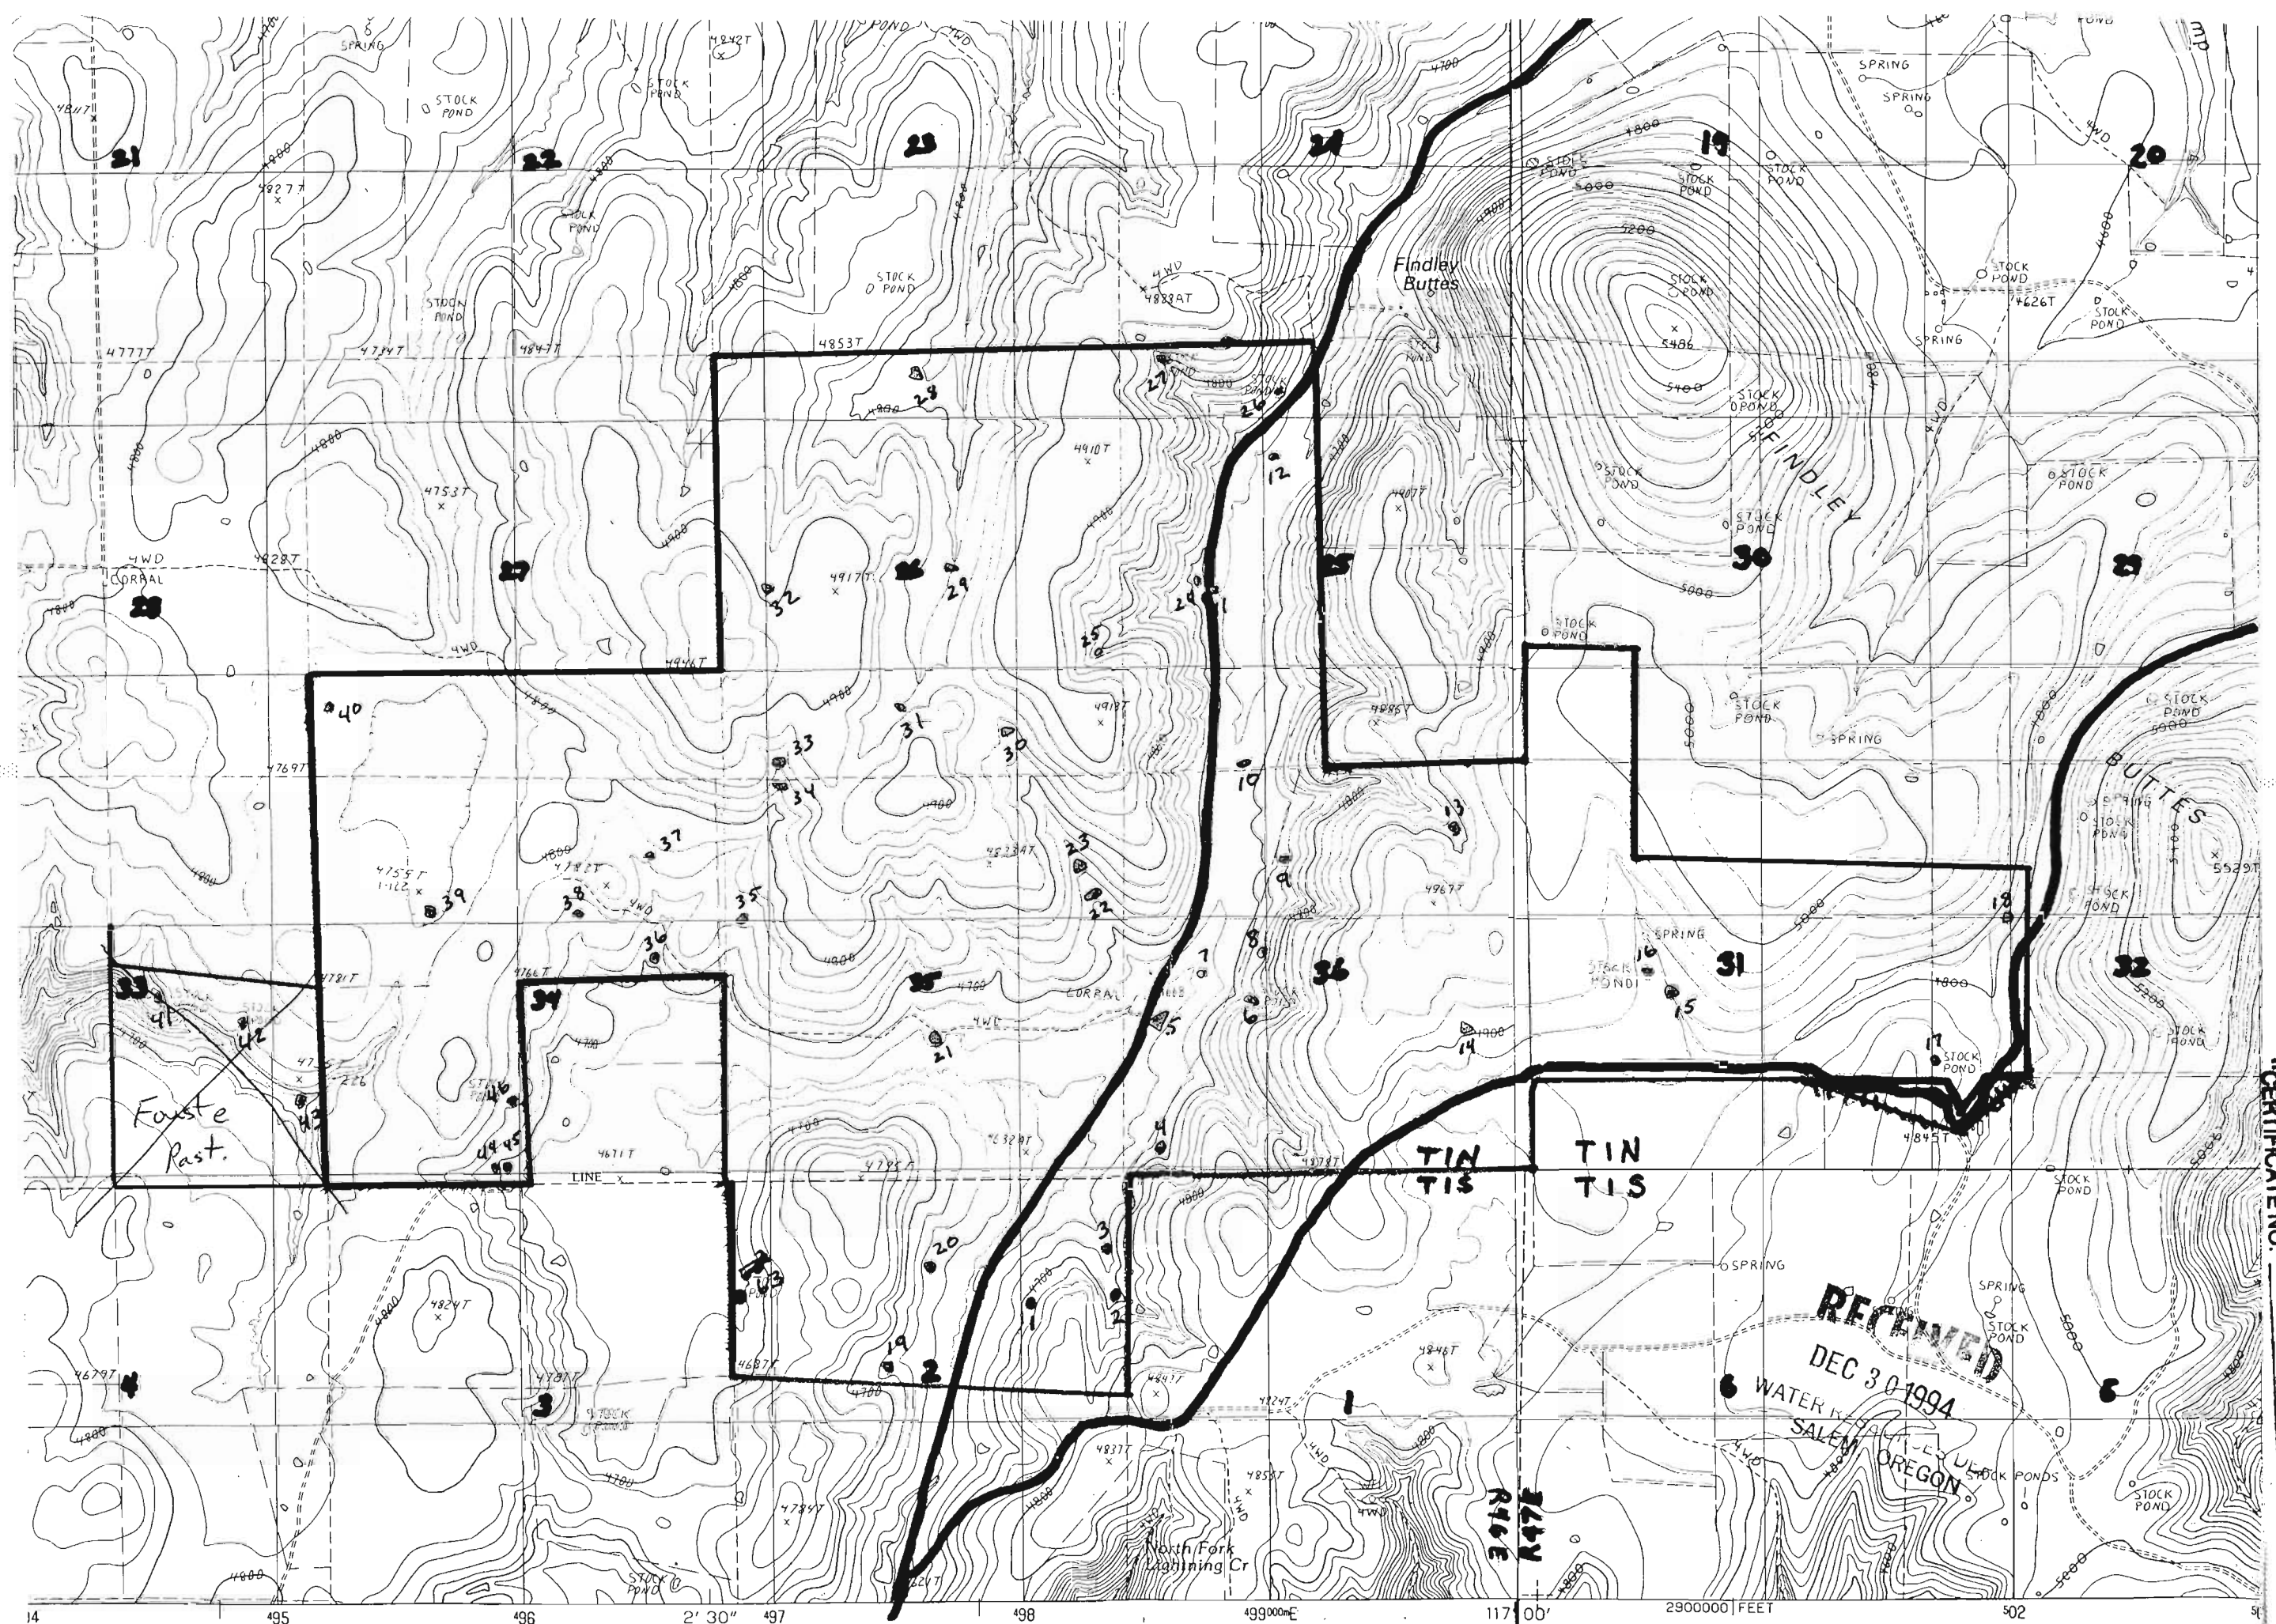

RECEIVED
DEC 30 1994
WATER RESOURCES
SALEM, OREGON

SCALE 1:24,000

INTERIOR—GEOLOGICAL SURVEY, RESTON, VIRGINIA—1990

BY THE UNITED STATES GEOLOGICAL SURVEY