


No Final Proof Map available

No Permit Map available

Application No. R-77217
Permit No.

CERTIFICATE NO.

77048

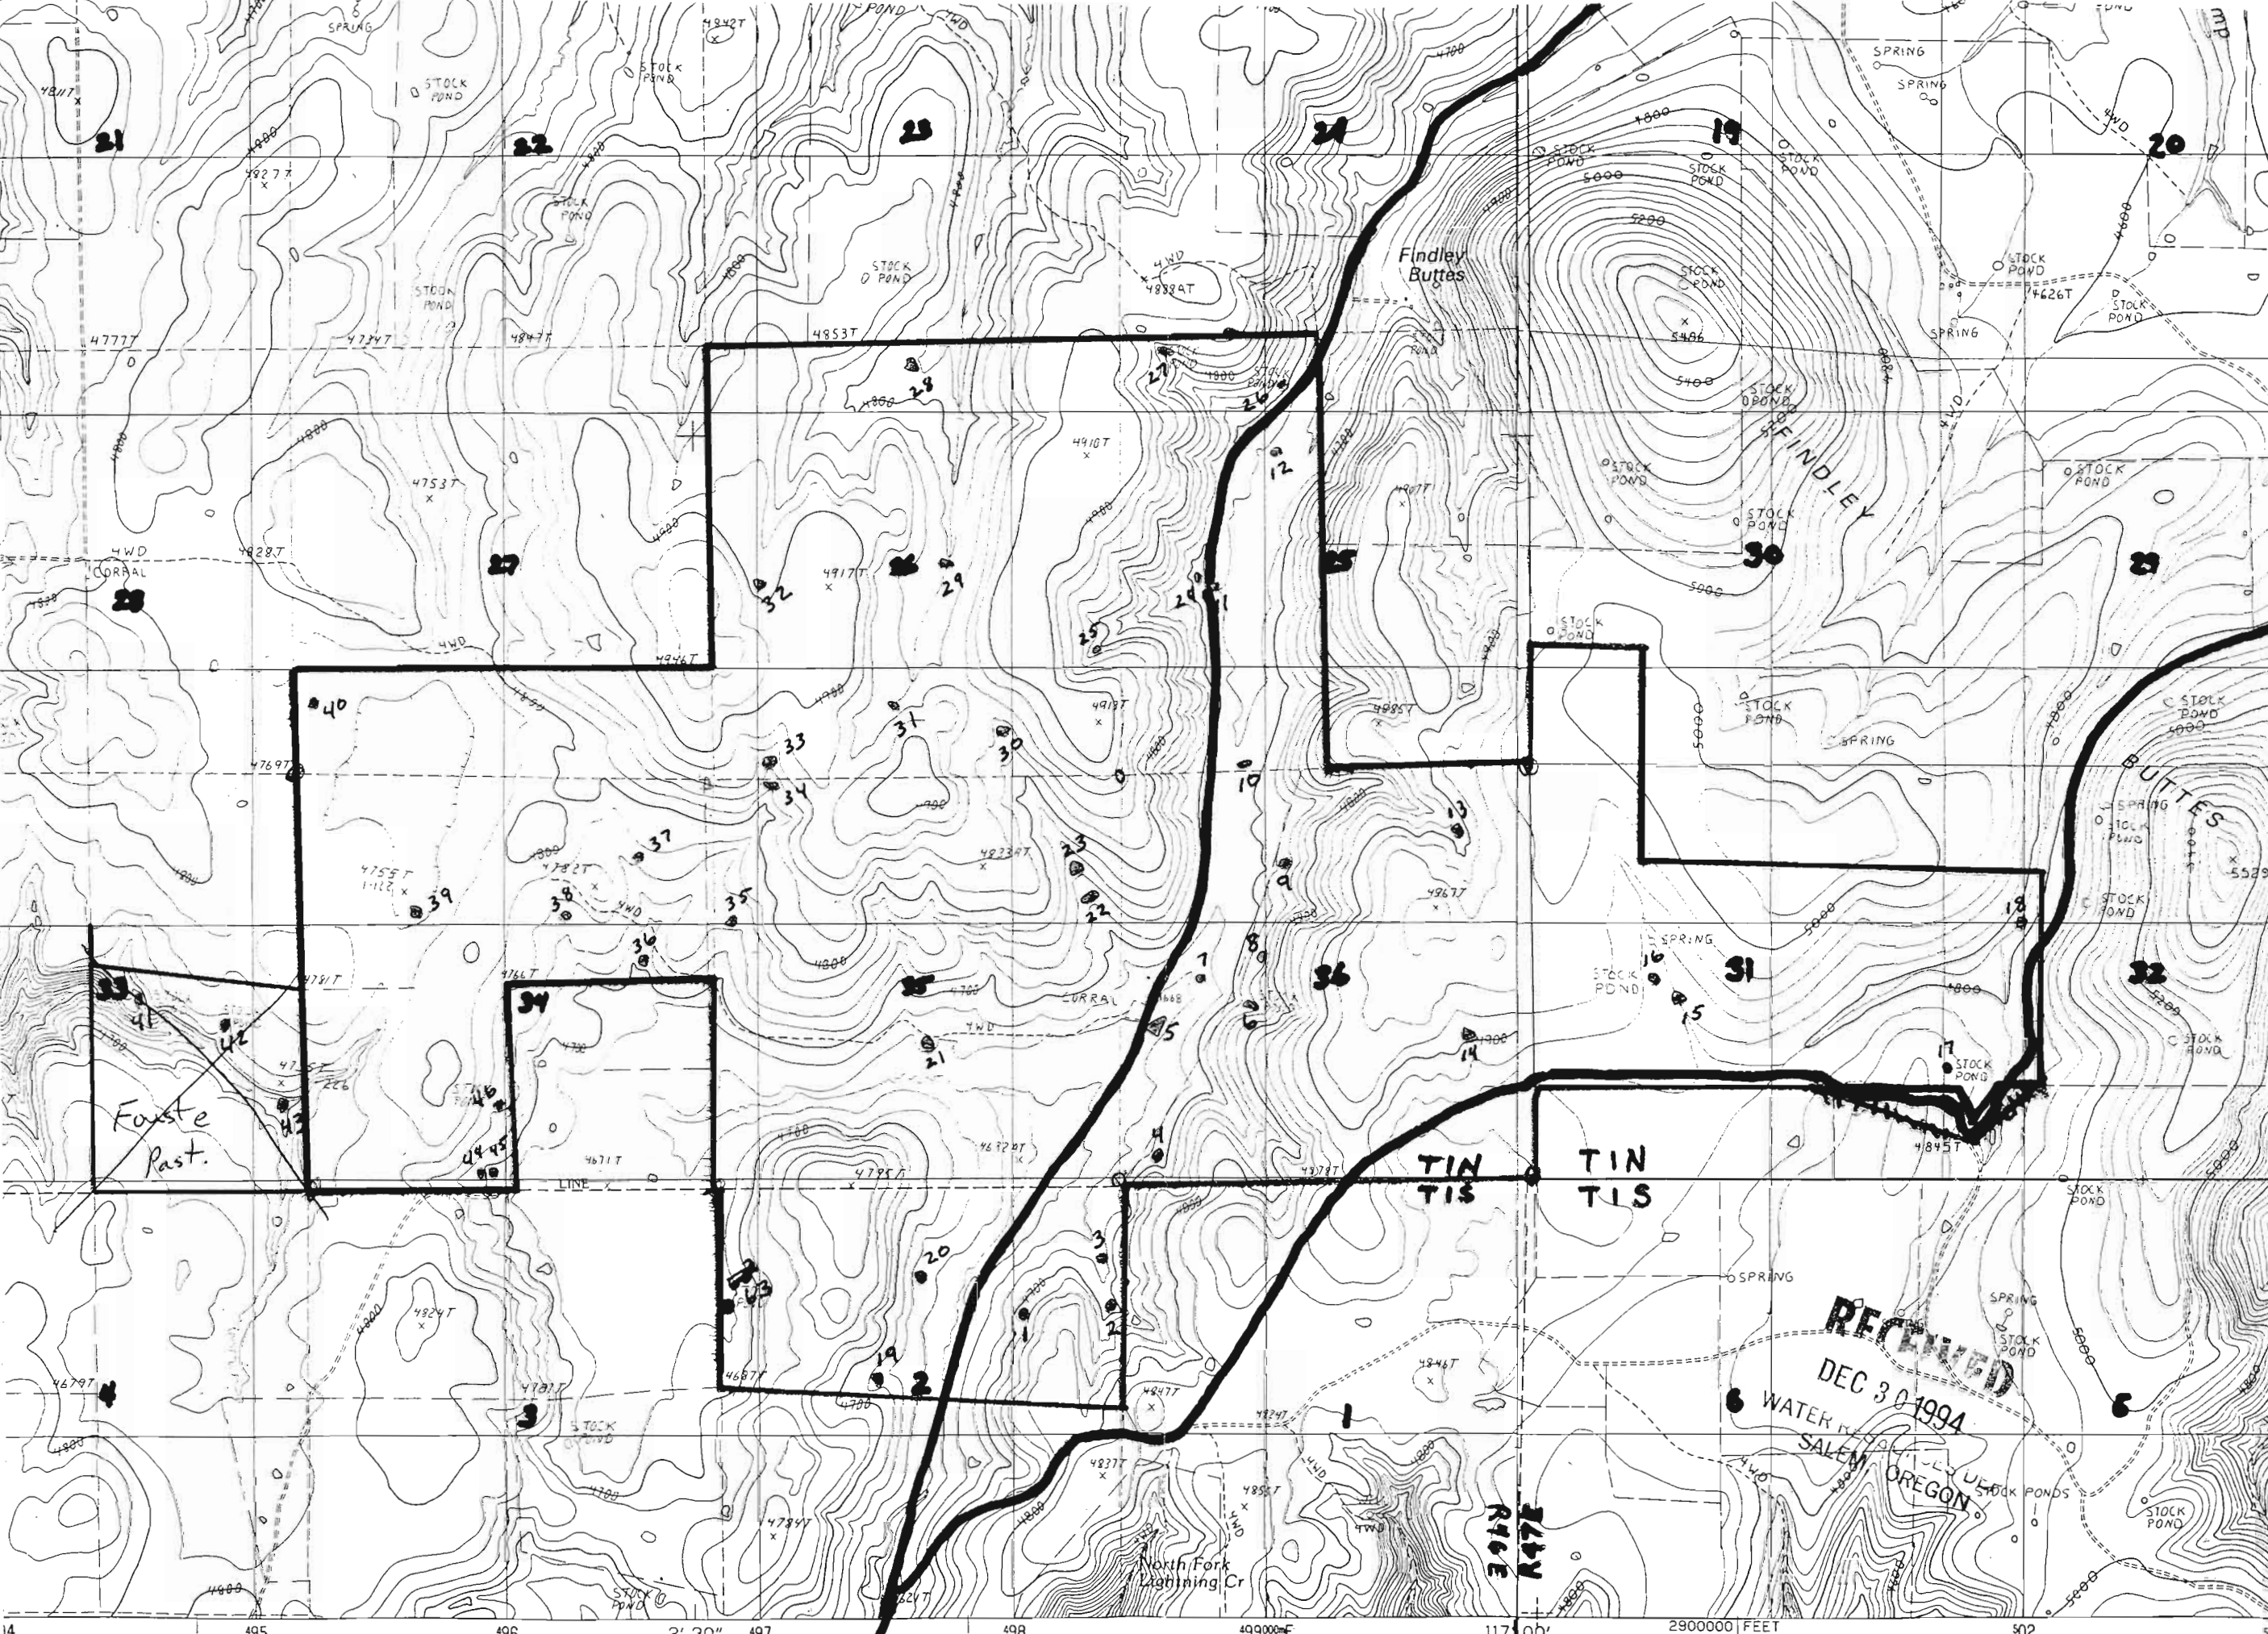

SCALE 1:24,000

INTERIOR—GEOLOGICAL SURVEY, RESTON, VIRGINIA—1990

BY THE UNITED STATES GEOLOGICAL SURVEY