


No Final Proof Map available

No Permit Map available

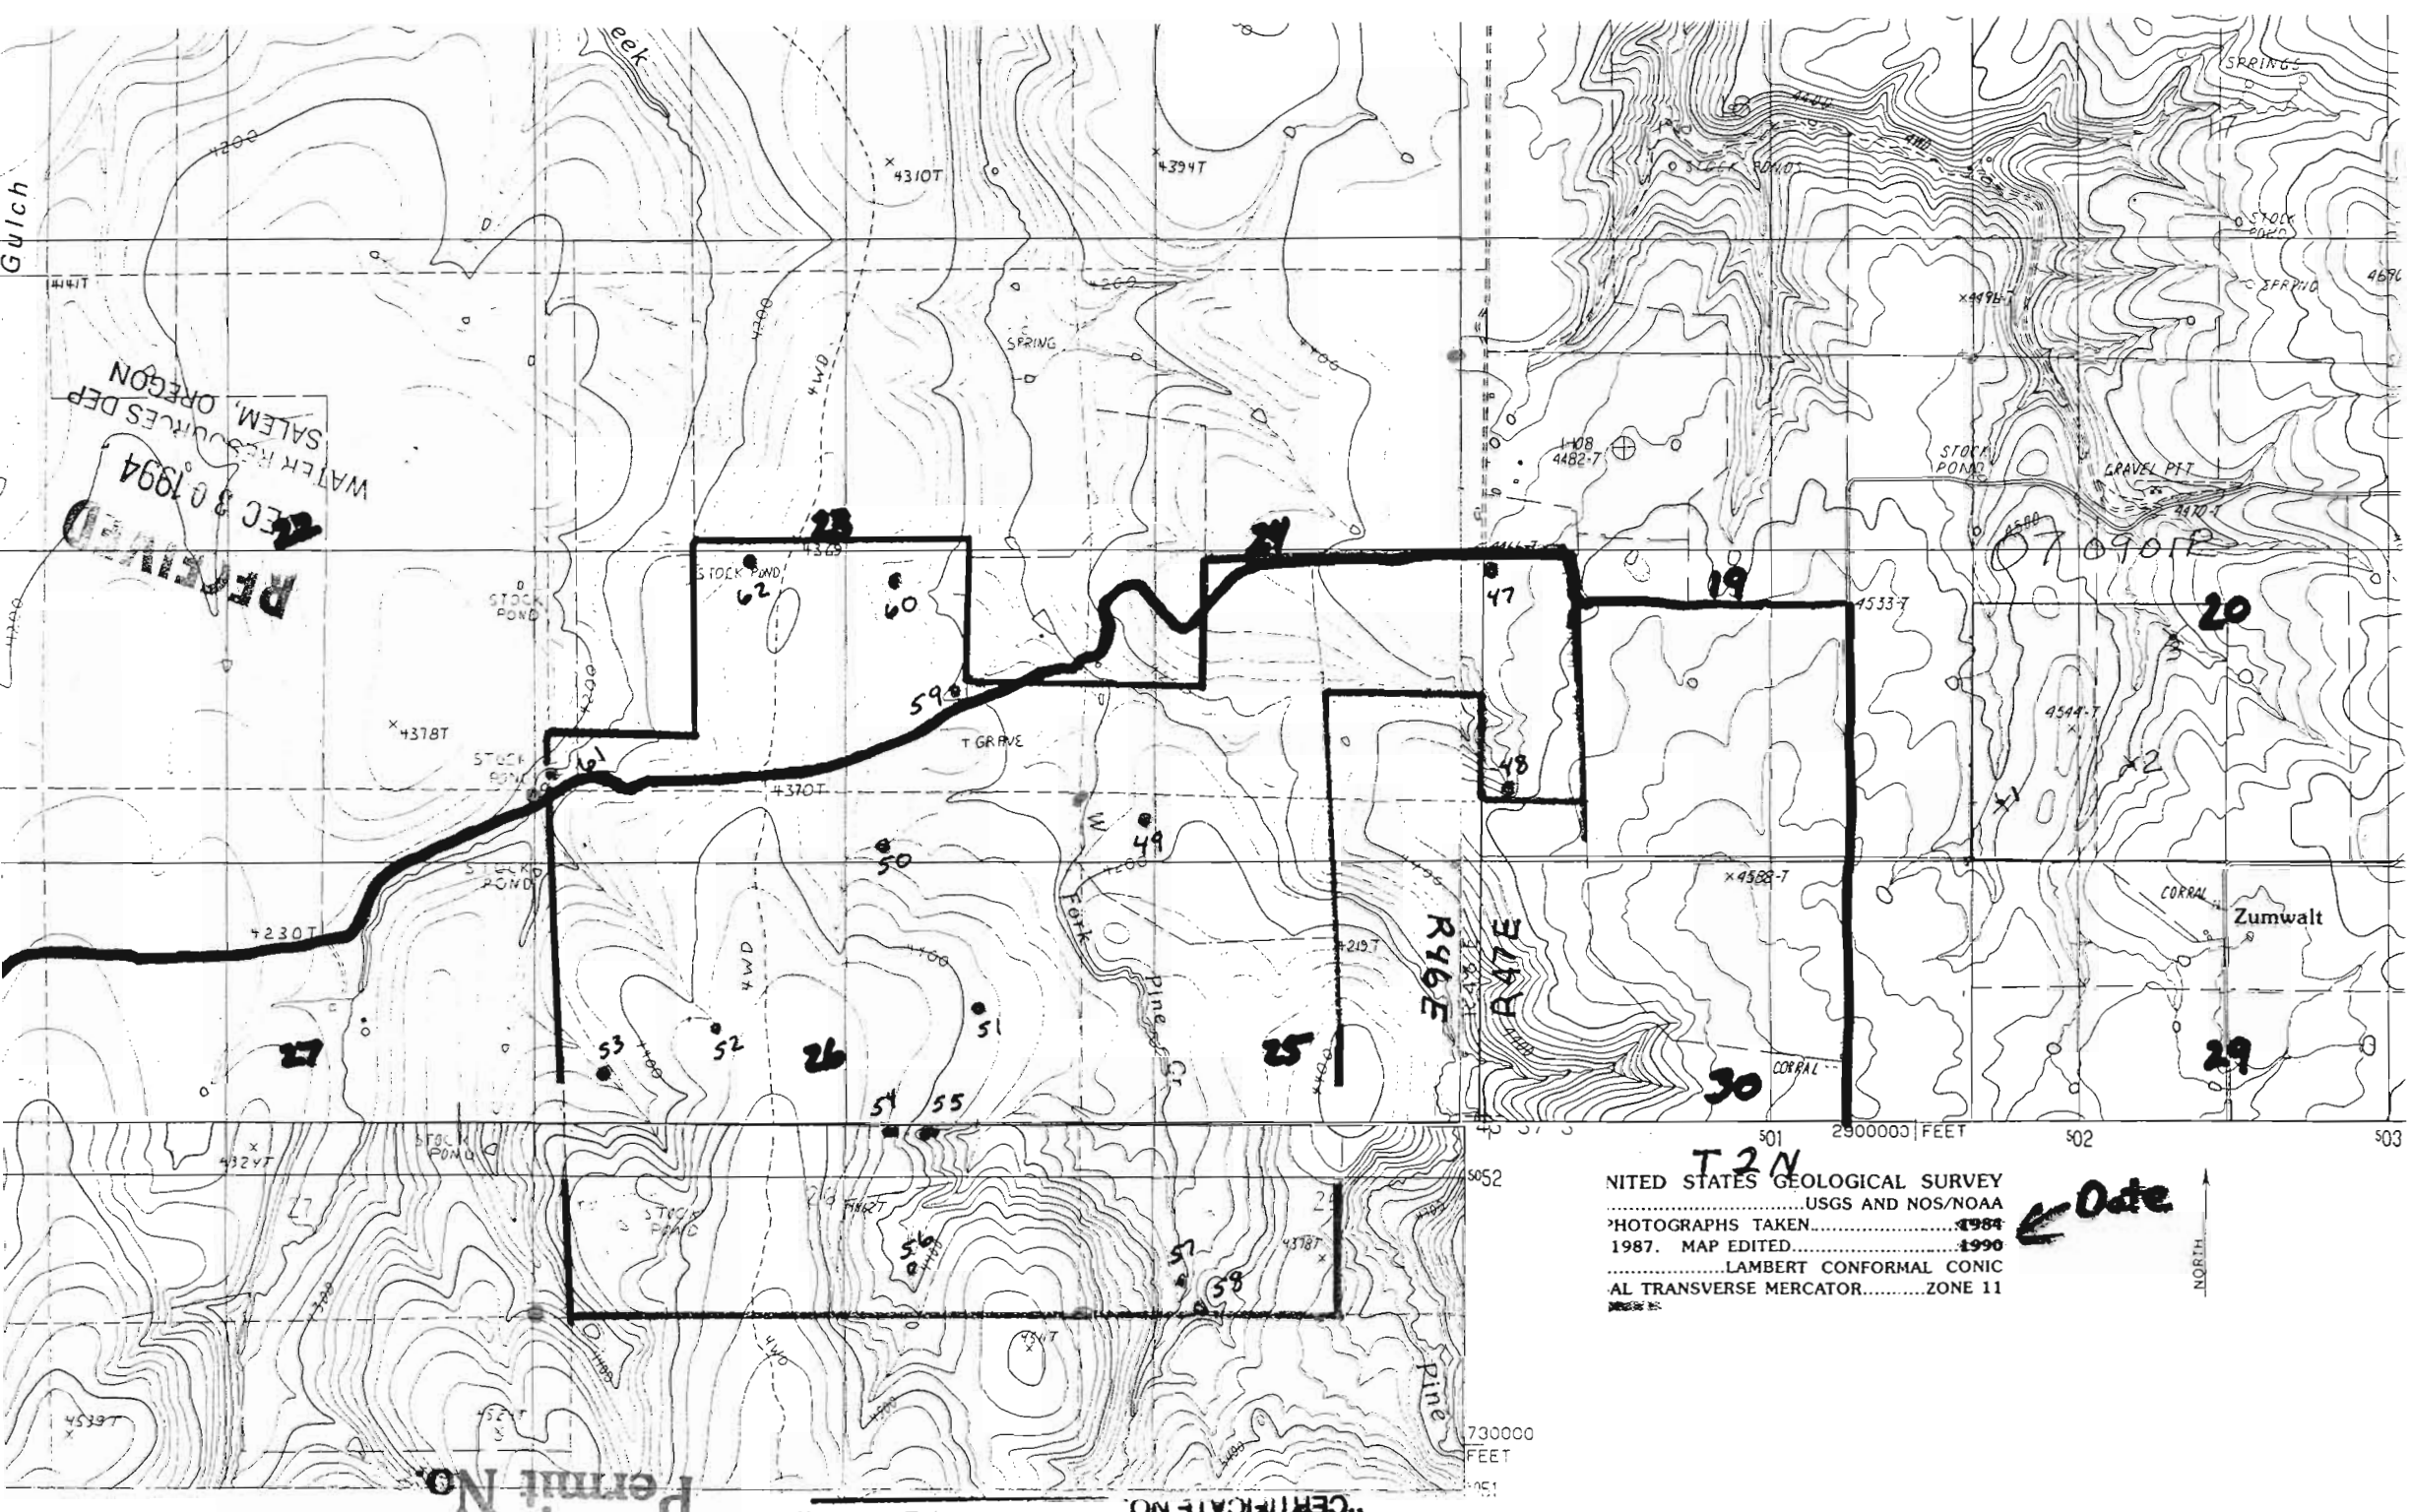

RECEIVED
DEC 30 1994
WATER RESOURCES DEPT
SALEM, OREGON

Permit No.

CERTIFICATE NO.

T 2 N
UNITED STATES GEOLOGICAL SURVEY
USGS AND NOS/NOAA
PHOTOGRAPHS TAKEN 1984
1987. MAP EDITED 1990
LAMBERT CONFORMAL CONIC
AL TRANSVERSE MERCATOR...ZONE 11

← Date

NORTH