


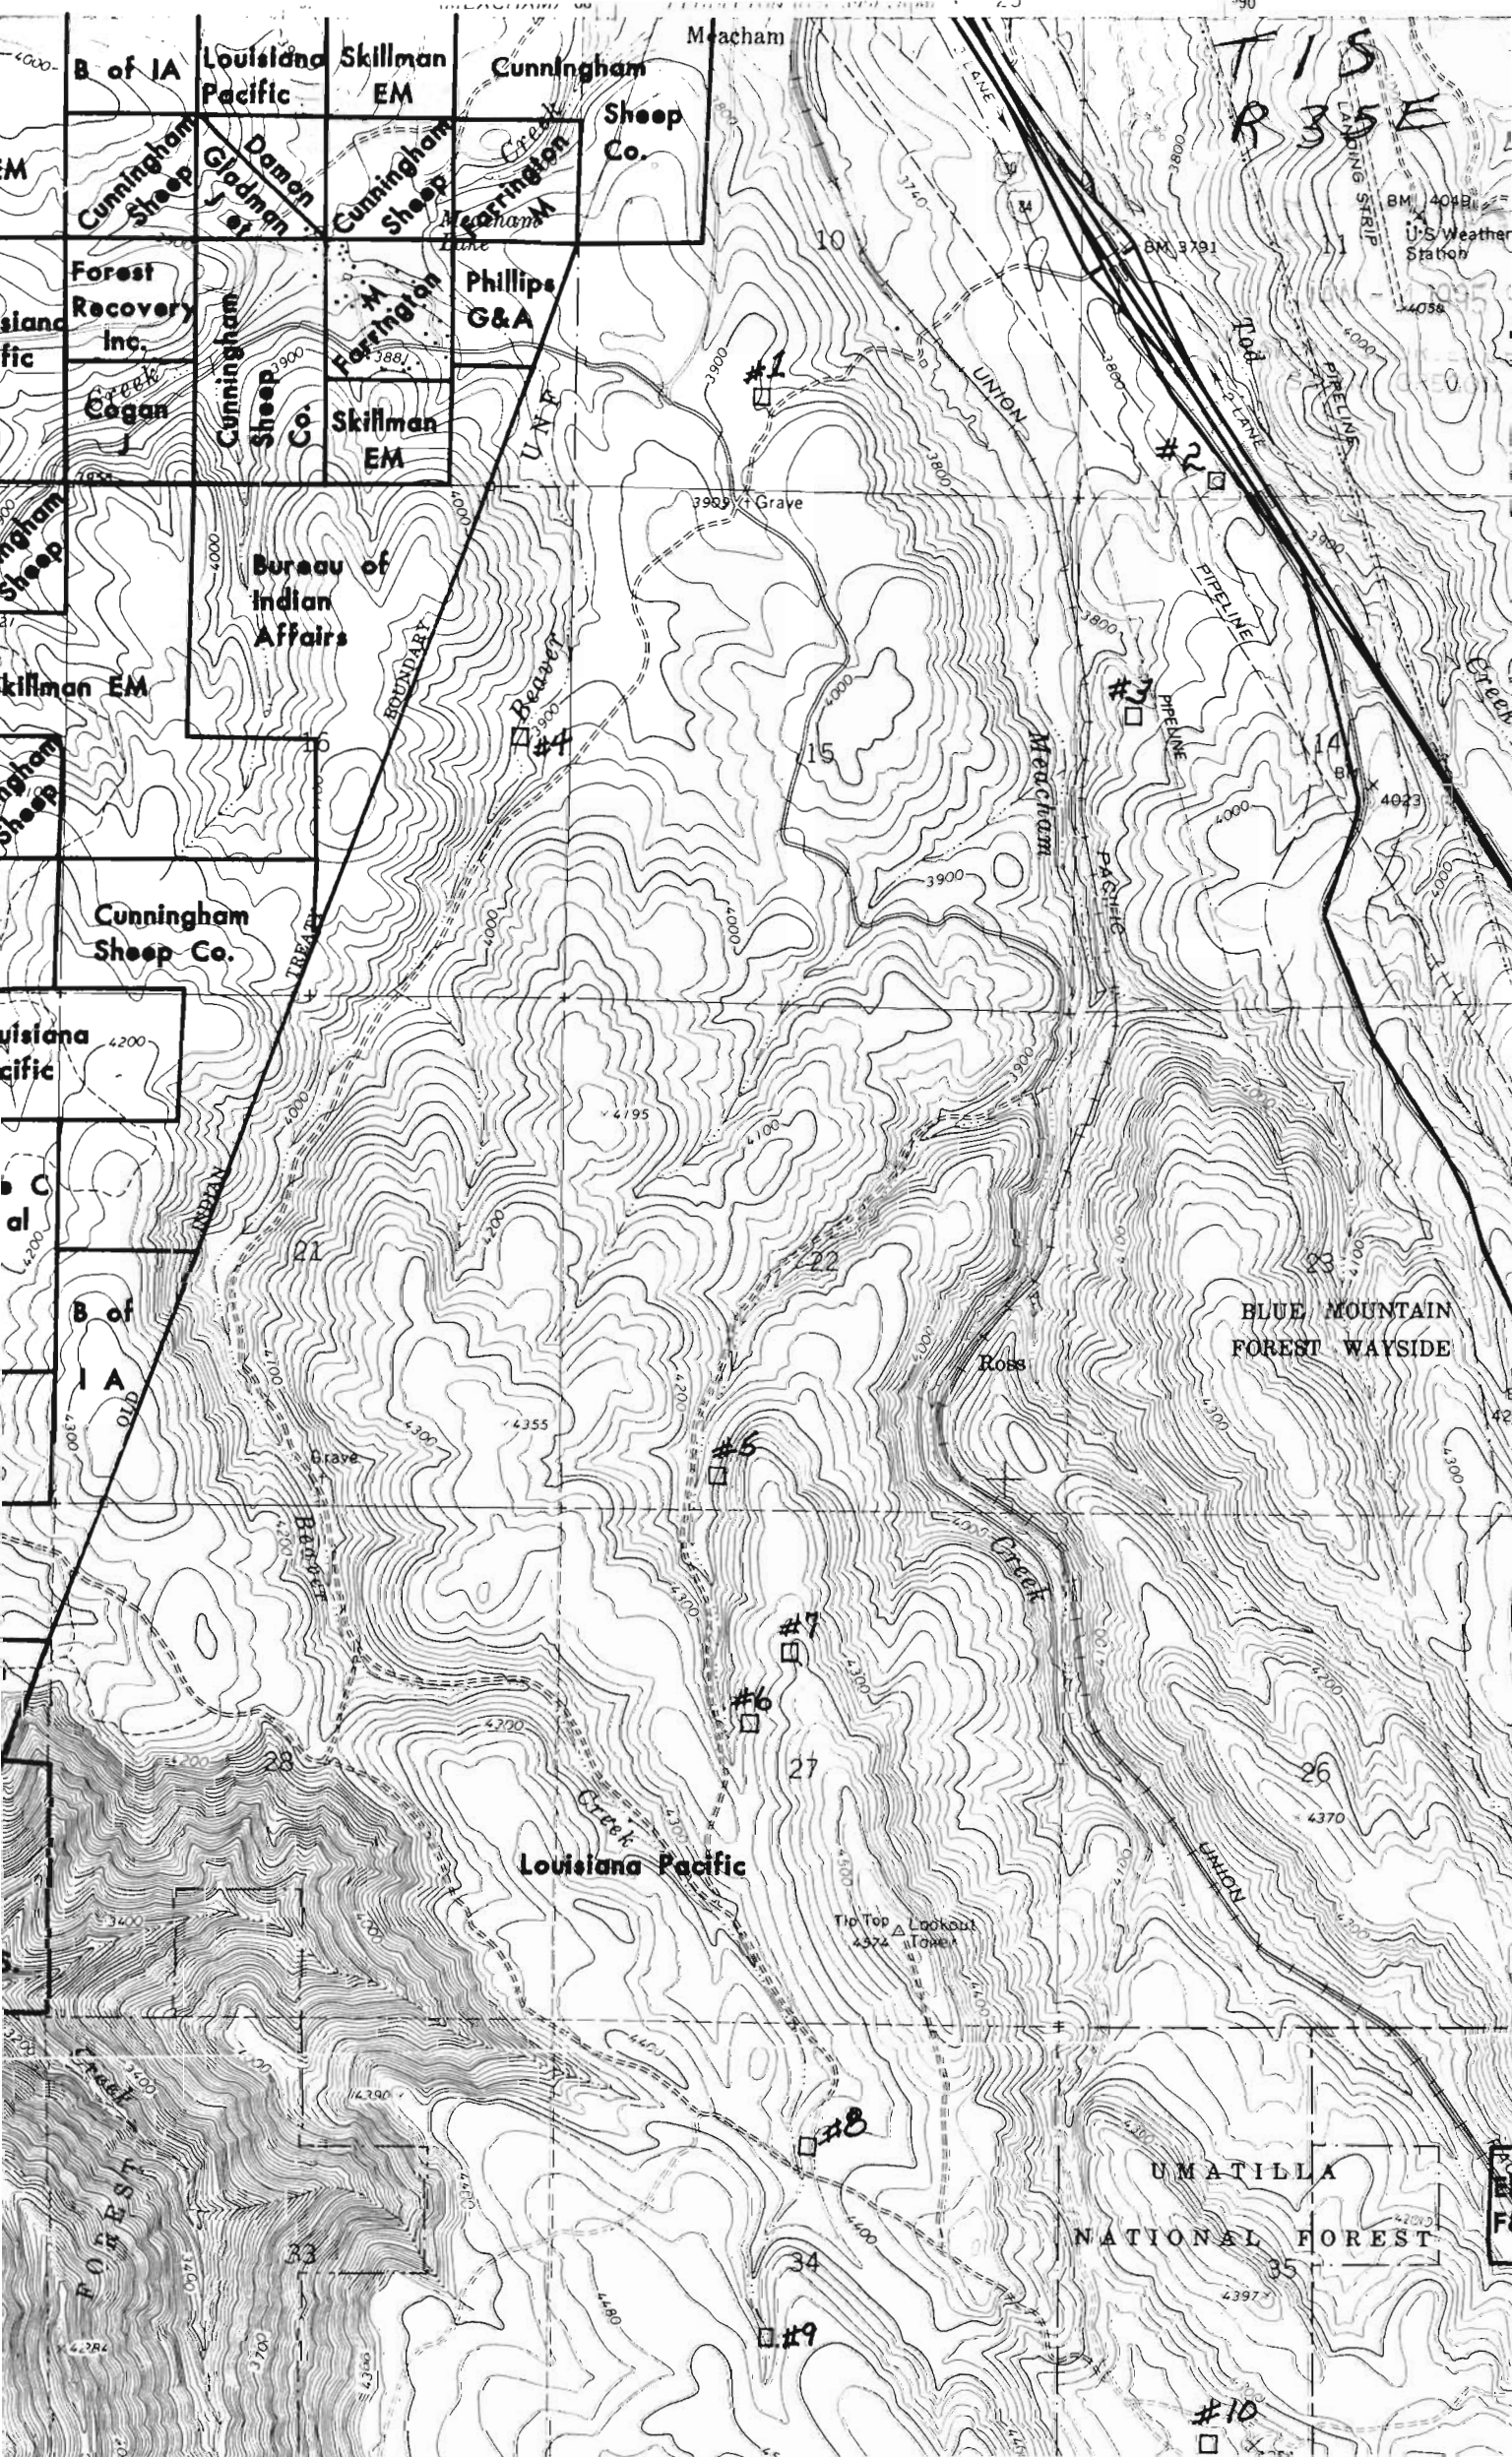

No Final Proof Map available

No Permit Map available