

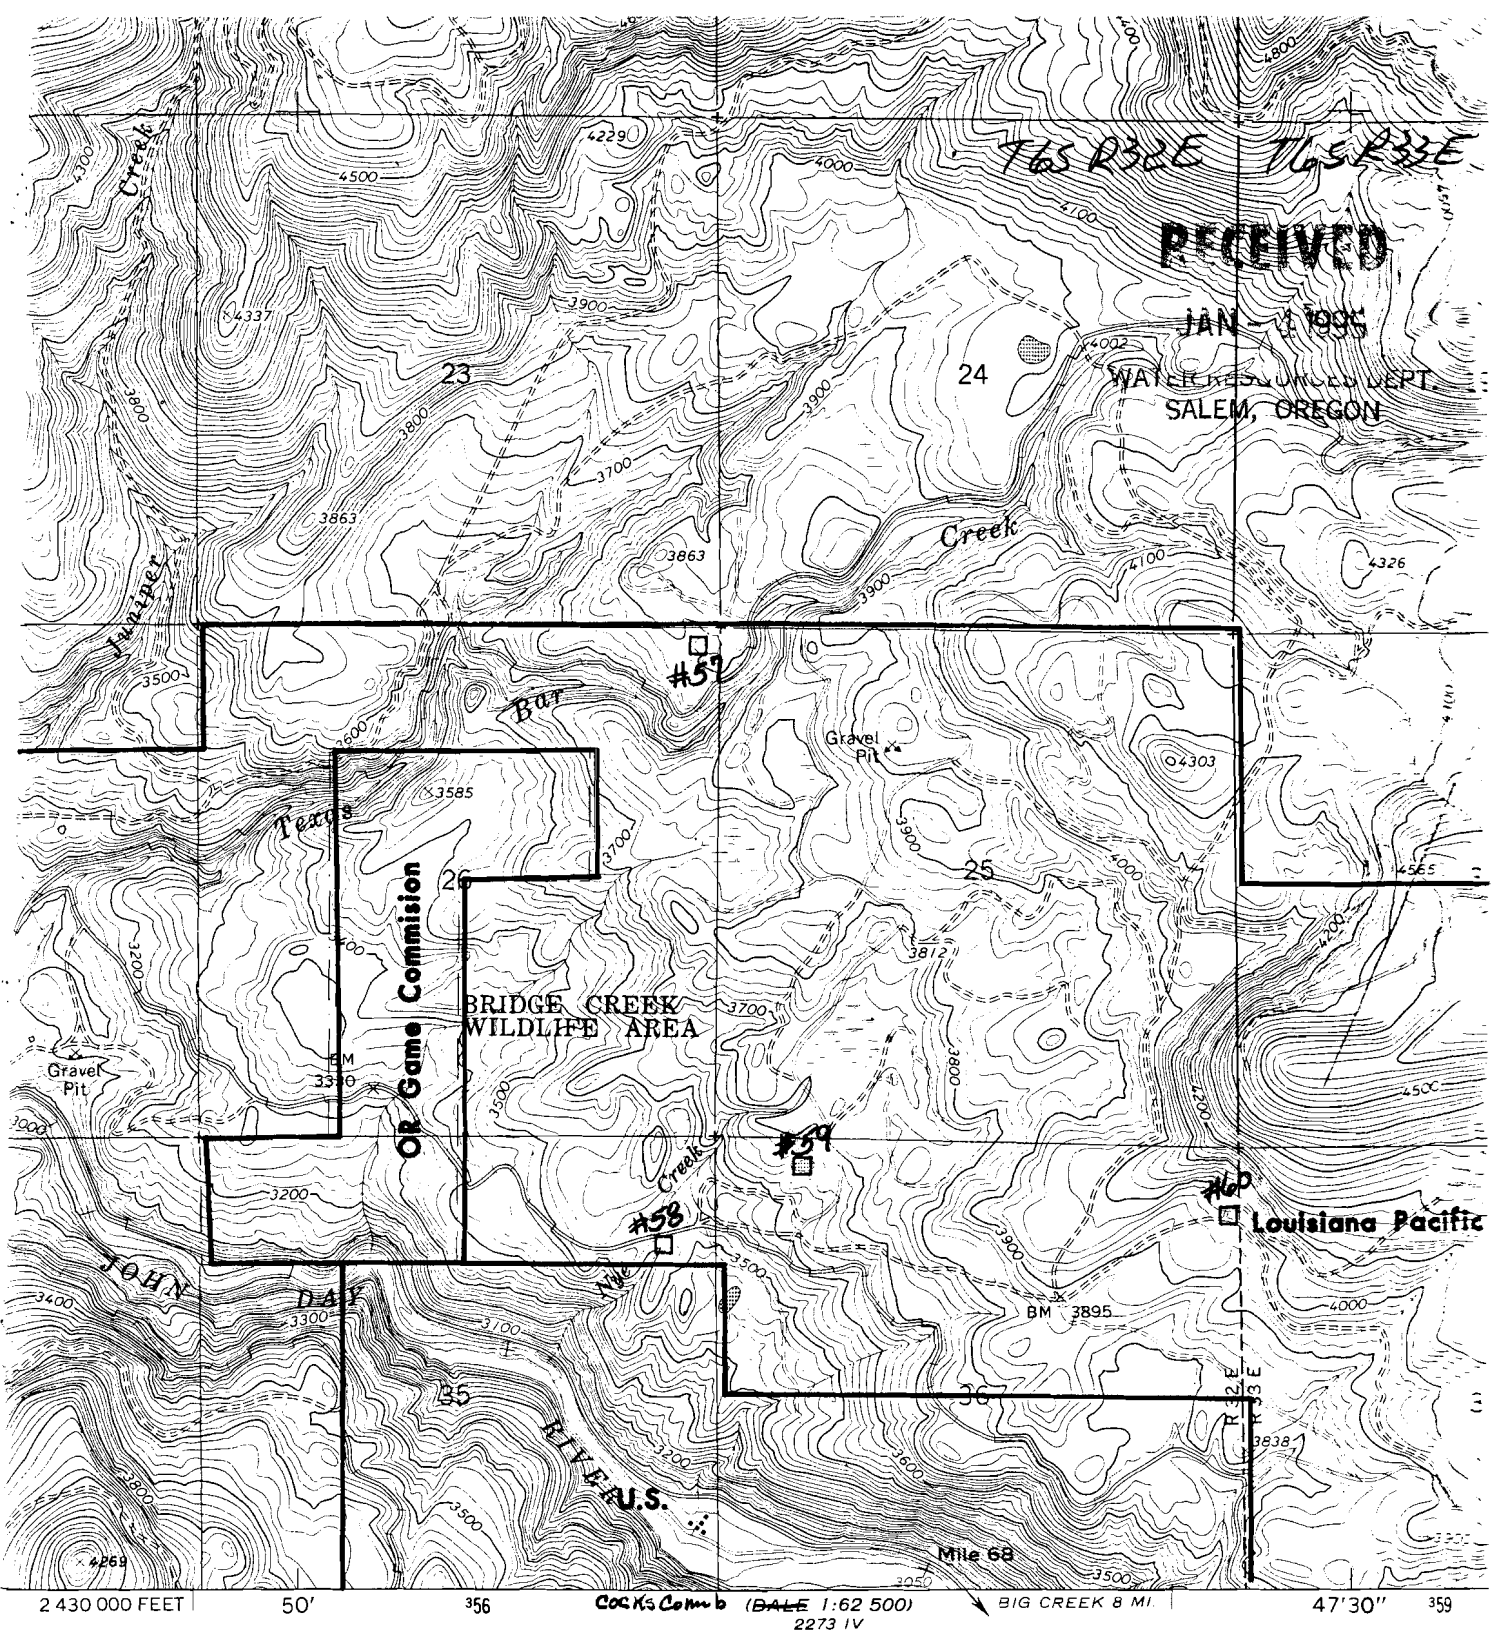


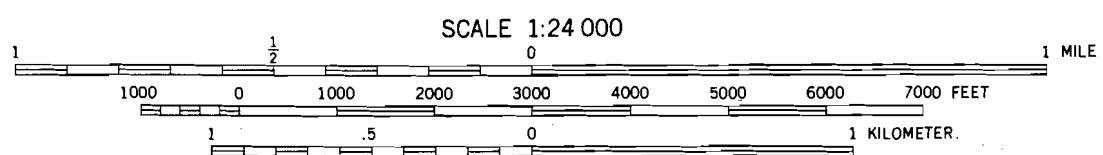

T65 R32E T65 R33E
RECEIVED
JAN - 1 1995
WATER RESOURCES DEPT.
SALEM, OREGON

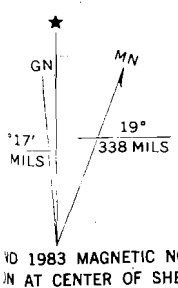

CONTOUR INTERVAL 20 FEET
NATIONAL GEODETIC VERTICAL DATUM OF 1929

1983 MAGNETIC NORTH
IN AT CENTER OF SHEET

Application No. R-77227
Permit No.

THIS MAP COMPLIES WITH NATIONAL MAP ACCURACY STANDARDS
FOR SALE BY U. S. GEOLOGICAL SURVEY, DENVER, COLORADO 80225, OR RESTON, VIRGINIA 22092
A FOLDER DESCRIBING TOPOGRAPHIC MAPS AND SYMBOLS IS AVAILABLE ON REQUEST

Re: 3
aer 3
Part 3

No Final Proof Map available

No Permit Map available