


Application No. R-77228
Permit No.

"CERTIFICATE NO."

RECEIVED

JAN - 4 1995

WATER RESOURCES DEPT.
SALEM, OREGON

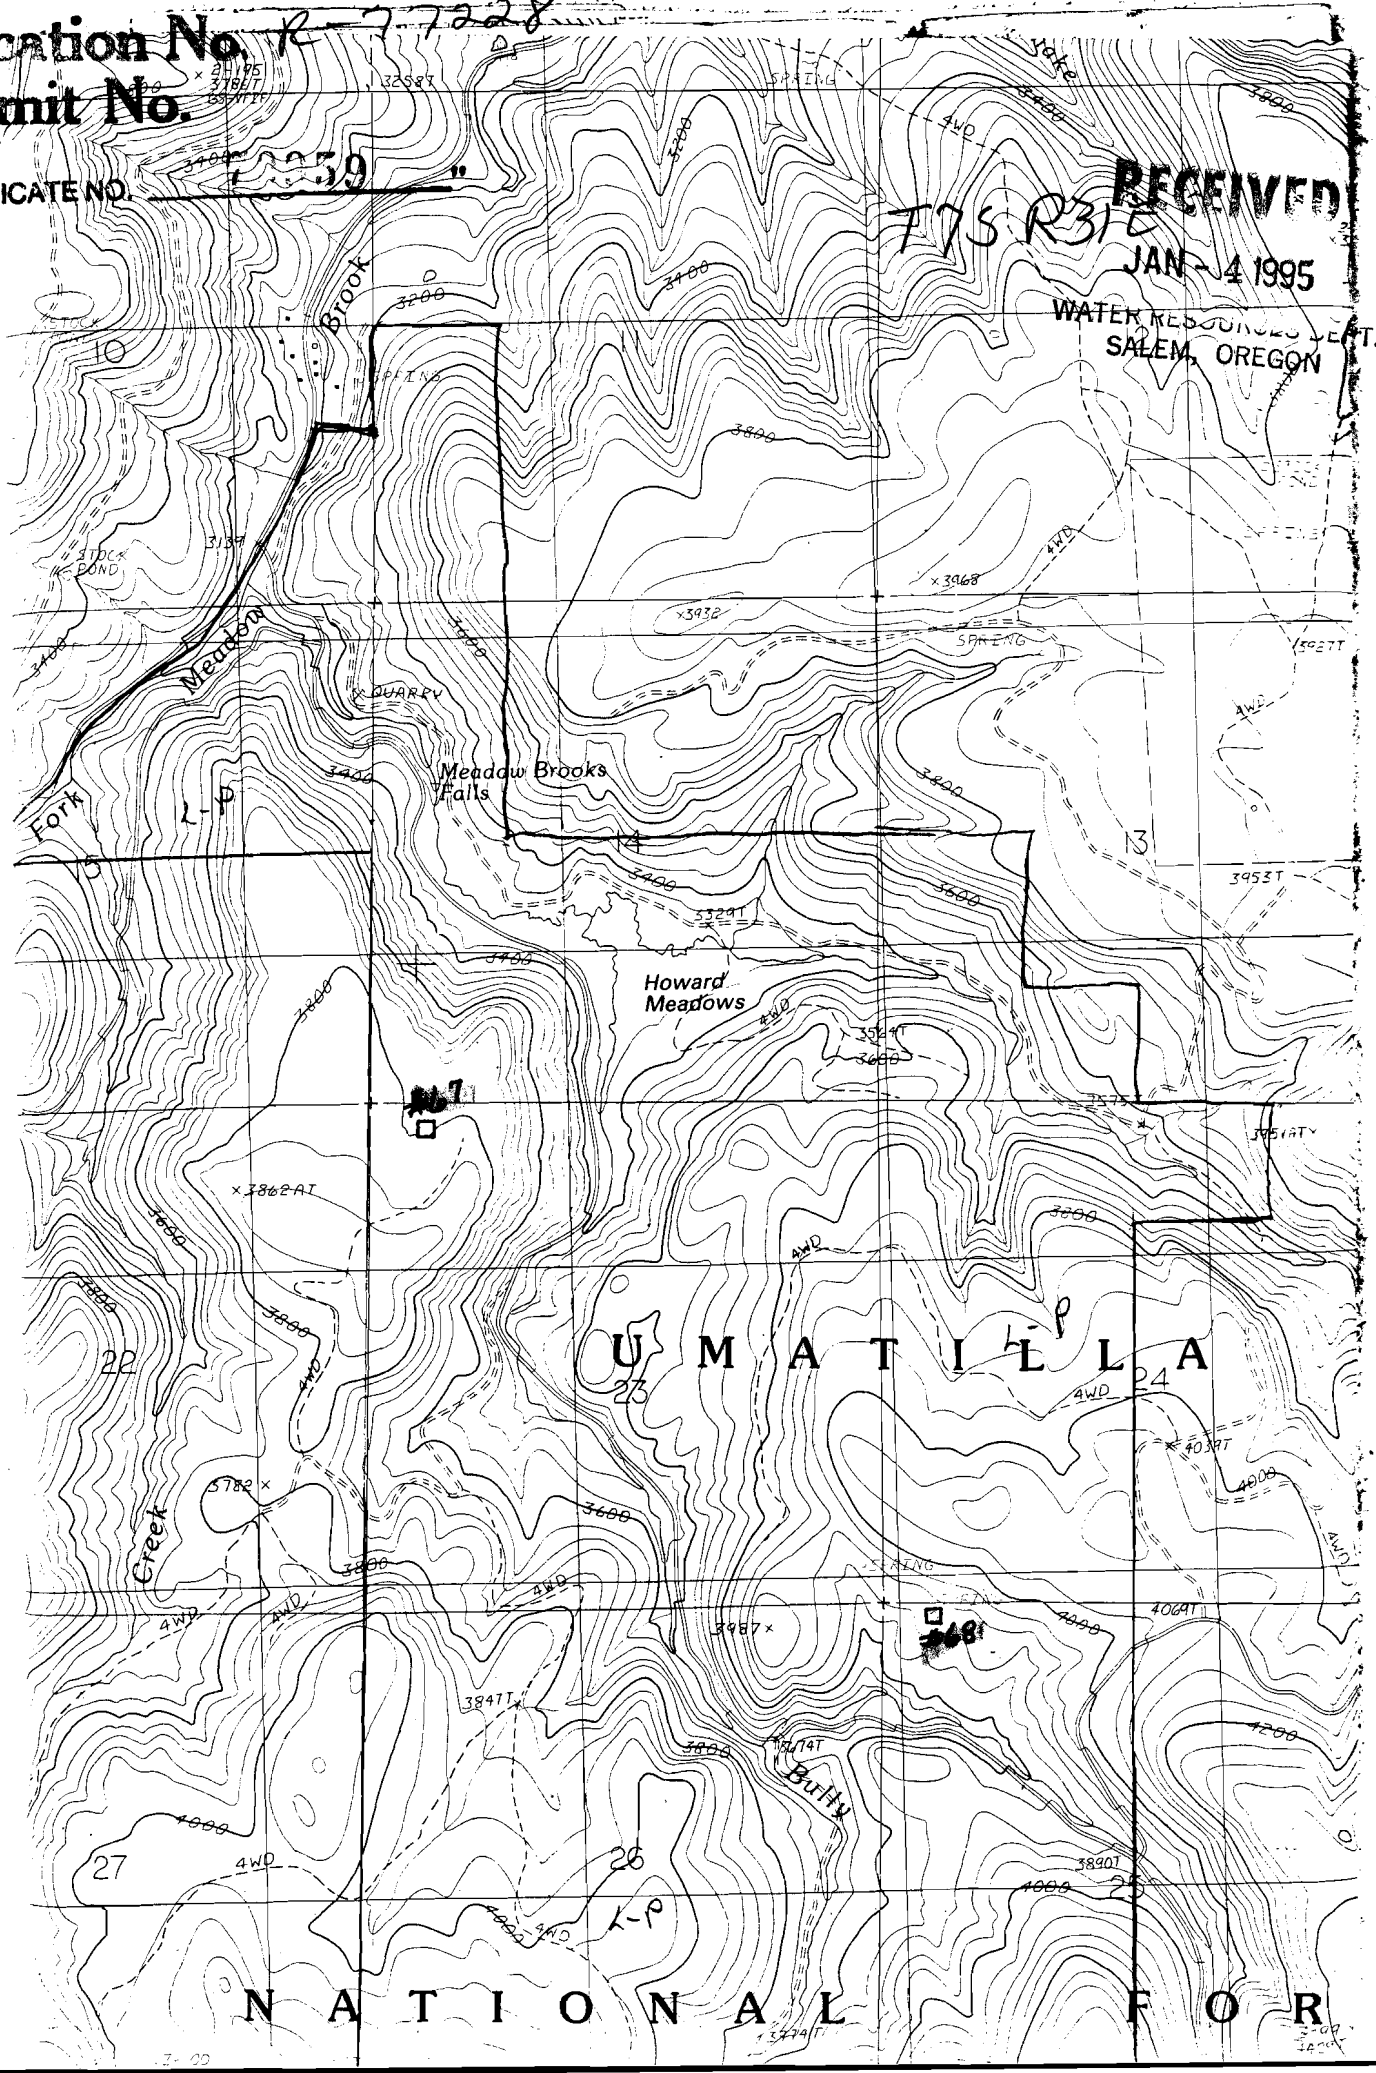

No Final Proof Map available

No Permit Map available