


Application No. R-77230
 Permit No.

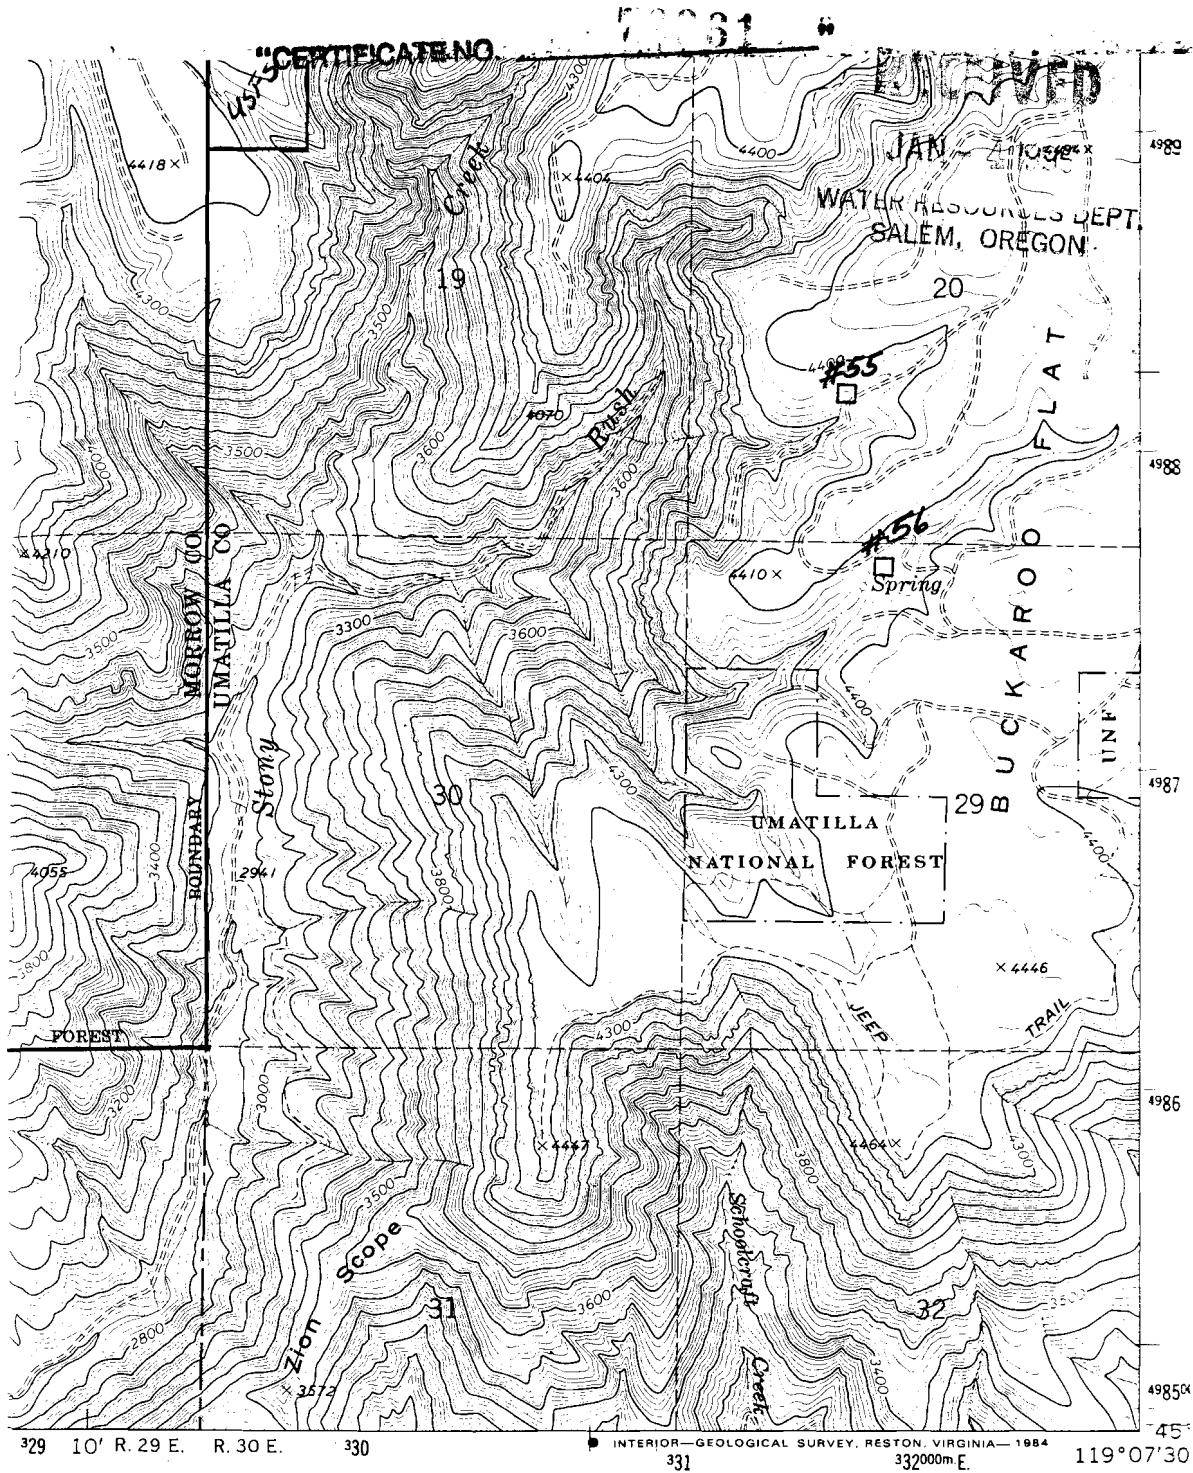

1 MILE



ROAD CLASSIFICATION

Primary highway, hard surface _____ Light-duty road, hard or improved surface _____

Secondary highway, hard surface _____ Unimproved road _____

○ Interstate Route ○ U. S. Route ○ State Route

A 22092


Revisions shown in purple and woodland compiled from aerial photographs taken 1981 and other source data
 Partial field check by U. S. Forest Service. Map edited 1983

THOMPSON FLAT, OREG.
 45119-A2-TF-024

1969
 PHOTOREVISED 1983
 DMA 2174 II SW-SERIES V892

Application No. R-77230
Permit No.

"CERTIFICATE NO."

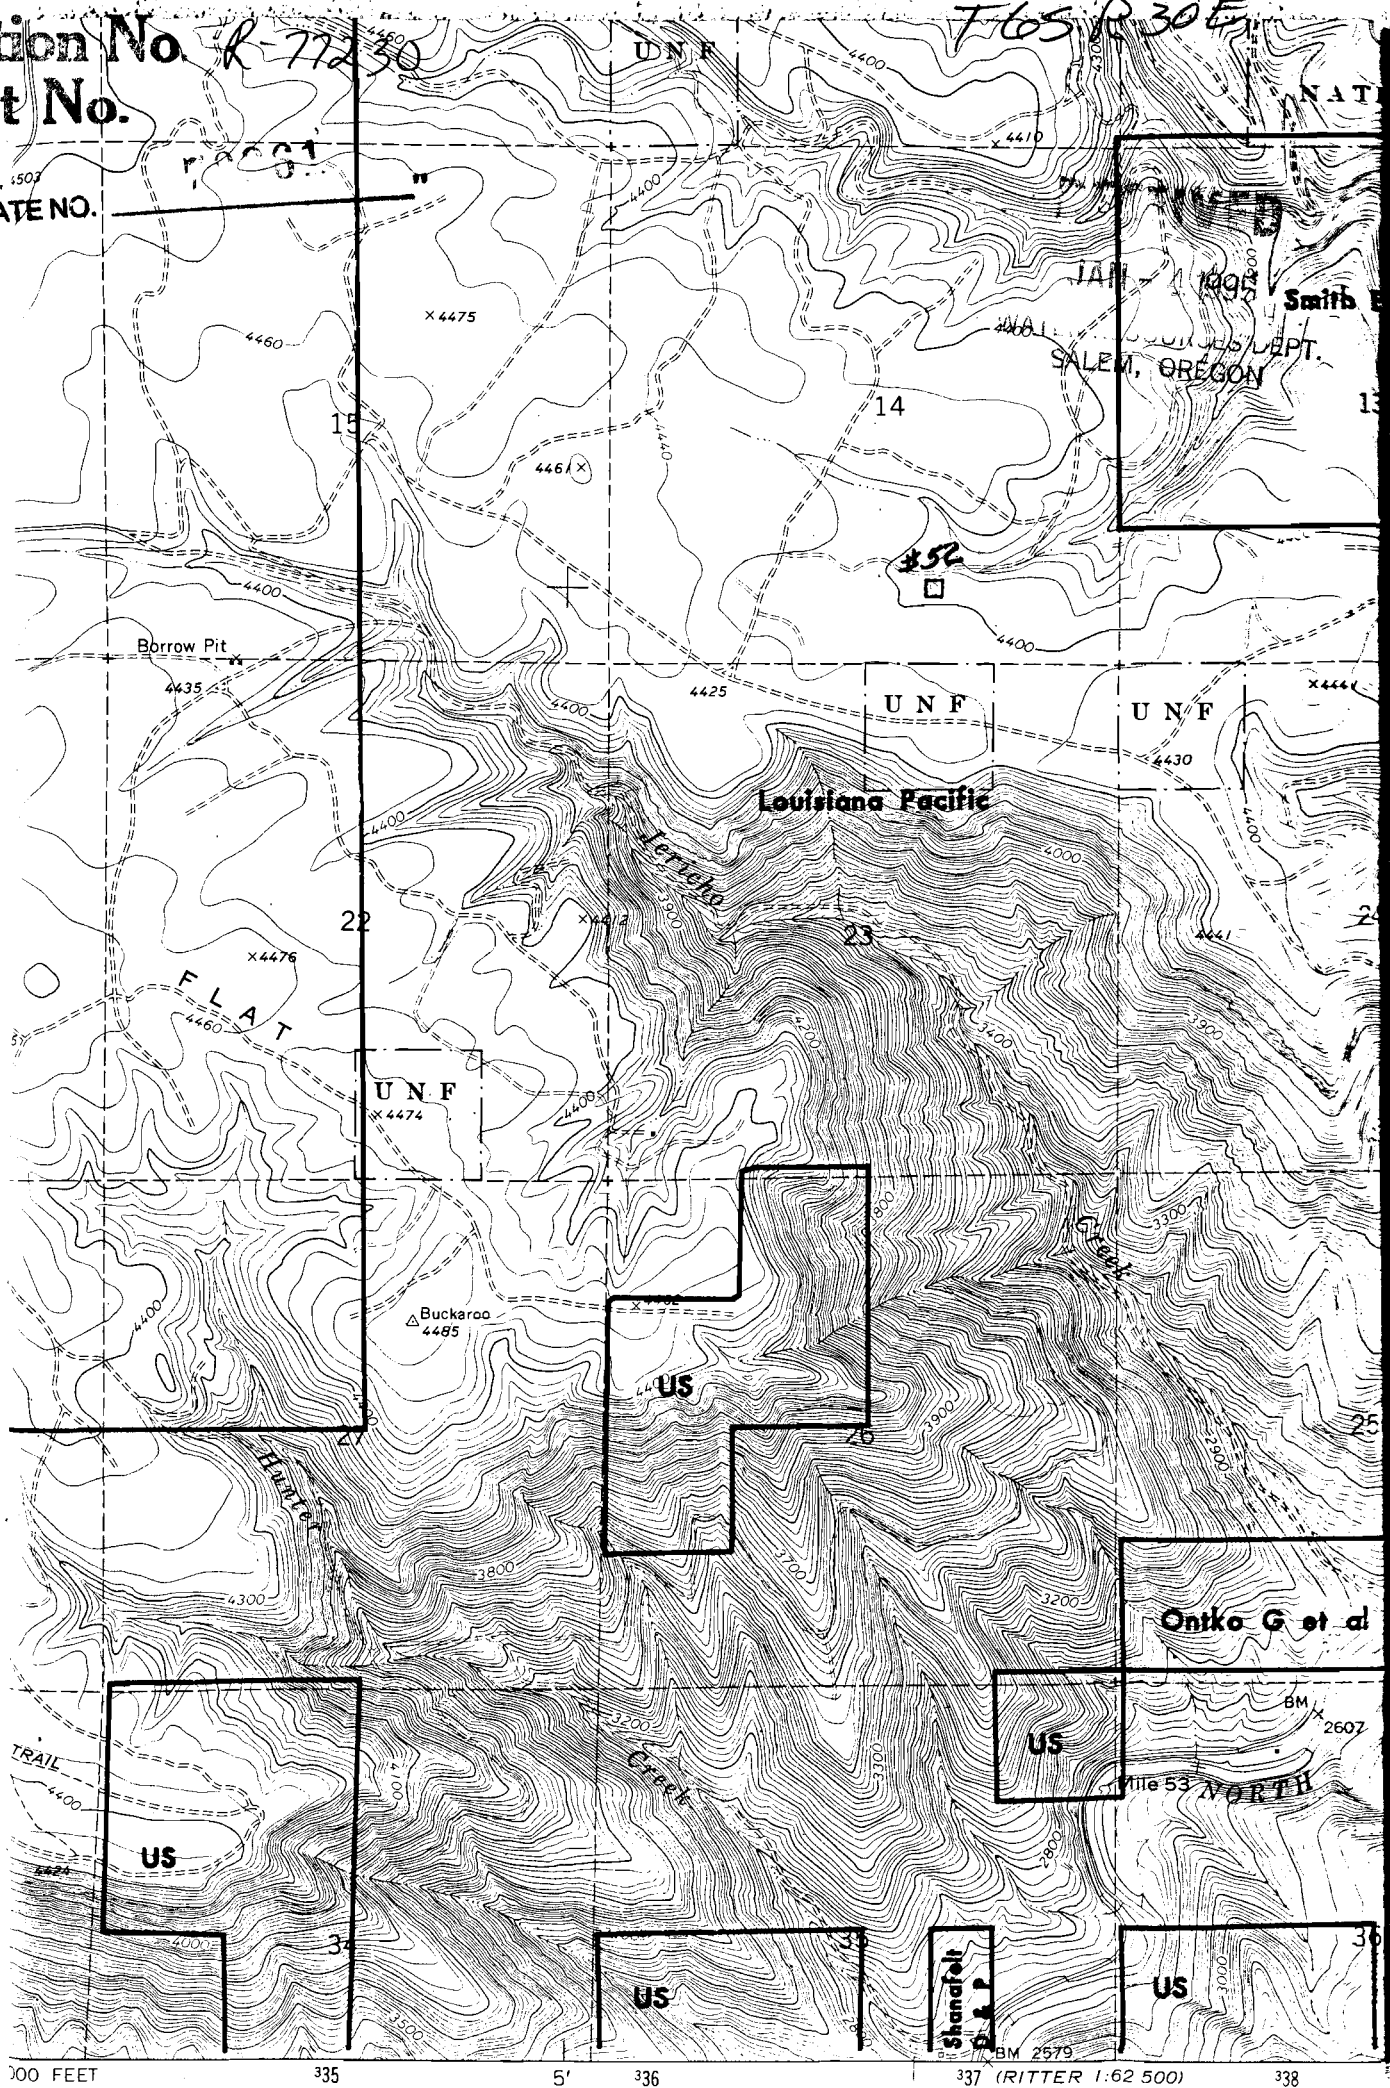

Application No. R-77230
Permit No.


"CERTIFICATE NO."

7261

RECEIVED

JAN - 4 1995

WATER RESOURCES DEPT.
SALEM, OREGON

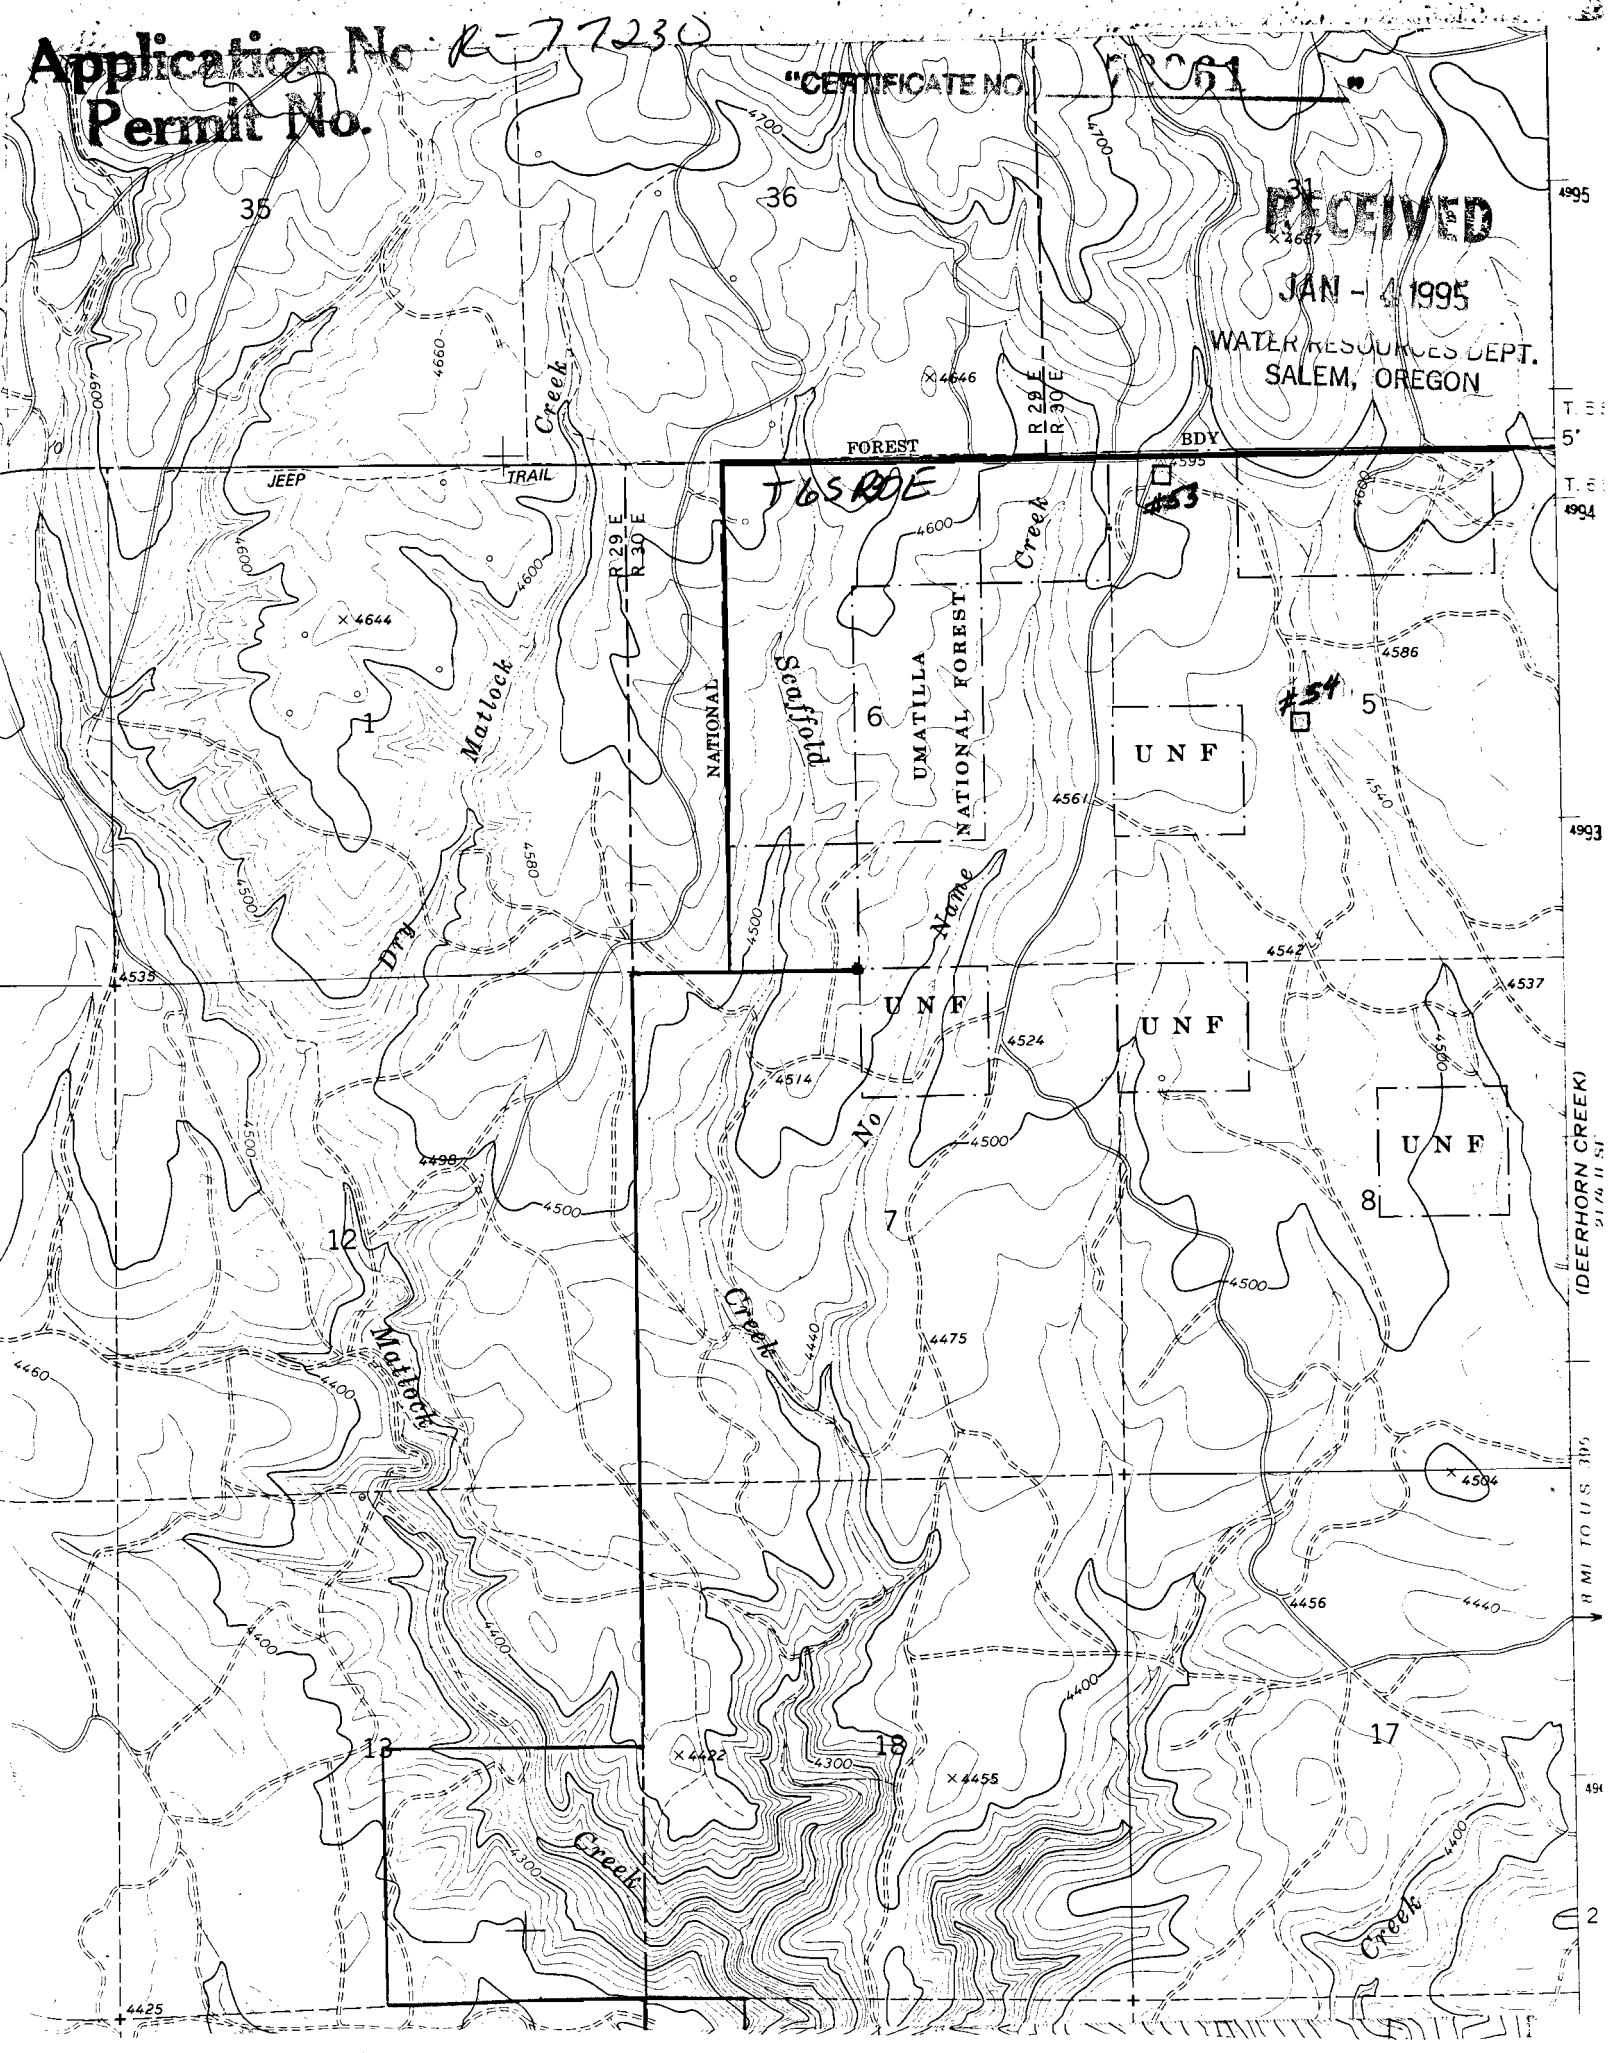

No Final Proof Map available

No Permit Map available