

CERTIFICATE NO.

JAN - 4 1906


WATER RESOURCES DEPT.
SALEM, OREGON



RECEIVED

WATER RESOURCES DEPT.
SALEM, OREGON

11

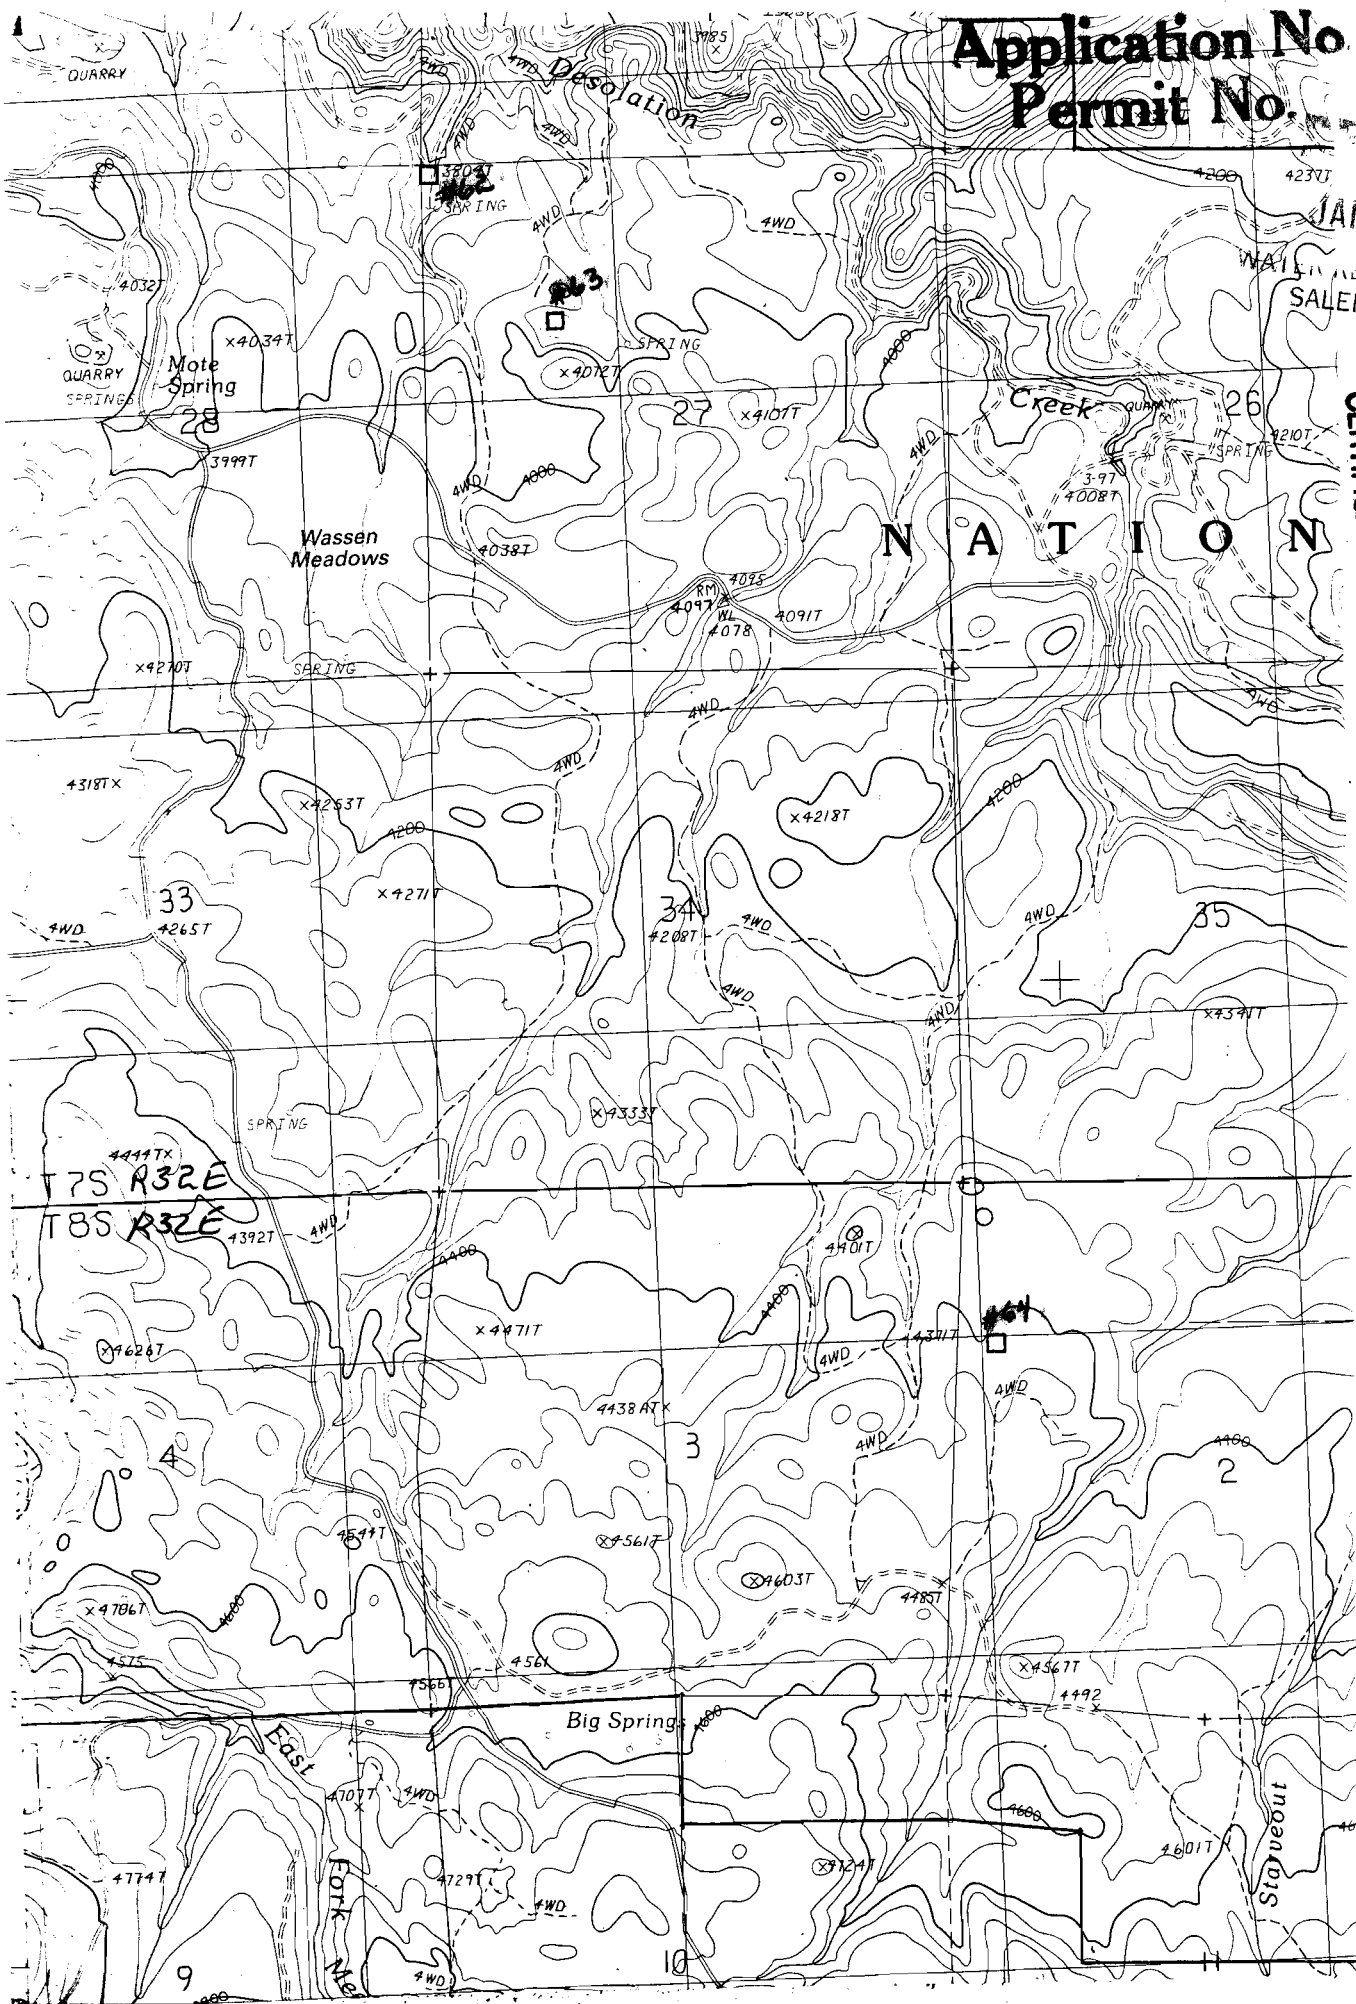

No Final Proof Map available

No Permit Map available