


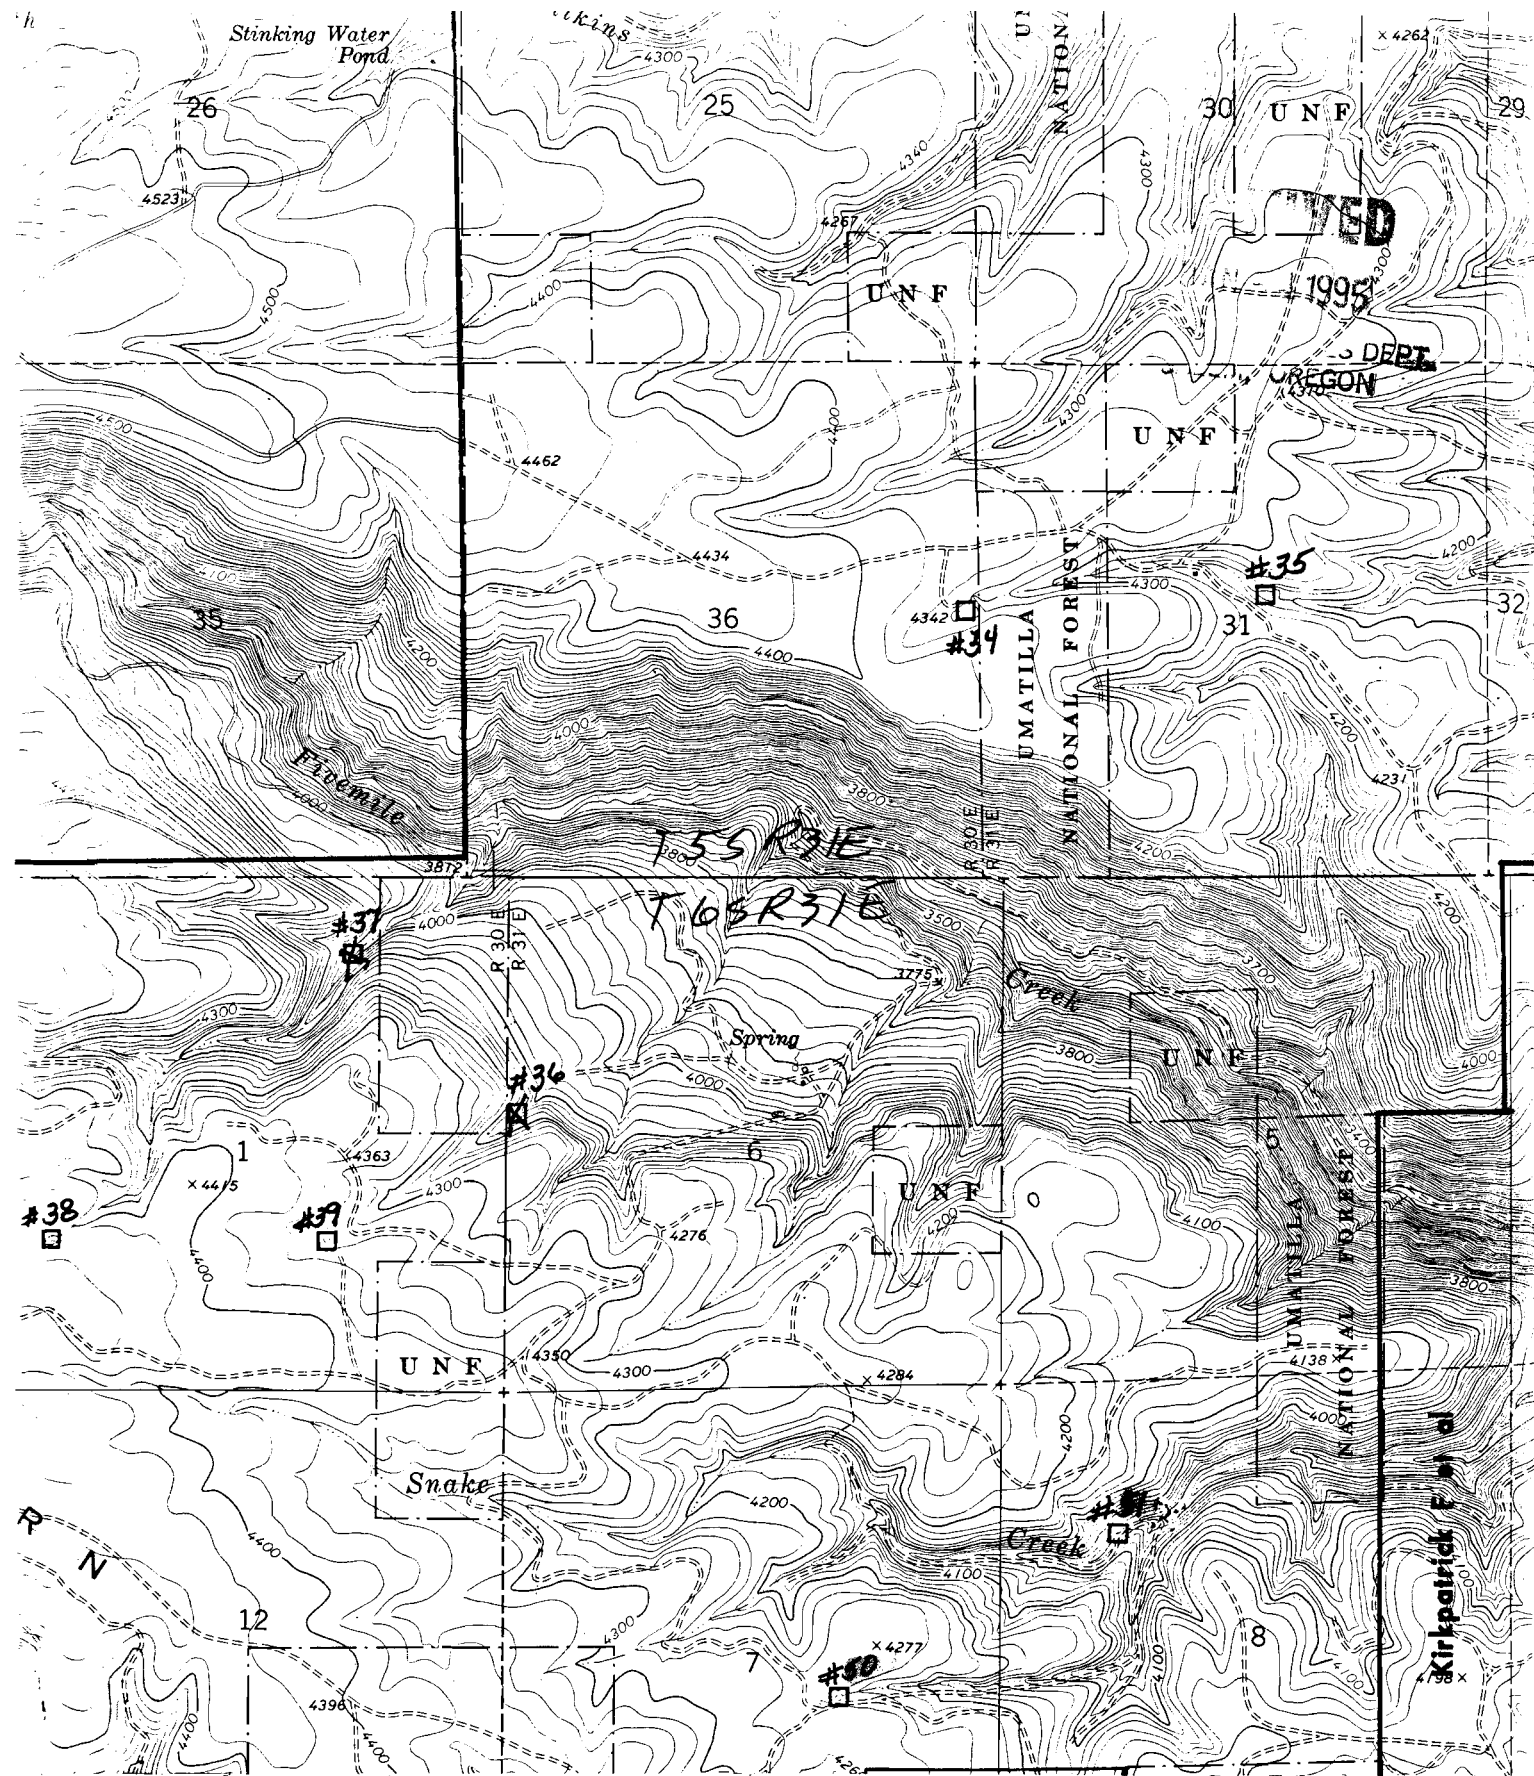

Application No. K-77232
Permit No.

"CERTIFICATE NO. 70063"

No Final Proof Map available

No Permit Map available