


Application No. 7723
Permit No. 33

UMATILLA NATIONAL FOREST

T1S R35E
T2S R35E

RECEIVED
JAN 10 1995

"CERTIFICATE NO. 70968"

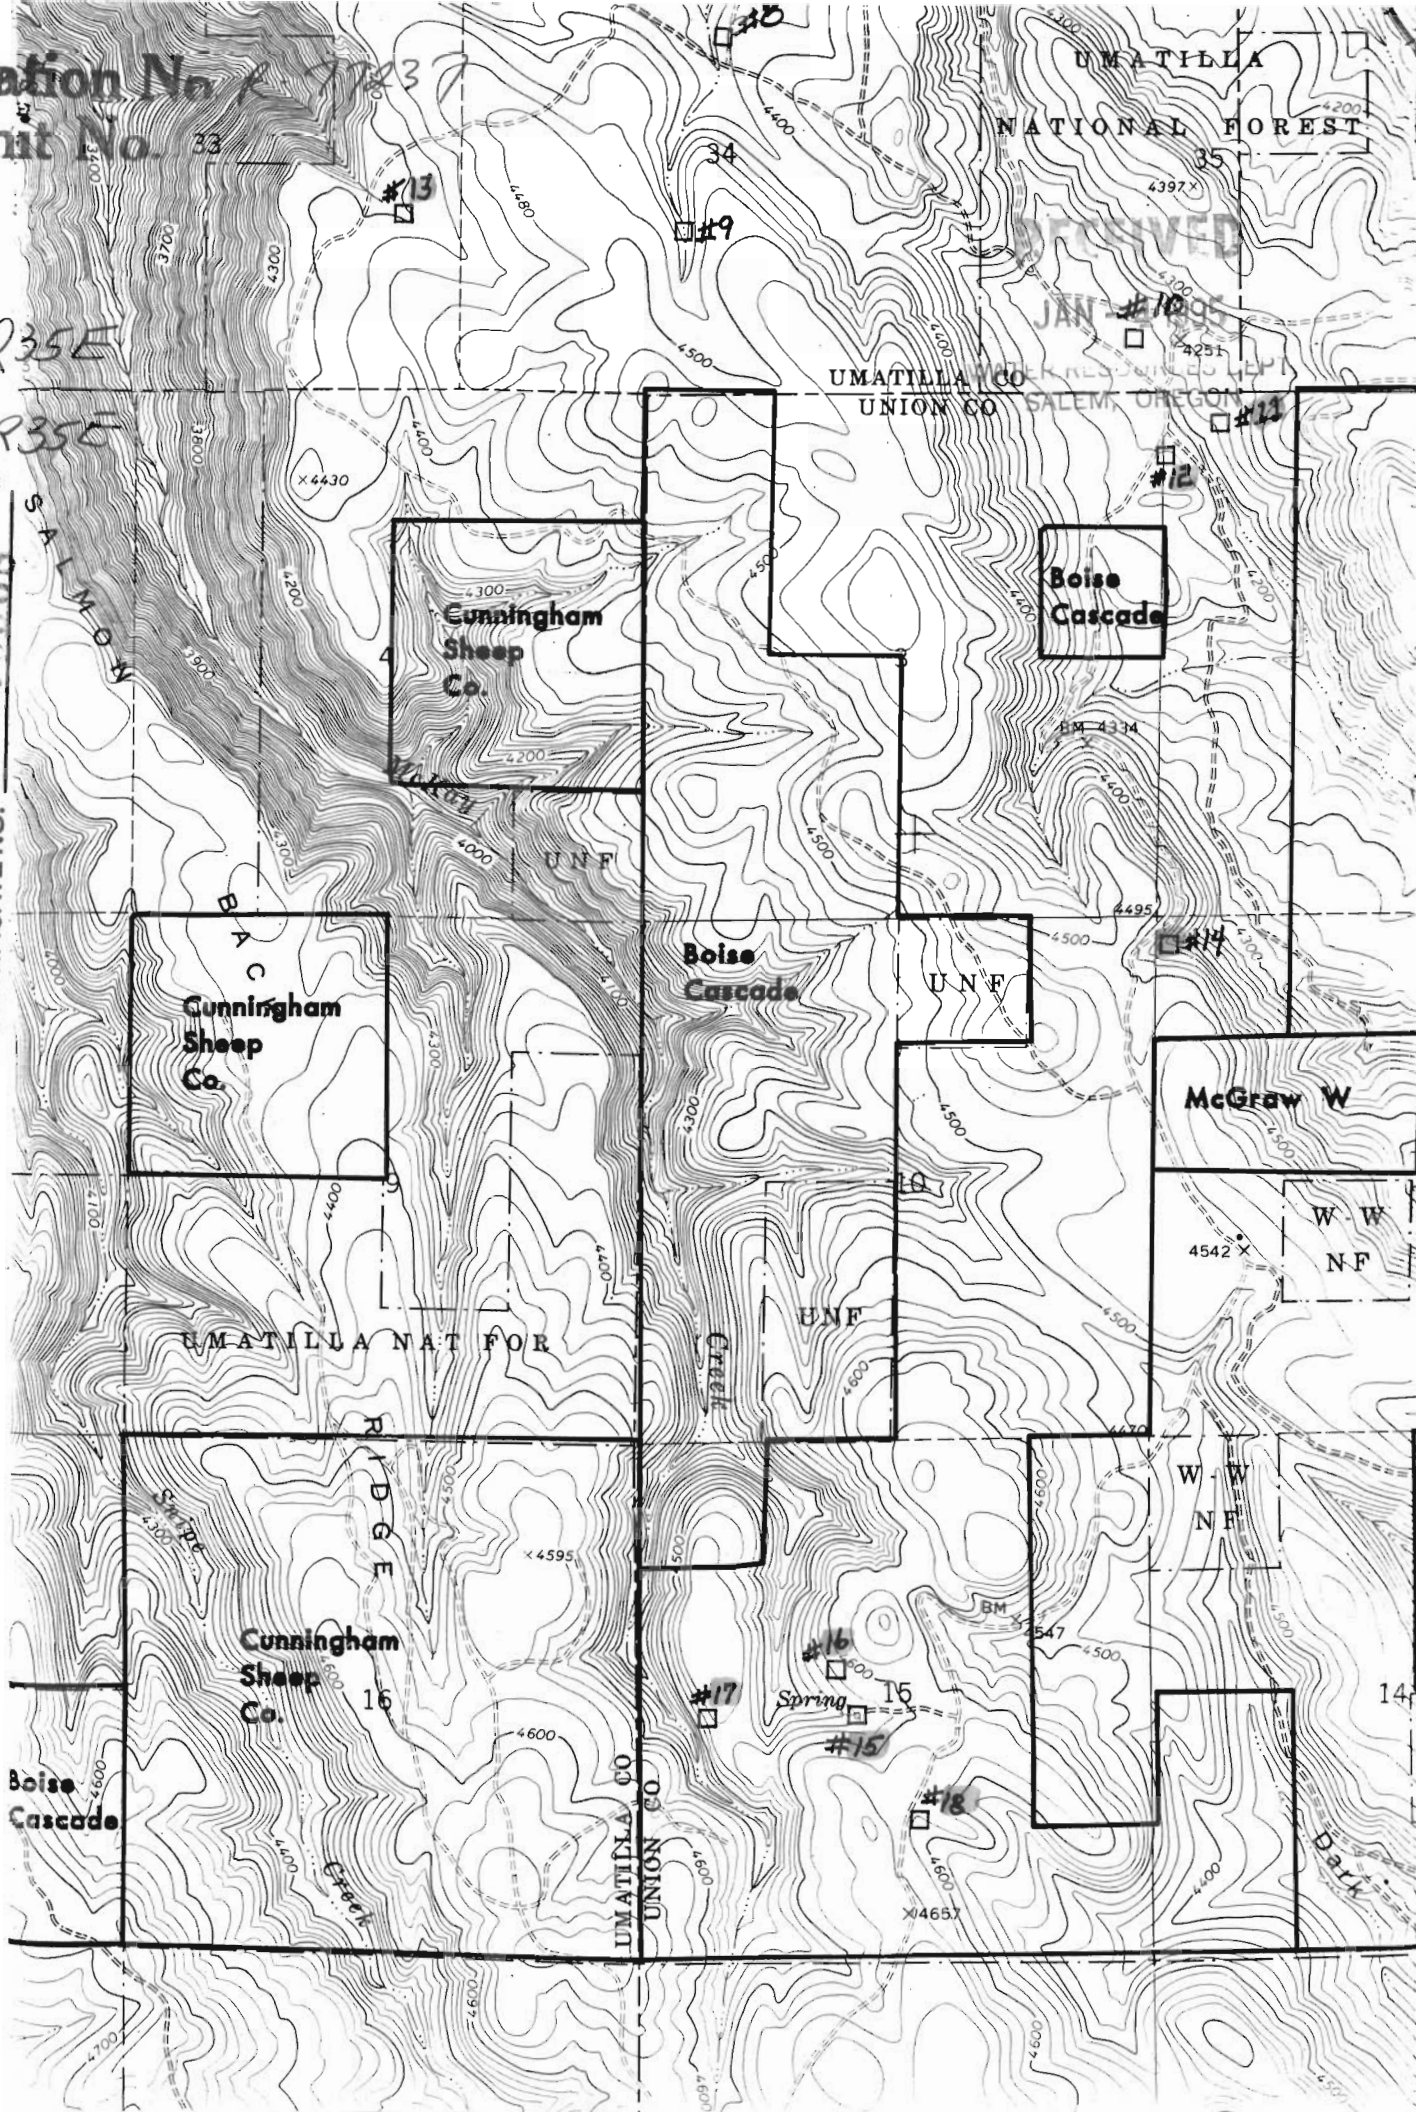

UMATILLA CO UNION CO SALEM, OREGON

UMATILLA NAT FOR

Boise Cascade

UMATILLA CO UNION CO

14