



# August Fire Road Pond

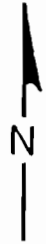

CERTIFICATE NO. 70973

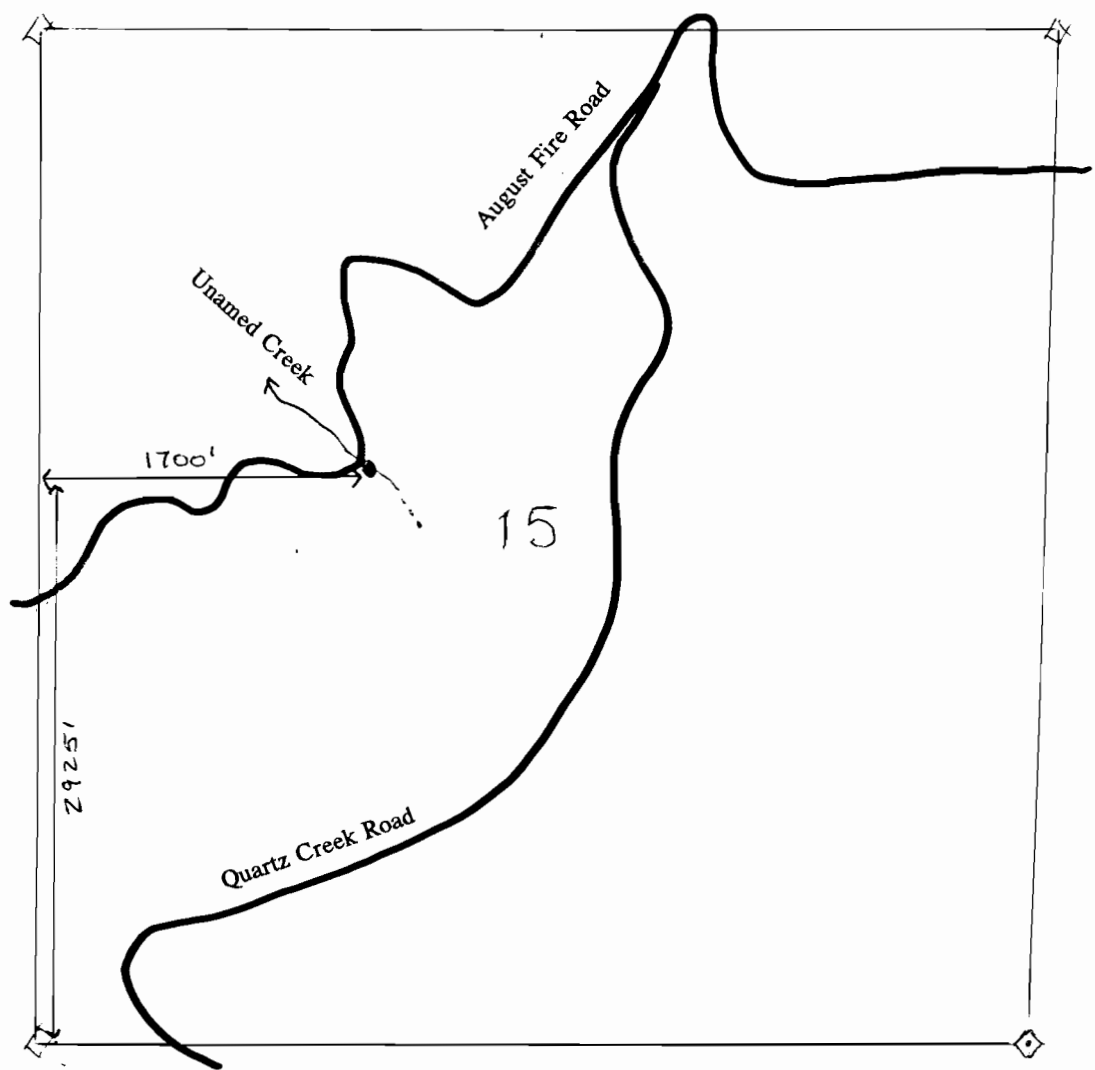

**Application No** R-77248  
**Permit No.**

T4N, R7W, Sec. 15, W.M.

1" = 1000'