


Application No. R-77259

Permit No.

"CERTIFICATE NO. 70976"

T. 20 S., R. 34 E., W.M.

JAN - 3 1995
WATER RES. DIV.
SALEM, OREGON

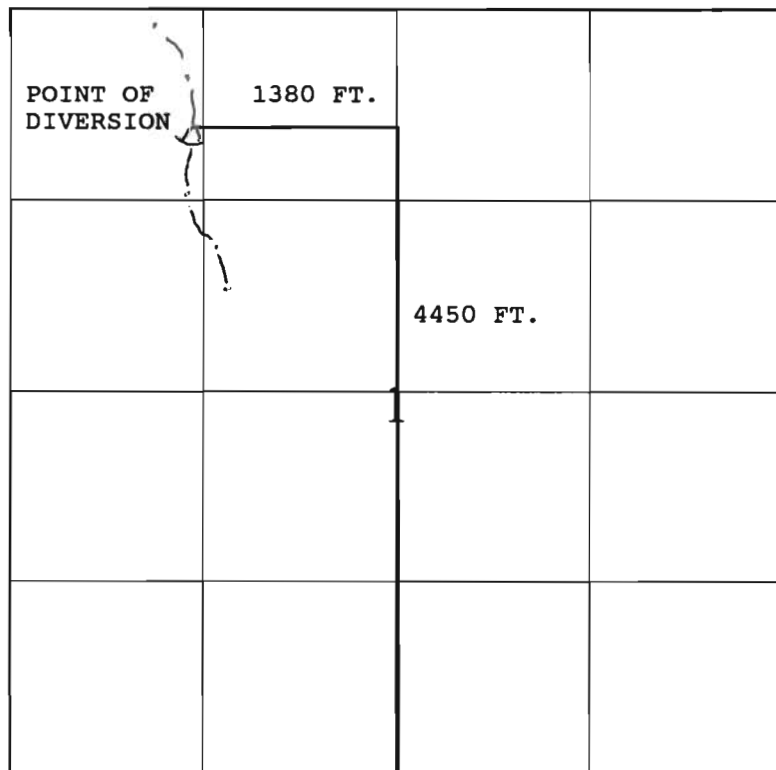

1 IN. = 1320 FT.

IRON PIPE AND
BRASS CAP

APPLICATION MAP

FOR

EROSION RESERVOIR

IN NAME OF

UNITED STATES BUREAU OF LAND MANAGEMENT,

BURNS DISTRICT.

SEPTEMBER 8, 1994

THE PURPOSE OF THIS MAP IS FOR IDENTIFYING THE LOCATION OF THE WATER RIGHT ONLY AND IS NOT INTENDED TO PROVIDE LEGAL DIMENSIONS OR LOCATION OF PROPERTY OWNERSHIP LINES.

THE TIE WAS DETERMINED BY INVERSE BETWEEN POSITIONS DERIVED FROM A RESOURCE GRADE, GLOBAL POSITIONING SYSTEM, A TRIMBLE PATHFINDER, WITH A POSITIONAL ACCURACY OF 2-5 METERS, 50 PERCENT OF THE TIME.

PROJECT NUMBER 5520

WRE-6134A

U.S. BUREAU OF LAND MANAGEMENT - OSO
BRANCH OF CADASTRAL SURVEY

LETTER OF AUTHORIZATION
DATED: AUGUST 17, 1994

EXECUTED BY:
RICHARD L. JOHNSON, PLS, CWRE

OR-942.1
P.O. BOX 2965
PORTLAND OR., 97208