


CERTIFICATE NO.

70977

Application No. R-77260
Permit No.

T. 22 S., R. 30 E., W.M.

FENCE CORNER

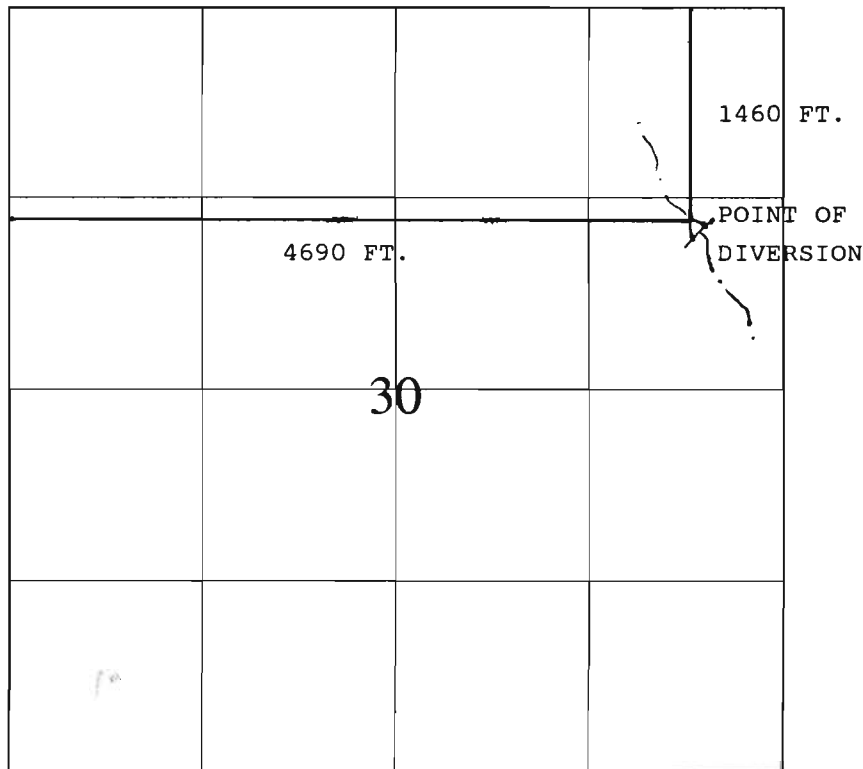


RECEIVED
JAN - 3 1995
WATER RESOURCES DEPT.
SALEM, OREGON



1 IN. = 1320 FT.

APPLICATION MAP
FOR
HEADACHE RESERVOIR

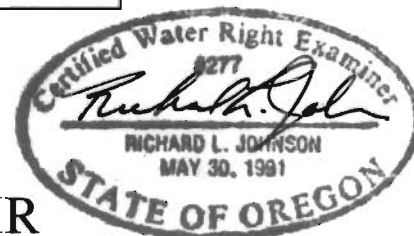

IN NAME OF
UNITED STATES BUREAU OF LAND MANAGEMENT,
BURNS DISTRICT

AUGUST 24, 1994

THE PURPOSE OF THIS MAP IS FOR IDENTIFYING THE LOCATION OF THE WATER RIGHT ONLY AND
IS NOT INTENDED TO PROVIDE LEGAL DIMENSIONS OR LOCATION OF PROPERTY OWNERSHIP LINES.

THE TIE WAS DETERMINED BY INVERSE BETWEEN POSITIONS DERIVED FROM A RESOURCE GRADE GLOBAL POSITIONING
SYSTEM, A TRIMBLE PATHFINDER, WITH A POSITIONAL ACCURACY OF 2-5 METERS, 50 PERCENT OF THE TIME.

PROJECT NUMBER 5403

WRE 6112A OREGON

U.S. BUREAU OF LAND MANAGEMENT - OSO
BRANCH OF CADASTRAL SURVEY

LETTER OF AUTHORIZATION
DATED: AUGUST 17, 1994

EXECUTED BY:
RICHARD L. JOHNSON, PLS, CWRE

OR-942.1
P.O. BOX 2965
PORTLAND OR., 97208