

CERTIFICATE NO.

20979

Application No. R-77242


Permit No.

RECEIVED

JAN - 3 1995

WATER RESOURCES
SALEM, OREGON

T. 18 S., R. 35 E., W.M.

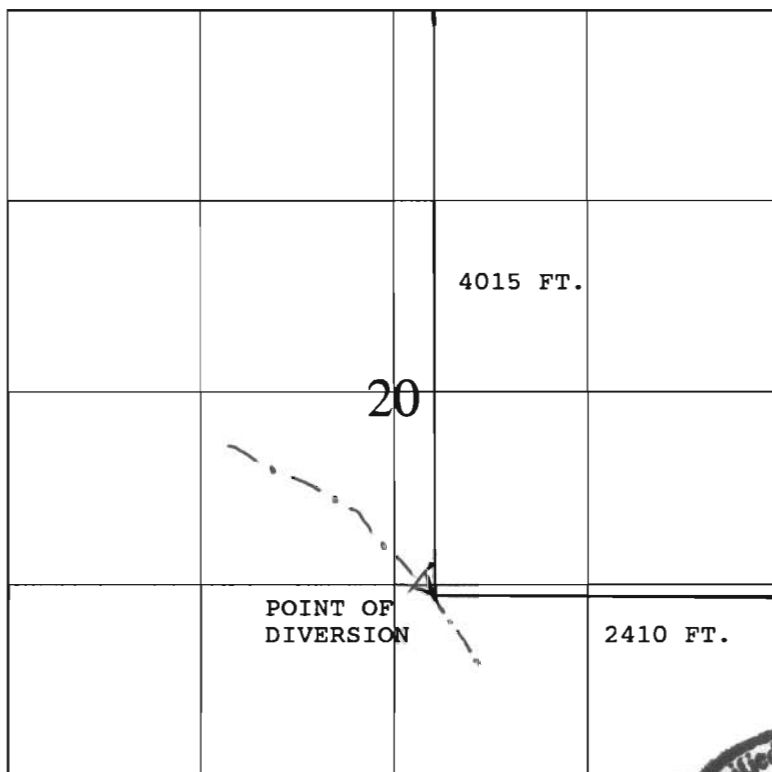

IRON PIPE AND
BRASS CAP



1 IN. = 1320 FT.

APPLICATION MAP

FOR

THREE TIP RESERVOIR

IN NAME OF

UNITED STATES BUREAU OF LAND MANAGEMENT,

BURNS DISTRICT

SEPTEMBER 9, 1994

THE PURPOSE OF THIS MAP IS FOR IDENTIFYING THE LOCATION OF THE WATER RIGHT ONLY AND
IS NOT INTENDED TO PROVIDE LEGAL DIMENSIONS OR LOCATION OF PROPERTY OWNERSHIP LINES.

THE TIE WAS DETERMINED BY INVERSE BETWEEN POSITIONS DERIVED FROM A RESOURCE GRADE GLOBAL POSITIONING
SYSTEM, A TRIMBLE PATHFINDER, WITH A POSITIONAL ACCURACY OF 2-5 METERS, 50 PERCENT OF THE TIME.

PROJECT NUMBER 4175

WRE-6127A

U.S. BUREAU OF LAND MANAGEMENT - OSO
BRANCH OF CADASTRAL SURVEY

LETTER OF AUTHORIZATION
DATED: AUGUST 17, 1994

EXECUTED BY:
RICHARD L. JOHNSON, PLS, CWRE

OR-942.1
P.O. BOX 2965
PORTLAND OR., 97208

