


CERTIFICATE NO. 70980 Application No. 8-77263
Permit No.

T. 24 S., R. 35 E., W.M.

RECEIVED

JAN - 3 1995

WATER RESOURCES DEPT.
SALEM, OREGON

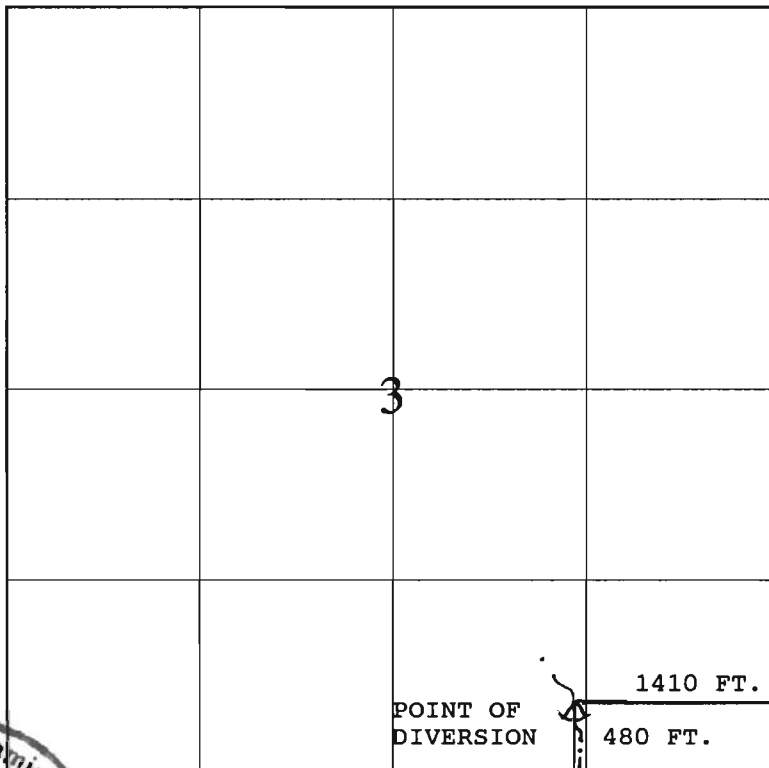

1 IN. = 1320 FT.



APPLICATION MAP

FOR

COW CANYON RESERVOIR

IN NAME OF

UNITED STATES BUREAU OF LAND MANAGEMENT,

BURNS DISTRICT.

AUGUST 30, 1994

THE PURPOSE OF THIS MAP IS FOR IDENTIFYING THE LOCATION OF THE WATER RIGHT ONLY AND IS NOT INTENDED TO PROVIDE LEGAL DIMENSIONS OR LOCATION OF PROPERTY OWNERSHIP LINES.

THE TIE WAS DETERMINED BY INVERSE BETWEEN A POSITION, THE POINT OF DIVERSION, DERIVED FROM A RESOURCE GRADE GLOBAL POSITIONING SYSTEM, A TRIMBLE PATHFINDER, WITH A POSITIONAL ACCURACY OF 2-5 METERS, 50 PERCENT OF THE TIME, AND A POSITION, THE CORNER OF SECTIONS 2, 3, 10, AND 11, SCALED FROM THE COLMAN MTN. QUADRANGLE, 1979 EDITION.

PROJECT NUMBER 4954

WRE-6128A

U.S. BUREAU OF LAND MANAGEMENT - OSO
BRANCH OF CADASTRAL SURVEY

LETTER OF AUTHORIZATION
DATED: AUGUST 17, 1994

EXECUTED BY:
RICHARD L. JOHNSON, PLS, CWRE

OR-942.1
P.O. BOX 2965
PORTLAND OR., 97208