

CERTIFICATE NO.

70981

Application No. R-77264


Permit No.

T. 26 S., R. 35 E., W.M.

RECEIVED

JAN - 3 1995


WATER RESOURCES DEPT.
SALEM, OREGON

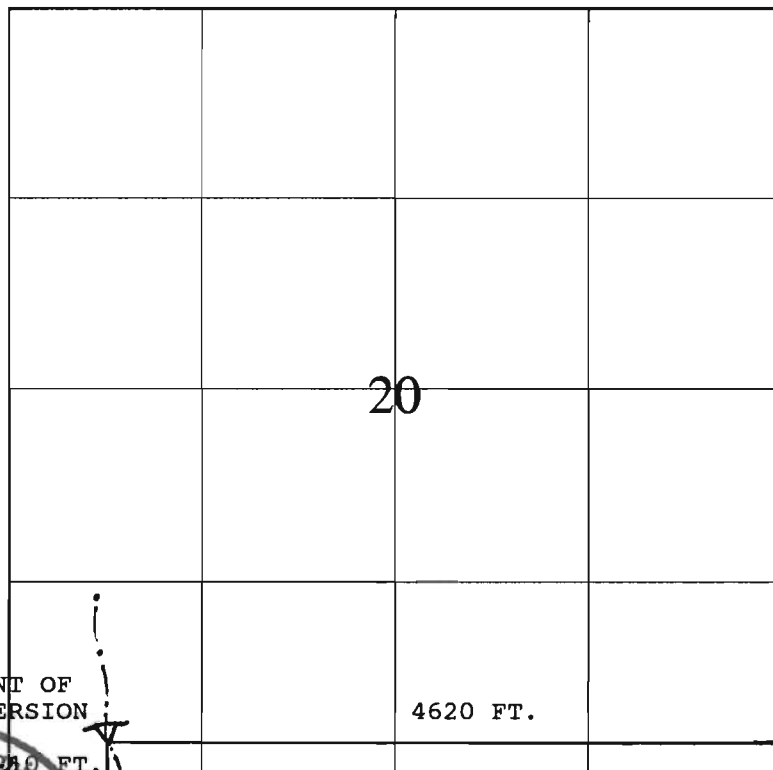

1 IN. = 1320 FT.

POINT OF
DIVERSION

4620 FT.

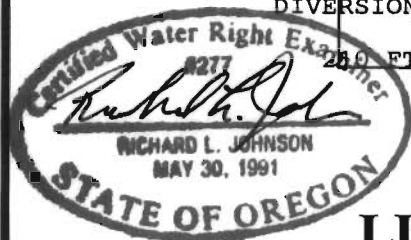

APPLICATION MAP

FOR

LITTLE UPPER RESERVOIR

IN NAME OF

UNITED STATES BUREAU OF LAND MANAGEMENT,

BURNS DISTRICT.

AUGUST 29, 1994

THE PURPOSE OF THIS MAP IS FOR IDENTIFYING THE LOCATION OF THE WATER RIGHT ONLY AND
IS NOT INTENDED TO PROVIDE LEGAL DIMENSIONS OR LOCATION OF PROPERTY OWNERSHIP LINES.

THE TIE WAS DETERMINED BY INVERSE BETWEEN A POSITION, THE POINT OF DIVERSION, DERIVED FROM A RESOURCE GRADE, GLOBAL POSITIONING
SYSTEM, A TRIMBLE PATHFINDER, WITH A POSITIONAL ACCURACY OF 2-5 METERS, 50 PERCENT OF THE TIME, AND
A POSITION, THE CORNER OF SECTIONS 20, 21, 28, AND 29, SCALED FROM THE CIRCLE BAR, OREG., 1972 EDITION QUADRANGLE.

PROJECT NUMBER 5258

WRE-6129A

U.S. BUREAU OF LAND MANAGEMENT - OSO
BRANCH OF CADASTRAL SURVEY

LETTER OF AUTHORIZATION
DATED: AUGUST 17, 1994

EXECUTED BY:
RICHARD L. JOHNSON, PLS, CWRE

OR-942.1
P.O. BOX 2965
PORTLAND OR., 97208