



Prepared by UNITED STATES DEPARTMENT of AGRICULTURE * SOIL CONSERVATION SERVICE
cooperating with

OWNER
OPERATOR

S.C. DISTRICT

FARM NO.
SCALE


DATE
ACRES

PHOTO NO.

HB 2153

John J. Healy

Kathryn M Healy

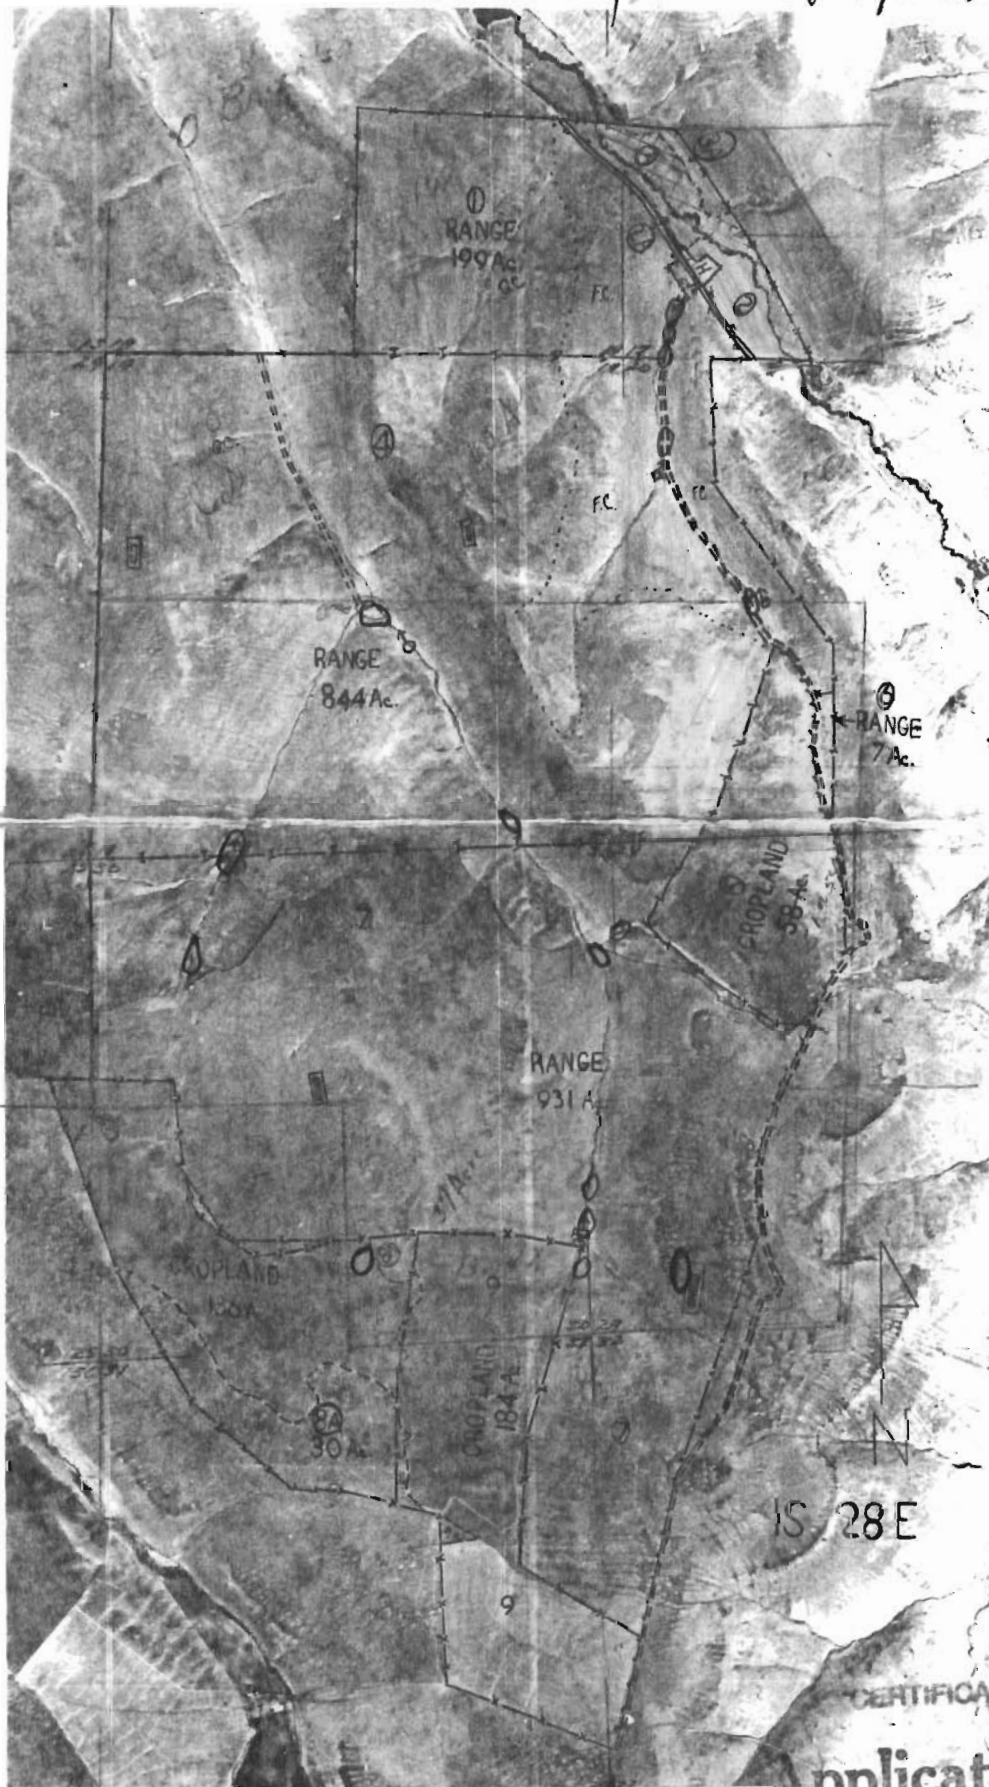

RECEIVED

JAN - 5 1995

WATER RESOURCES DIVISION
SALEM, OREGON

70992

CERTIFICATE NO.

Application No. R-77275
Permit No.