


Cecelia

Bucknum

HB 2153

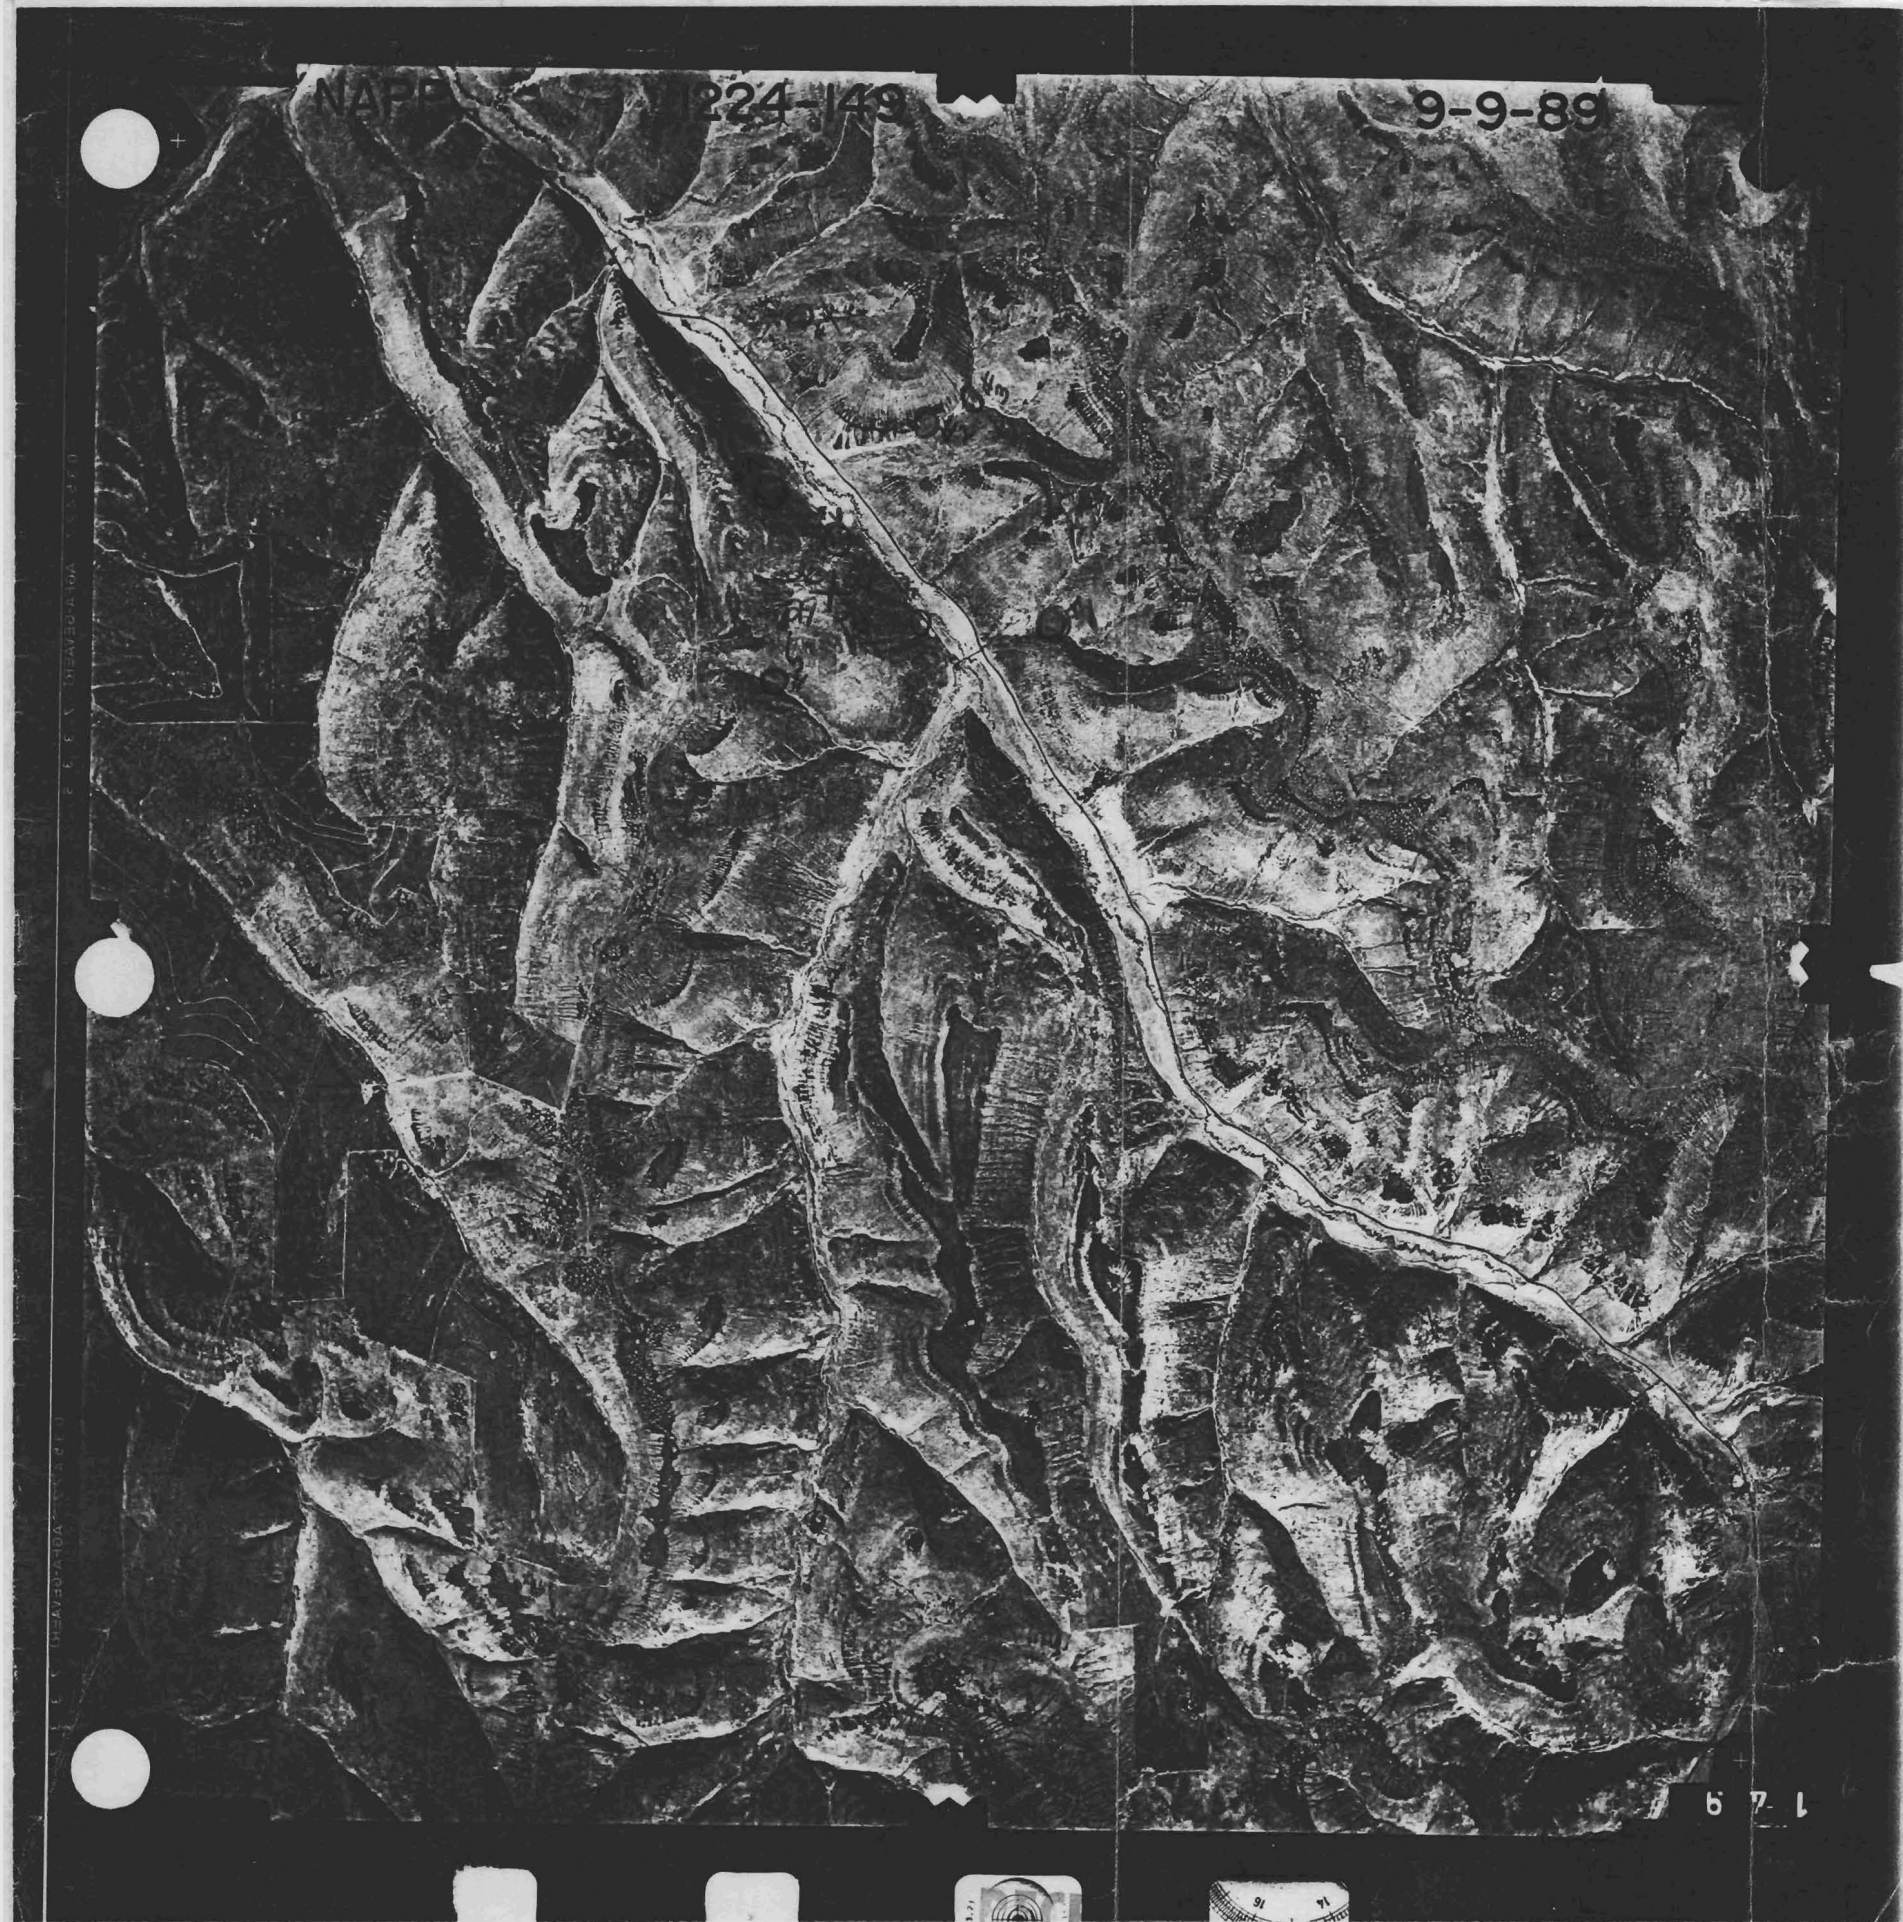

TISR28
70993

map P17

JAN - 5 1995
WATER RESOUR.
SALEM, OREGON

HB 2153

R-77276

CERTIFICATE NO.