


2389 1/4 NE
(JOHNNY CREEK)

UNITED STATES
DEPARTMENT OF THE INTERIOR
GEOLOGICAL SURVEY

JOHNNY CREEK SW QUADRANGLE
OREGON
7.5 MINUTE SERIES (TOPOGRAPHIC)

2389 1/4 NE
(JOHNNY CREEK SW)

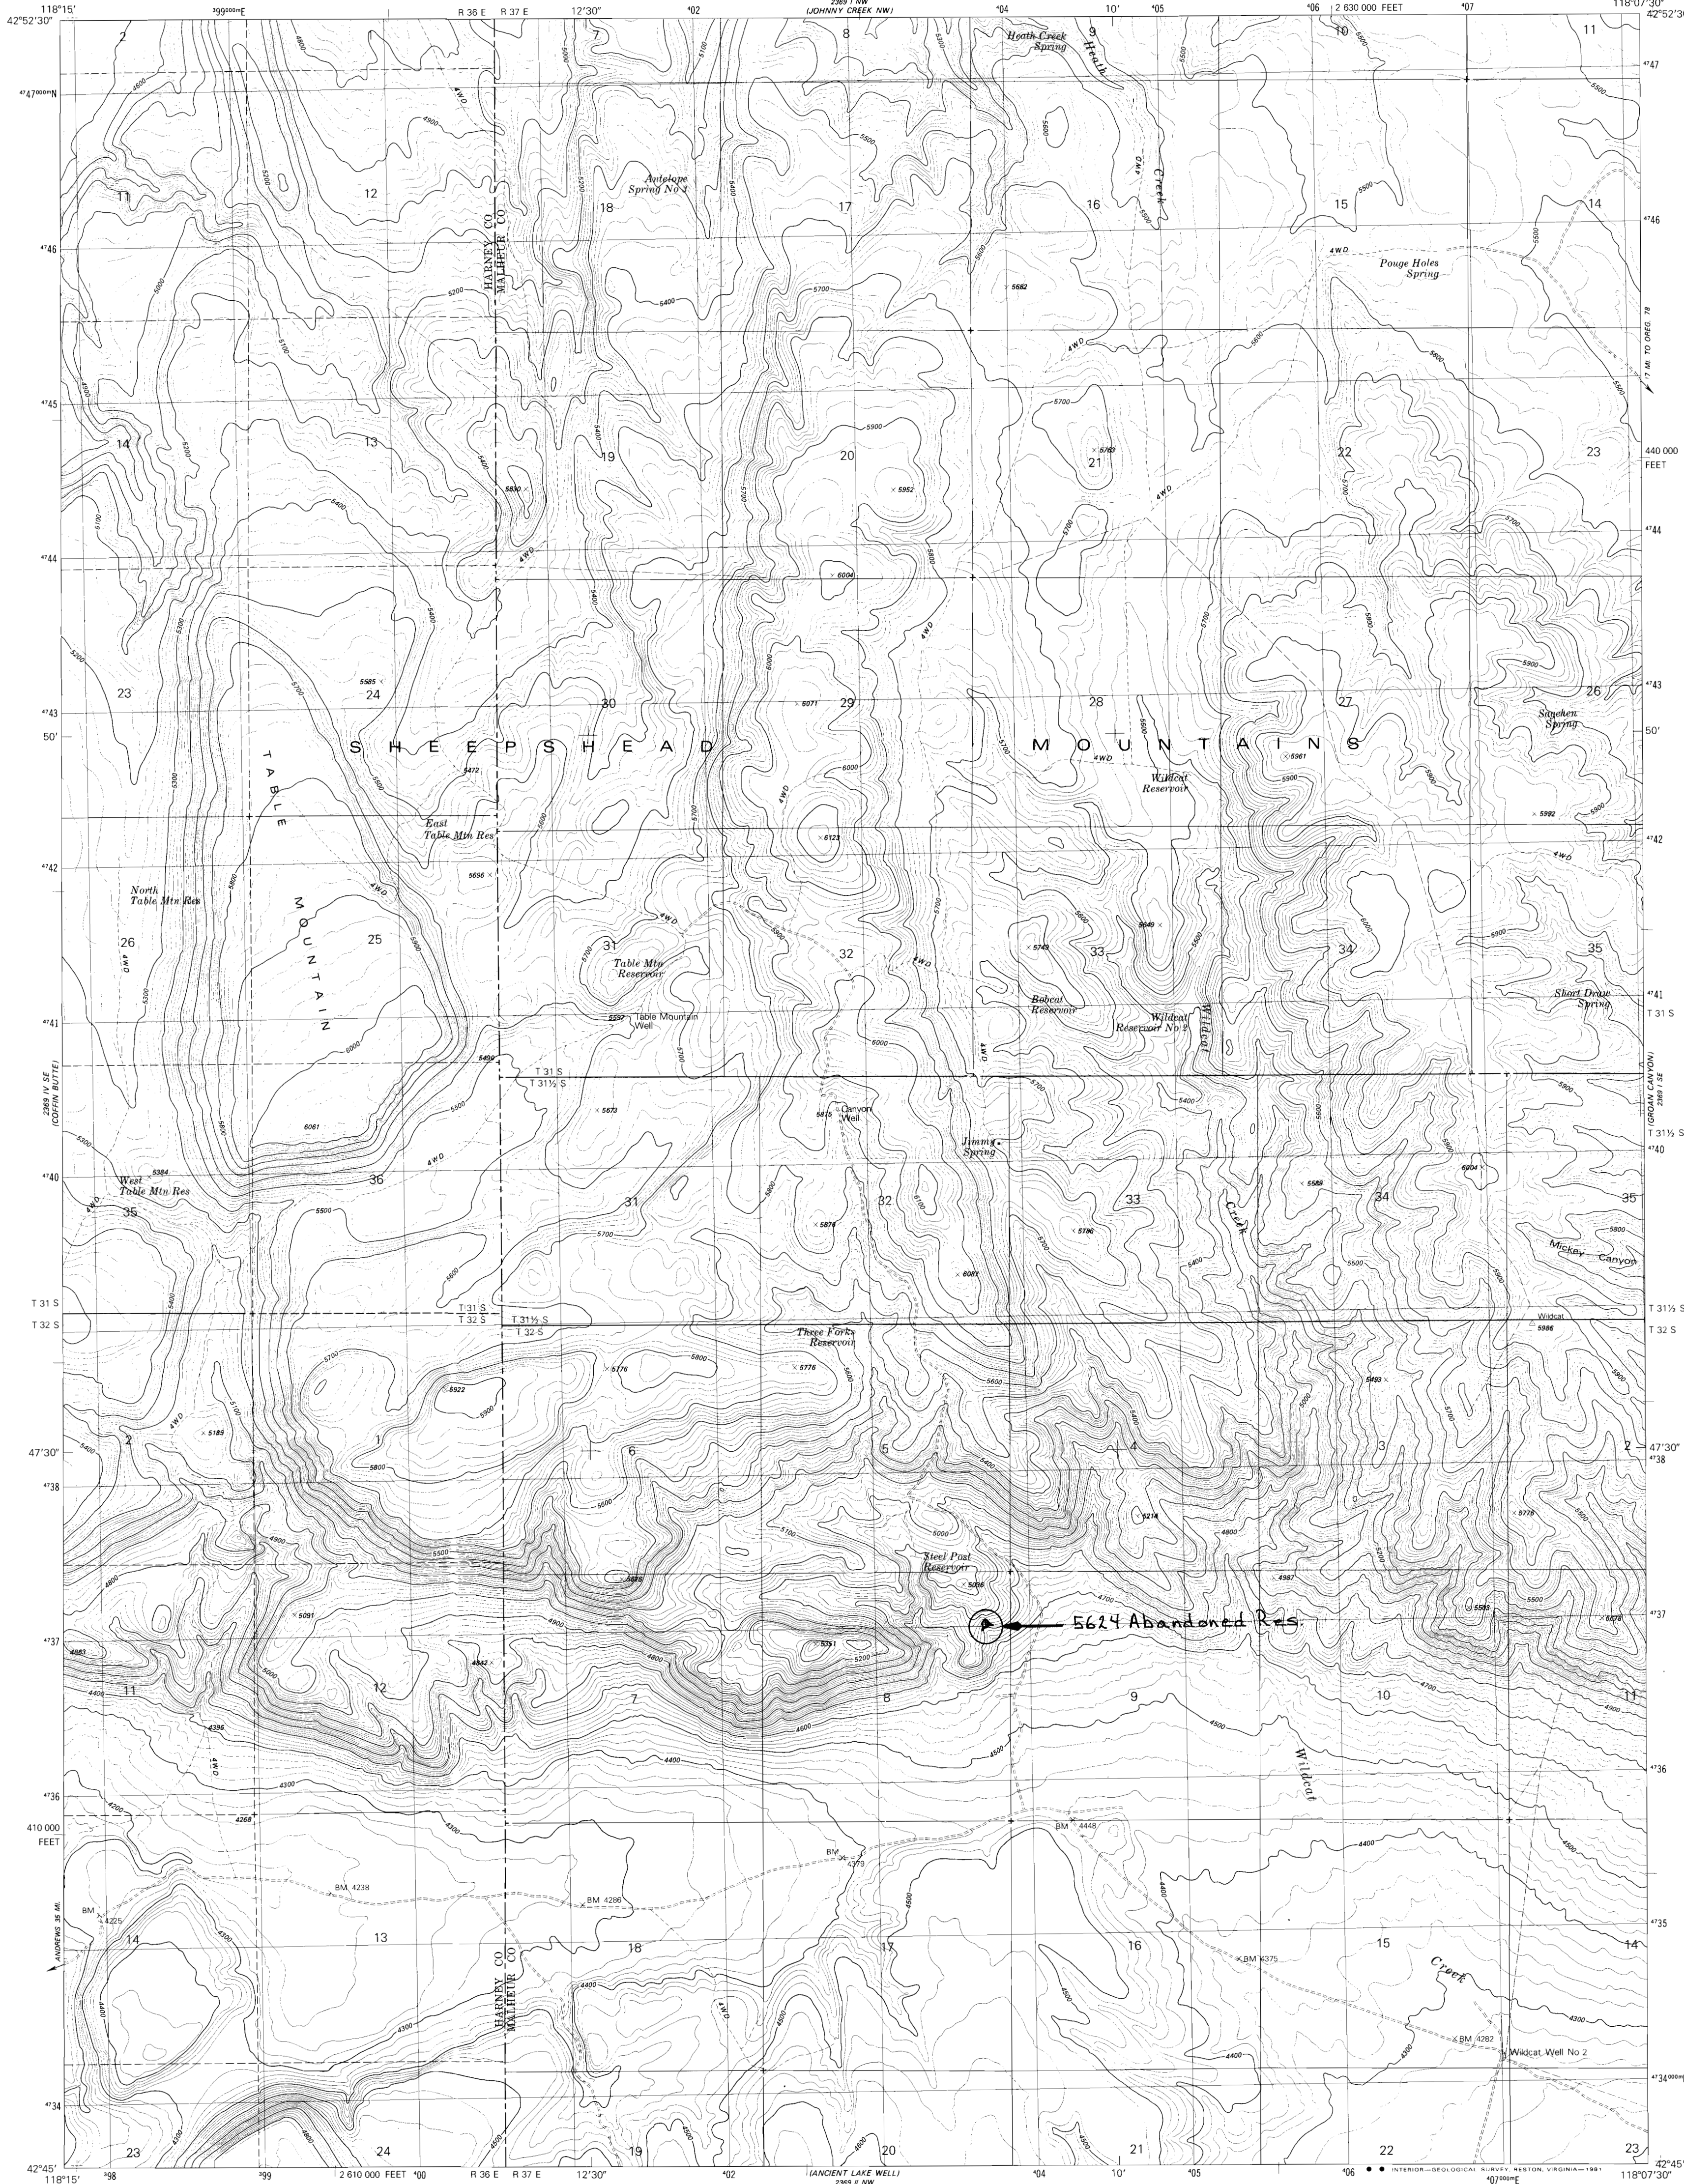

2389 1/4 SE
(COFFIN BUTTE)



Mapped, edited, and published by the Geological Survey

Control by USGS and NOS/NOAA

Topography by photogrammetric methods from aerial
photographs taken 1974. Field checked 1975
Map edited 1981

Projection and 10,000-foot grid ticks: Oregon coordinate
system, south zone (Lambert conformal conic)
1000-meter Universal Transverse Mercator grid, zone 11
1927 North American Datum
To place on the predicted North American Datum 1983
move the projection lines 16 meters north and
82 meters east as shown by dashed corner ticks

Fine red dashed lines indicate selected fence and field lines
where generally visible on aerial photographs
This information is unchecked

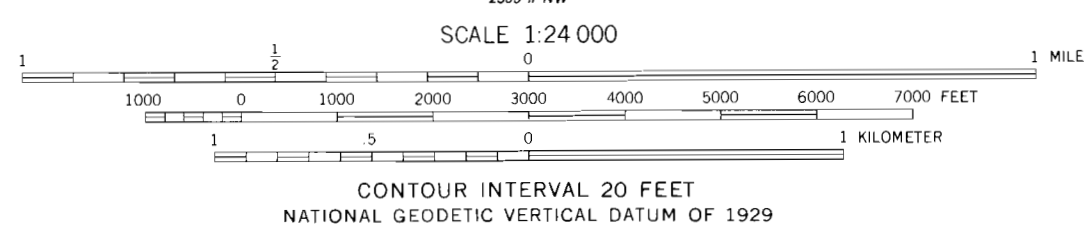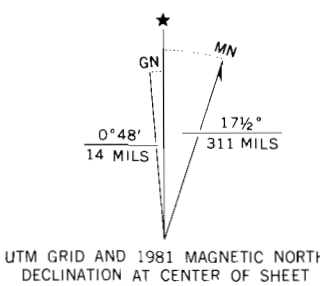

ROAD CLASSIFICATION
Primary highway,
hard surface
Secondary highway,
hard surface
Interstate Route
U. S. Route
State Route
Light duty road, hard or
improved surface
Unimproved road

JOHNNY CREEK SW, OREG.

Application No. R-77277
Permit No. 70994
CERTIFICATE NO.

JAN - 3 1995
WATER RESOURCES DEPT.
SALEM, OREGON