


WEED LAKE BUTTE QUADRANGLE
OREGON-HARNEY CO.
7.5 MINUTE SERIES (TOPOGRAPHIC)



UTM GRID AND 1980 MAGNETIC NORTH DECLINATION AT CENTER OF SHEET

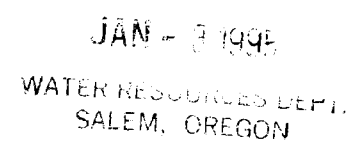

ROAD CLASSIFICATION

Primary highway, hard surface	Light-duty road, hard or improved surface
Secondary highway, hard surface	Unimproved road

1980

DMA 2170 II SW—SERIES V892

"CERTIFICATE NO.

70995