



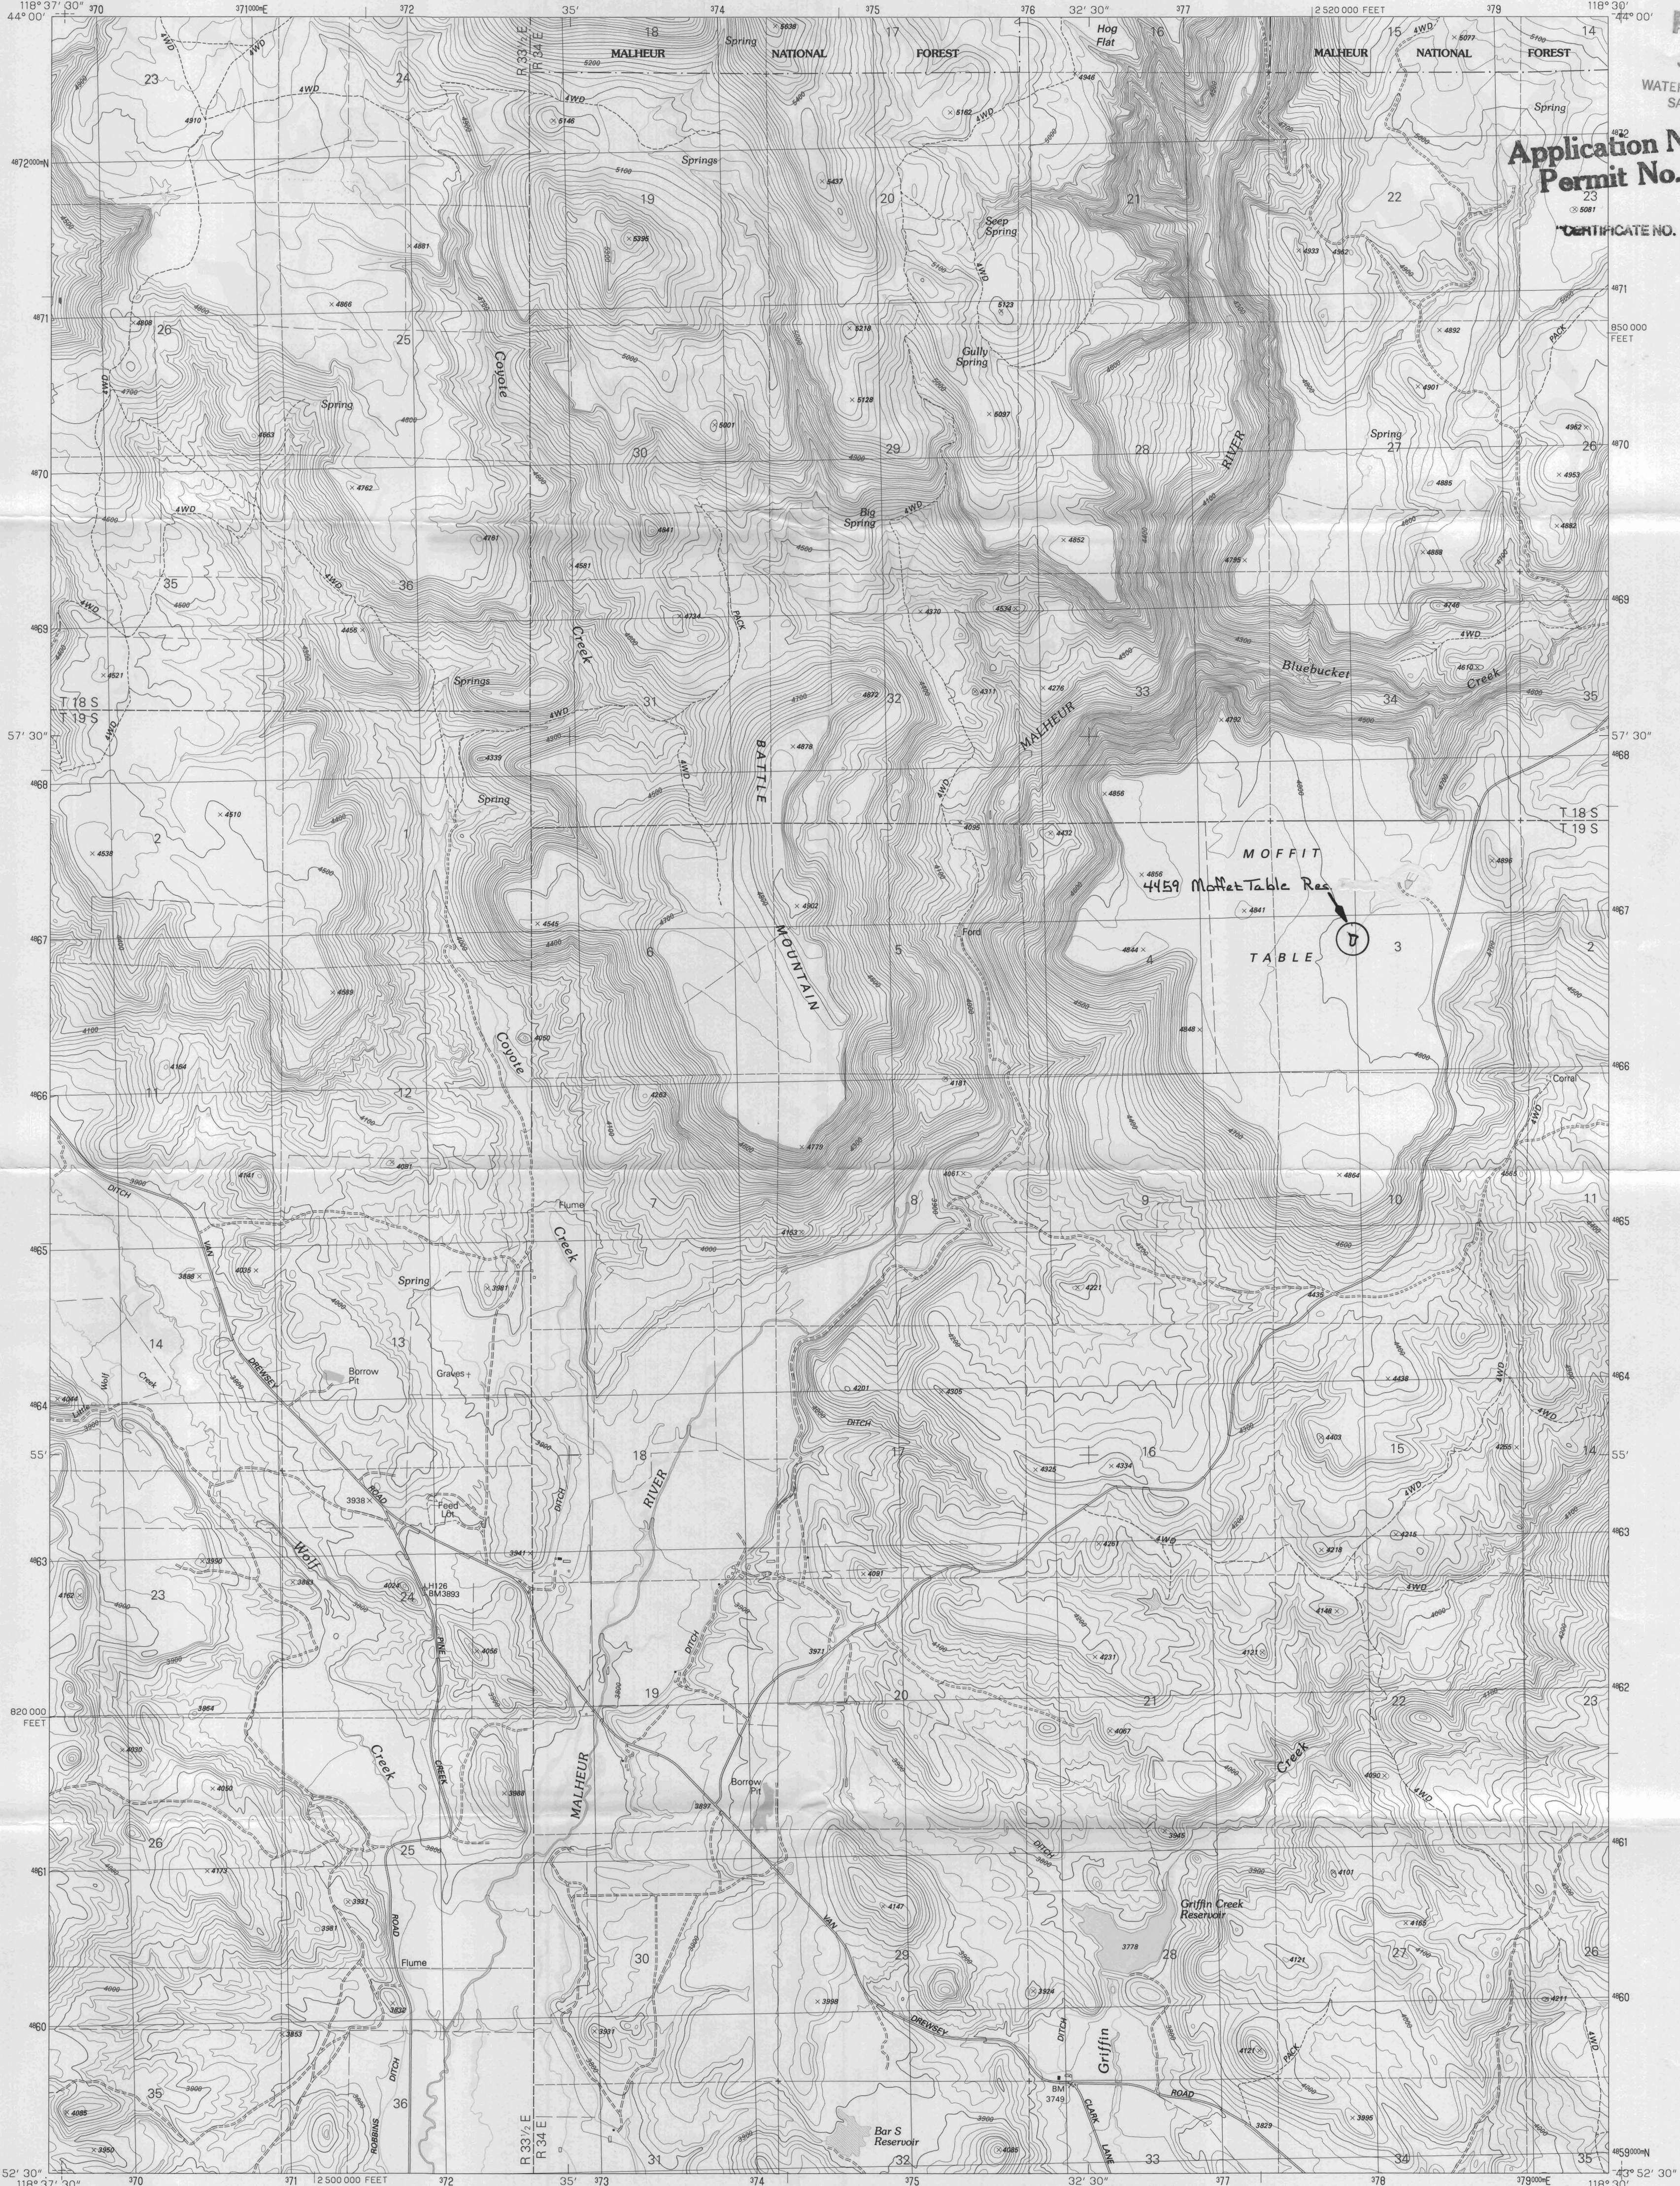

RECEIVED
JAN - 3 1995
WATER RESOURCES DEPT.
SALEM, OREGON
Application No. R-7728/
Permit No.
CERTIFICATE NO. 20998

PRODUCED BY THE UNITED STATES GEOLOGICAL SURVEY
CONTROL BY U.S.G.S. NOS/NOAA
COMPILED FROM AERIAL PHOTOGRAPHS TAKEN 1967
FIELD CHECKED 1968
LIMITED REVISION FROM AERIAL PHOTOGRAPHS TAKEN 1985
FIELD CHECKED 1987 MAP EDITED 1990
PROJECTION LAMBERT CONFORMAL CONIC
GRID 1000-METER UNIVERSAL TRANSVERSE MERCATOR ZONE 12
8000-FOOT STATE GRID TICKS OREGON STATE ZONE
UTM GRID DECLINATION 1°05' WEST
1990 MAGNETIC NORTH DECLINATION 17° EAST
VERTICAL DATUM NATIONAL GEODETIC VERTICAL DATUM OF 1929
HORIZONTAL DATUM 1927 NORTH AMERICAN DATUM
To place on the predicted North American Datum of 1983,
move the projection lines as shown by dashed corner ticks
(18 meters north and 83 meters east)
There may be private inholdings within the boundaries of any
Federal and State Reservations shown on this map.
Public Land Survey System is shown as published in 1968 and
verified or supplemented in 1987

PROVISIONAL MAP
Produced from original
manuscript drawings. Infor-
mation shown as of date of
field check.

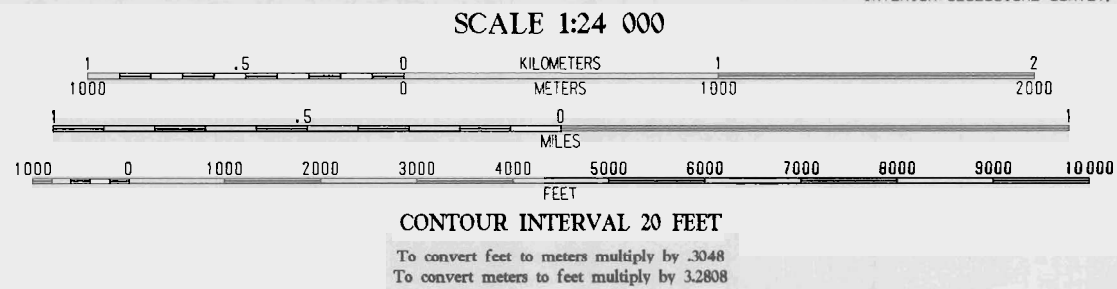

THIS MAP COMPLIES WITH NATIONAL MAP ACCURACY STANDARDS
FOR SALE BY U.S. GEOLOGICAL SURVEY, DENVER, COLORADO 80225
OR RESTON, VIRGINIA 22092

QUADRANGLE LOCATION							
1	2	3	1	Maggie Table			
			2	Dollar Basin			
			3	Yam Mountain			
			4	Van			
			5	Old Mountain			
			6	Craft Point			
			7	House Butte			
			8	Drewsey			

ADJOINING 7.5' QUADRANGLE NAMES

ROAD LEGEND
Improved Road
Unimproved Road
Trail
Interstate Route U.S. Route State Route

MOFFIT TABLE, OREGON
PROVISIONAL EDITION 1990

43118-H5-TF-024