


WALLS LAKE RESERVOIR T.31S., R.31E., W.M..

JAN - 3 1995
WATER RESOURCES DEPT.
SALEM, OREGON

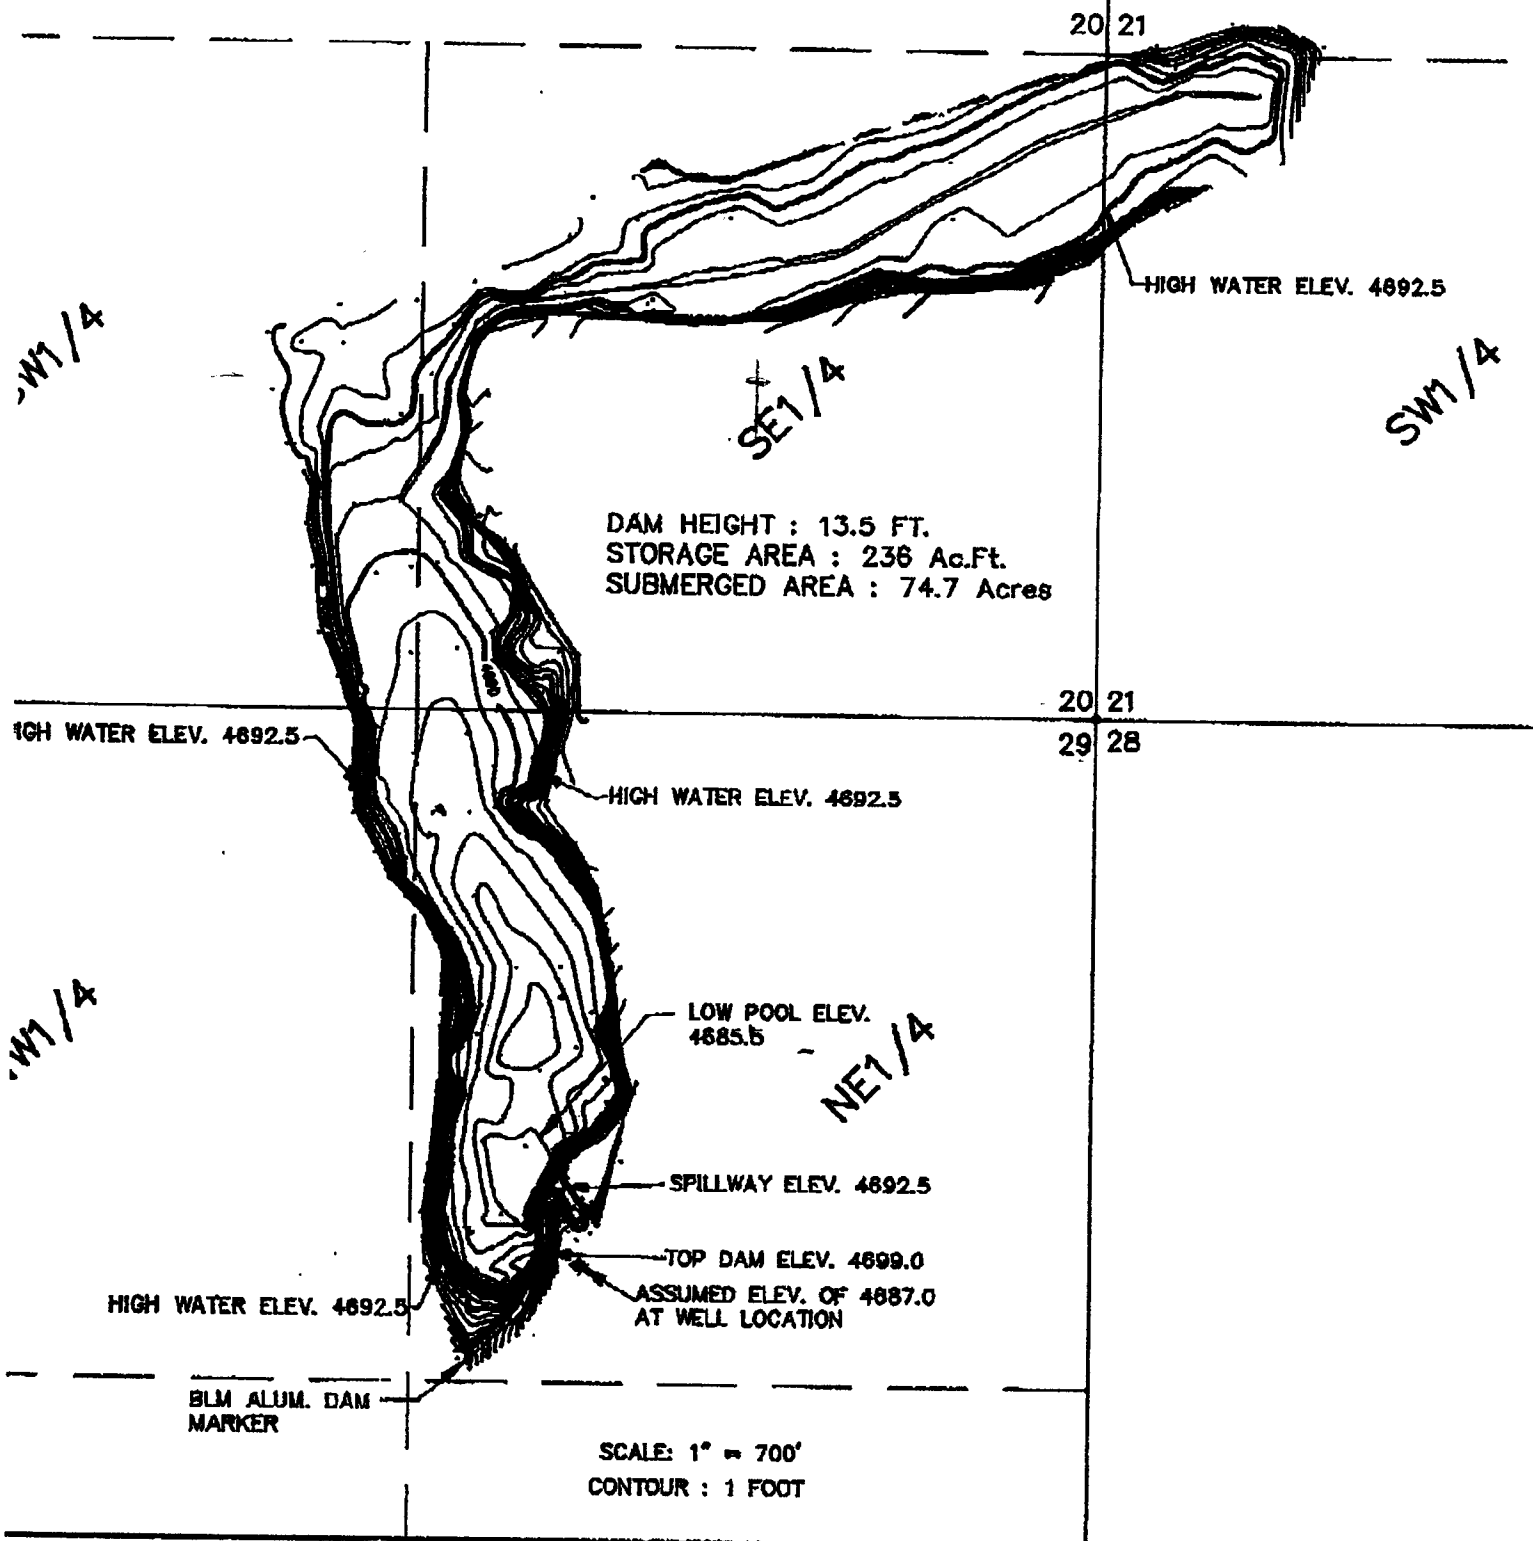

Application No. R-77283
Permit No.