


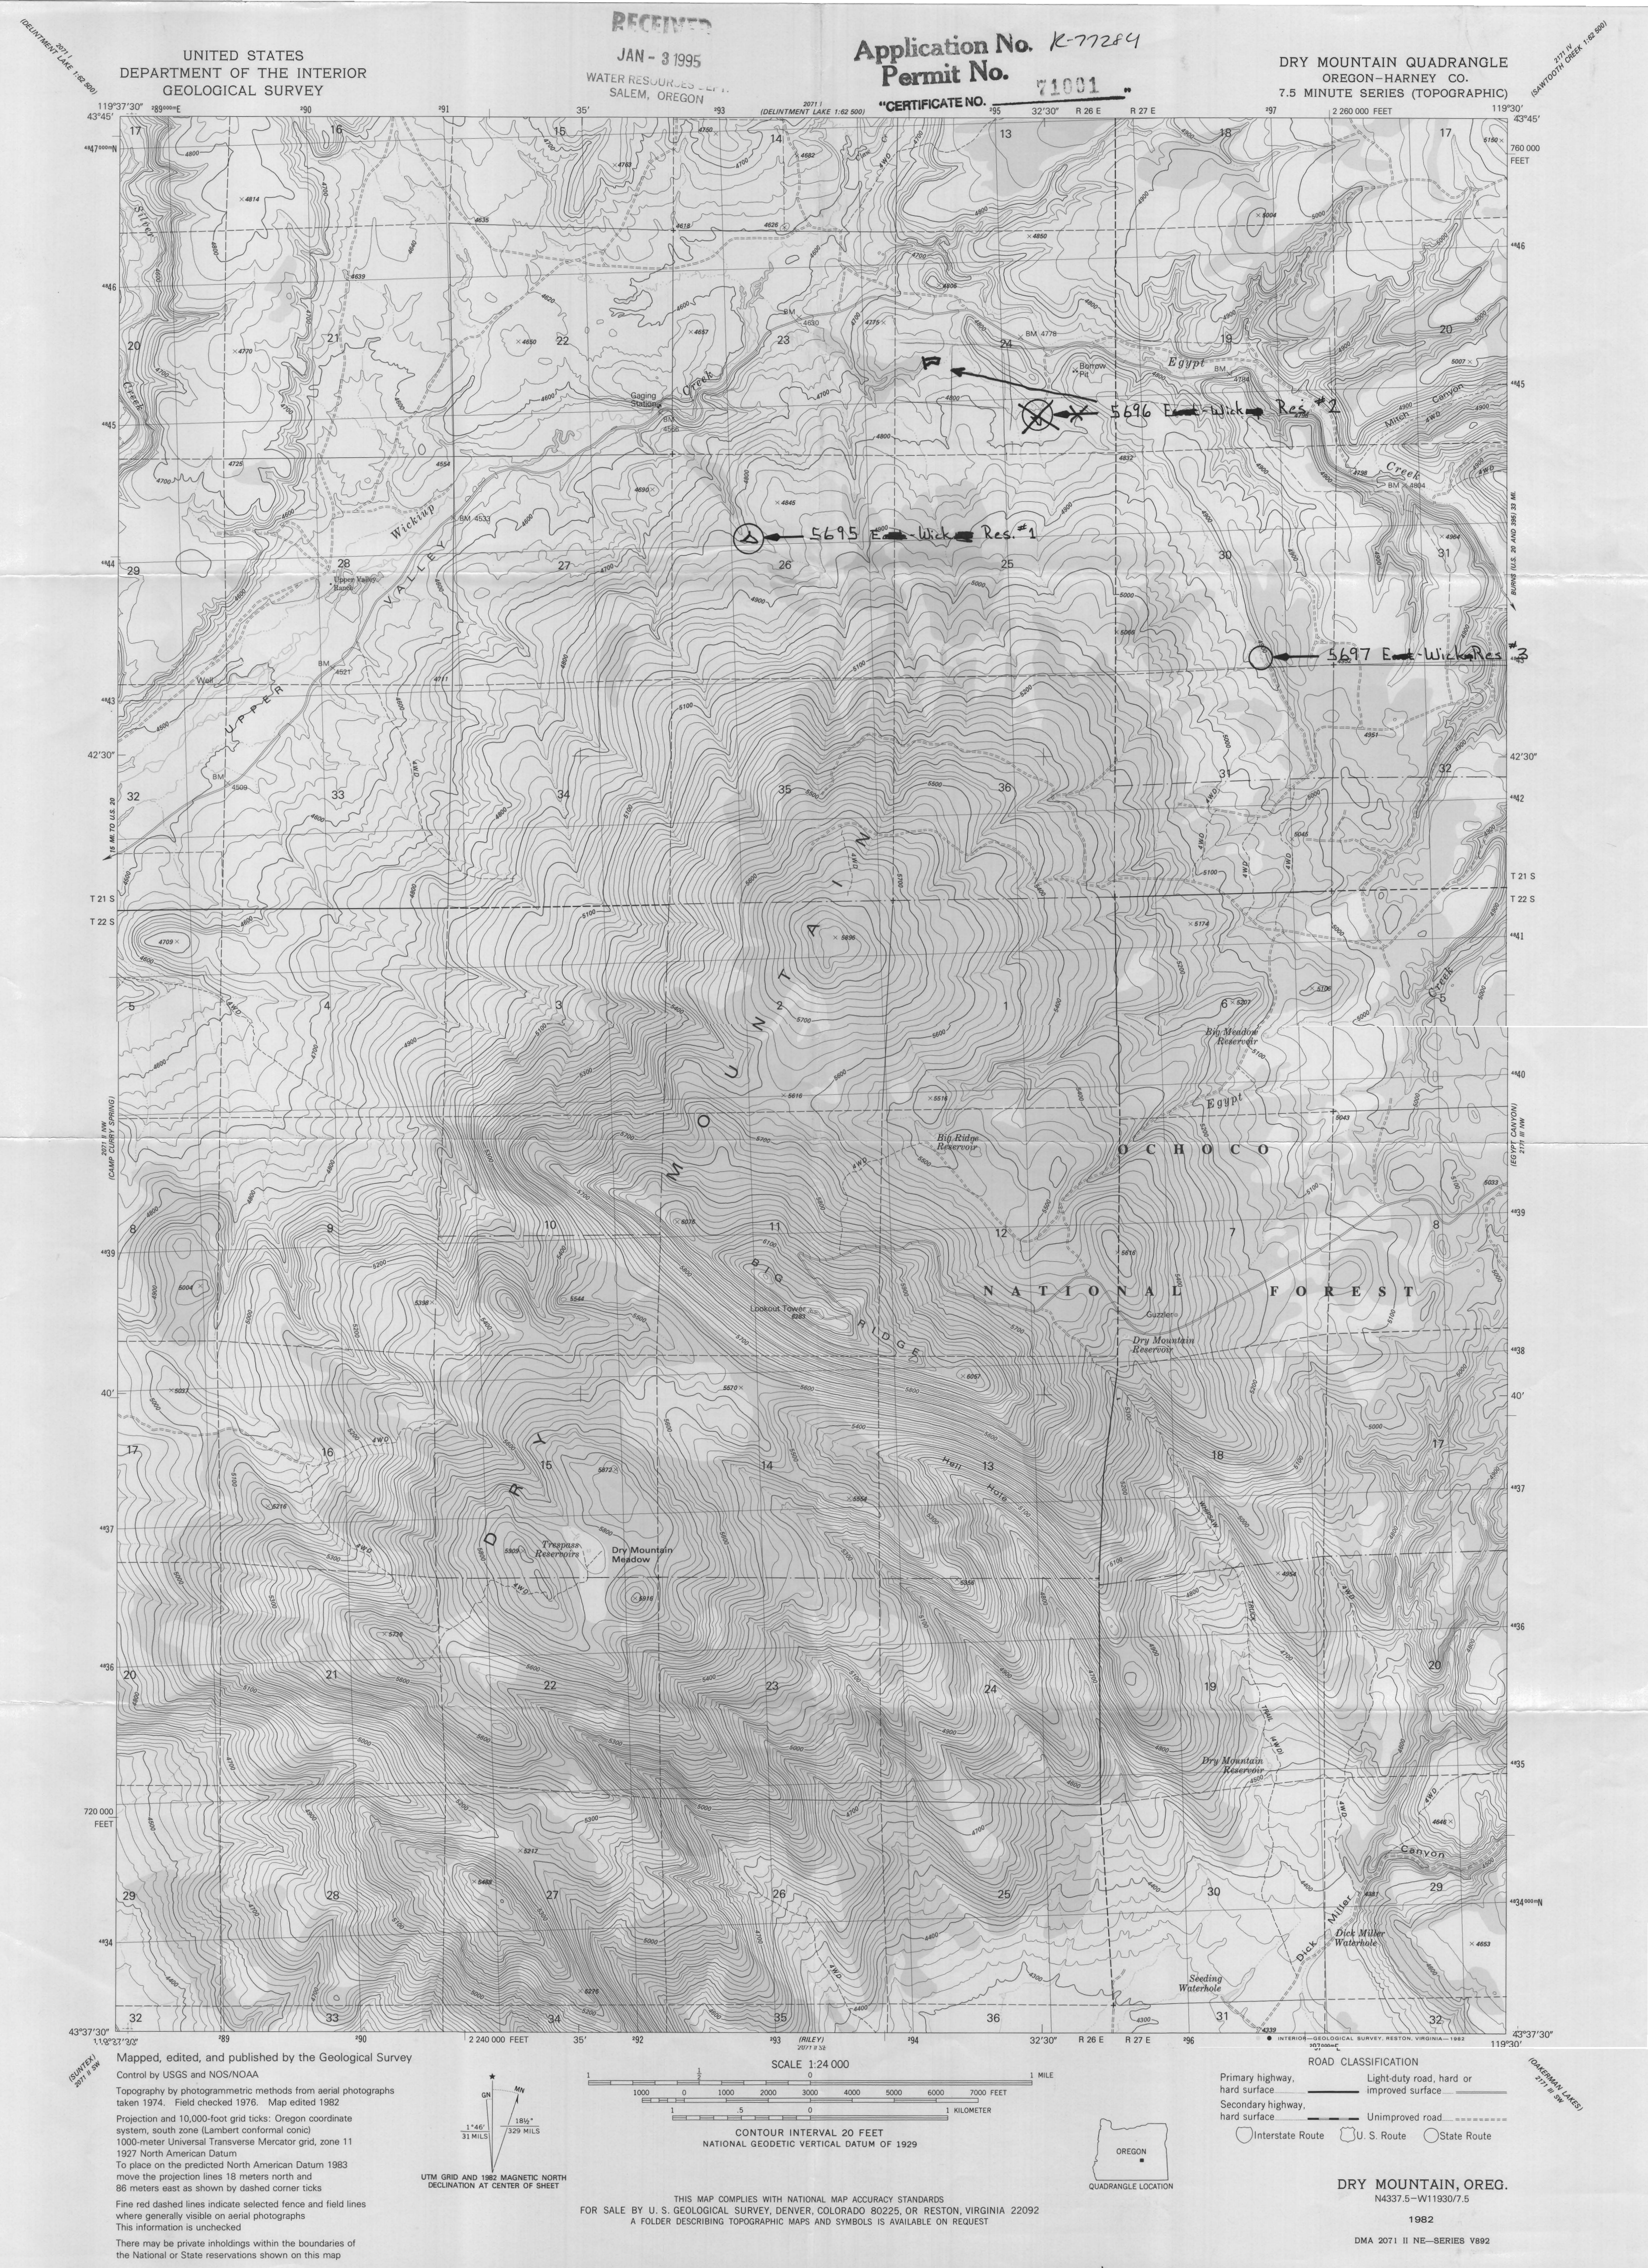

RECEIVED

JAN - 3 1995

WATER RESOURCES DIV.
SALEM, OREGON

Application No. K-77284

Permit No.

71001

CERTIFICATE NO.

DRY MOUNTAIN QUADRANGLE
OREGON-HARNEY CO.

7.5 MINUTE SERIES (TOPOGRAPHIC)

UNITED STATES
DEPARTMENT OF THE INTERIOR
GEOLOGICAL SURVEY

Mapped, edited, and published by the Geological Survey

Control by USGS and NOS/NOAA



Topography by photogrammetric methods from aerial photographs
taken 1974. Field checked 1976. Map edited 1982

Projection and 10,000-foot grid ticks: Oregon coordinate
system, south zone (Lambert conformal conic)
1000-meter Universal Transverse Mercator grid, zone 11
1927 North American Datum


To place on the predicted North American Datum 1983
move the projection lines 18 meters north and
86 meters east as shown by dashed corner ticks

Fine red dashed lines indicate selected fence and field lines
where generally visible on aerial photographs
This information is unchecked

There may be private inholdings within the boundaries of
the National or State reservations shown on this map

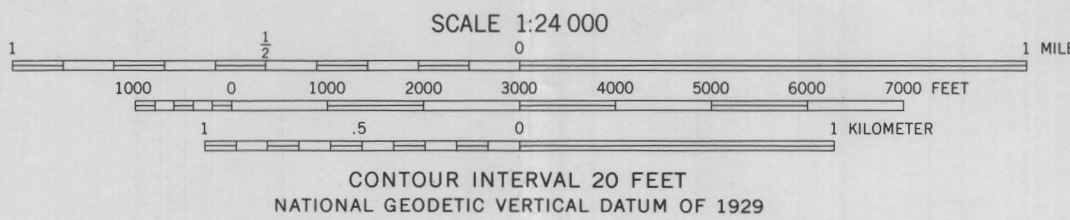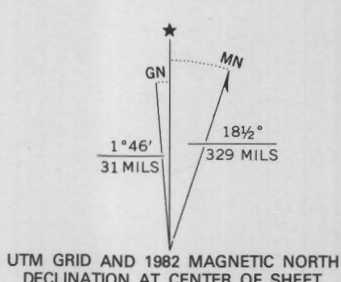

CONTOUR INTERVAL 20 FEET
NATIONAL GEODETIC VERTICAL DATUM OF 1929

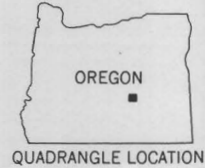

ROAD CLASSIFICATION	
Primary highway, hard surface	Light-duty road, hard or improved surface
Secondary highway, hard surface	Unimproved road
Interstate Route	U. S. Route
	State Route

DRY MOUNTAIN, OREG.
N4337.5-W11930/7.5

1982

DMA 2071 II NE-SERIES V892

THIS MAP COMPLIES WITH NATIONAL MAP ACCURACY STANDARDS
FOR SALE BY U. S. GEOLOGICAL SURVEY, DENVER, COLORADO 80225, OR RESTON, VIRGINIA 22092
A FOLDER DESCRIBING TOPOGRAPHIC MAPS AND SYMBOLS IS AVAILABLE ON REQUEST