

Application No. R-77331  
 Permit No.

SUBJECT PROPERTY MAP


JANUARY 1993

"CERTIFICATE NO. 71008"

RECEIVED

JAN - 4 1995

WATER RESOURCES DEP  
 SALEM, OREGON

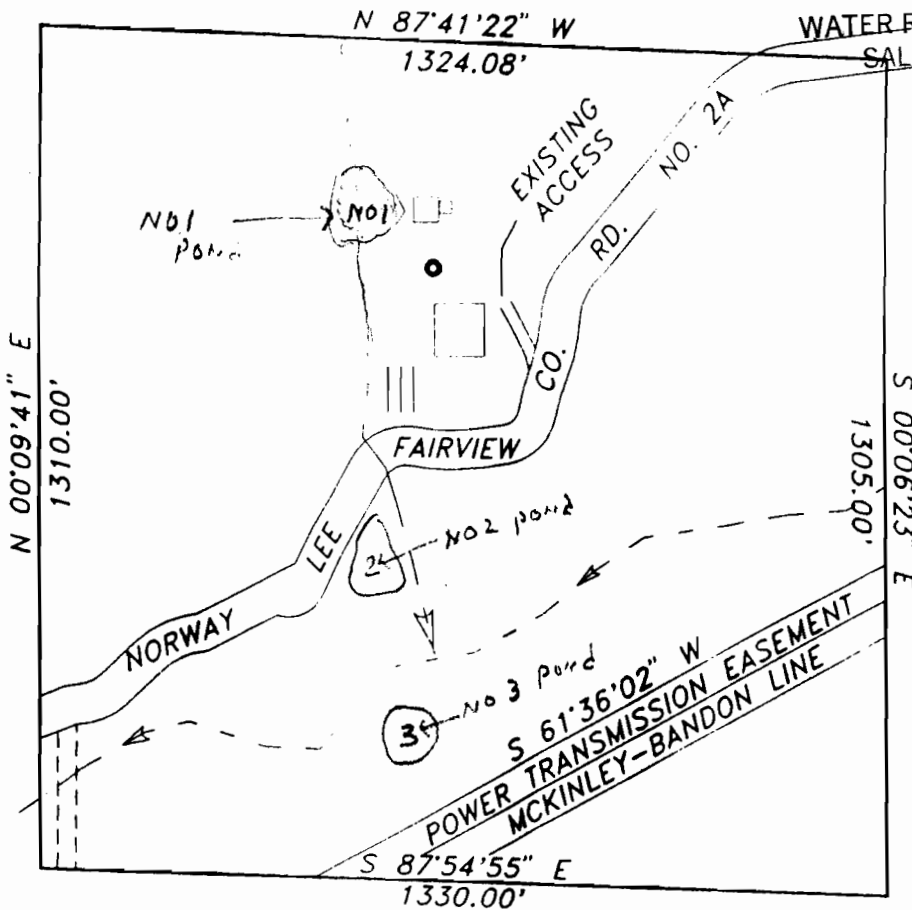

LEGEND

- STREAM
- EXISTING BARN
- EXISTING WELL
- EXISTING DRAINFIELD
- FORMER AND PROPOSED DWELLING

*Stuntzner Engineering & Forestry*

ENGINEERING • LAND SURVEYING • FORESTRY  
 PLANNING • WATER RIGHTS

705 South 4th St.  
 Post Office Box 116  
 Coos Bay, Oregon 97420

Phone: (503) 267-2872  
 Fax: (503) 267-0588

ATTACHMENT "A"  
 9 of 9