


Application No. 72-77428
Permit No.

CERTIFICATE NO.

71019

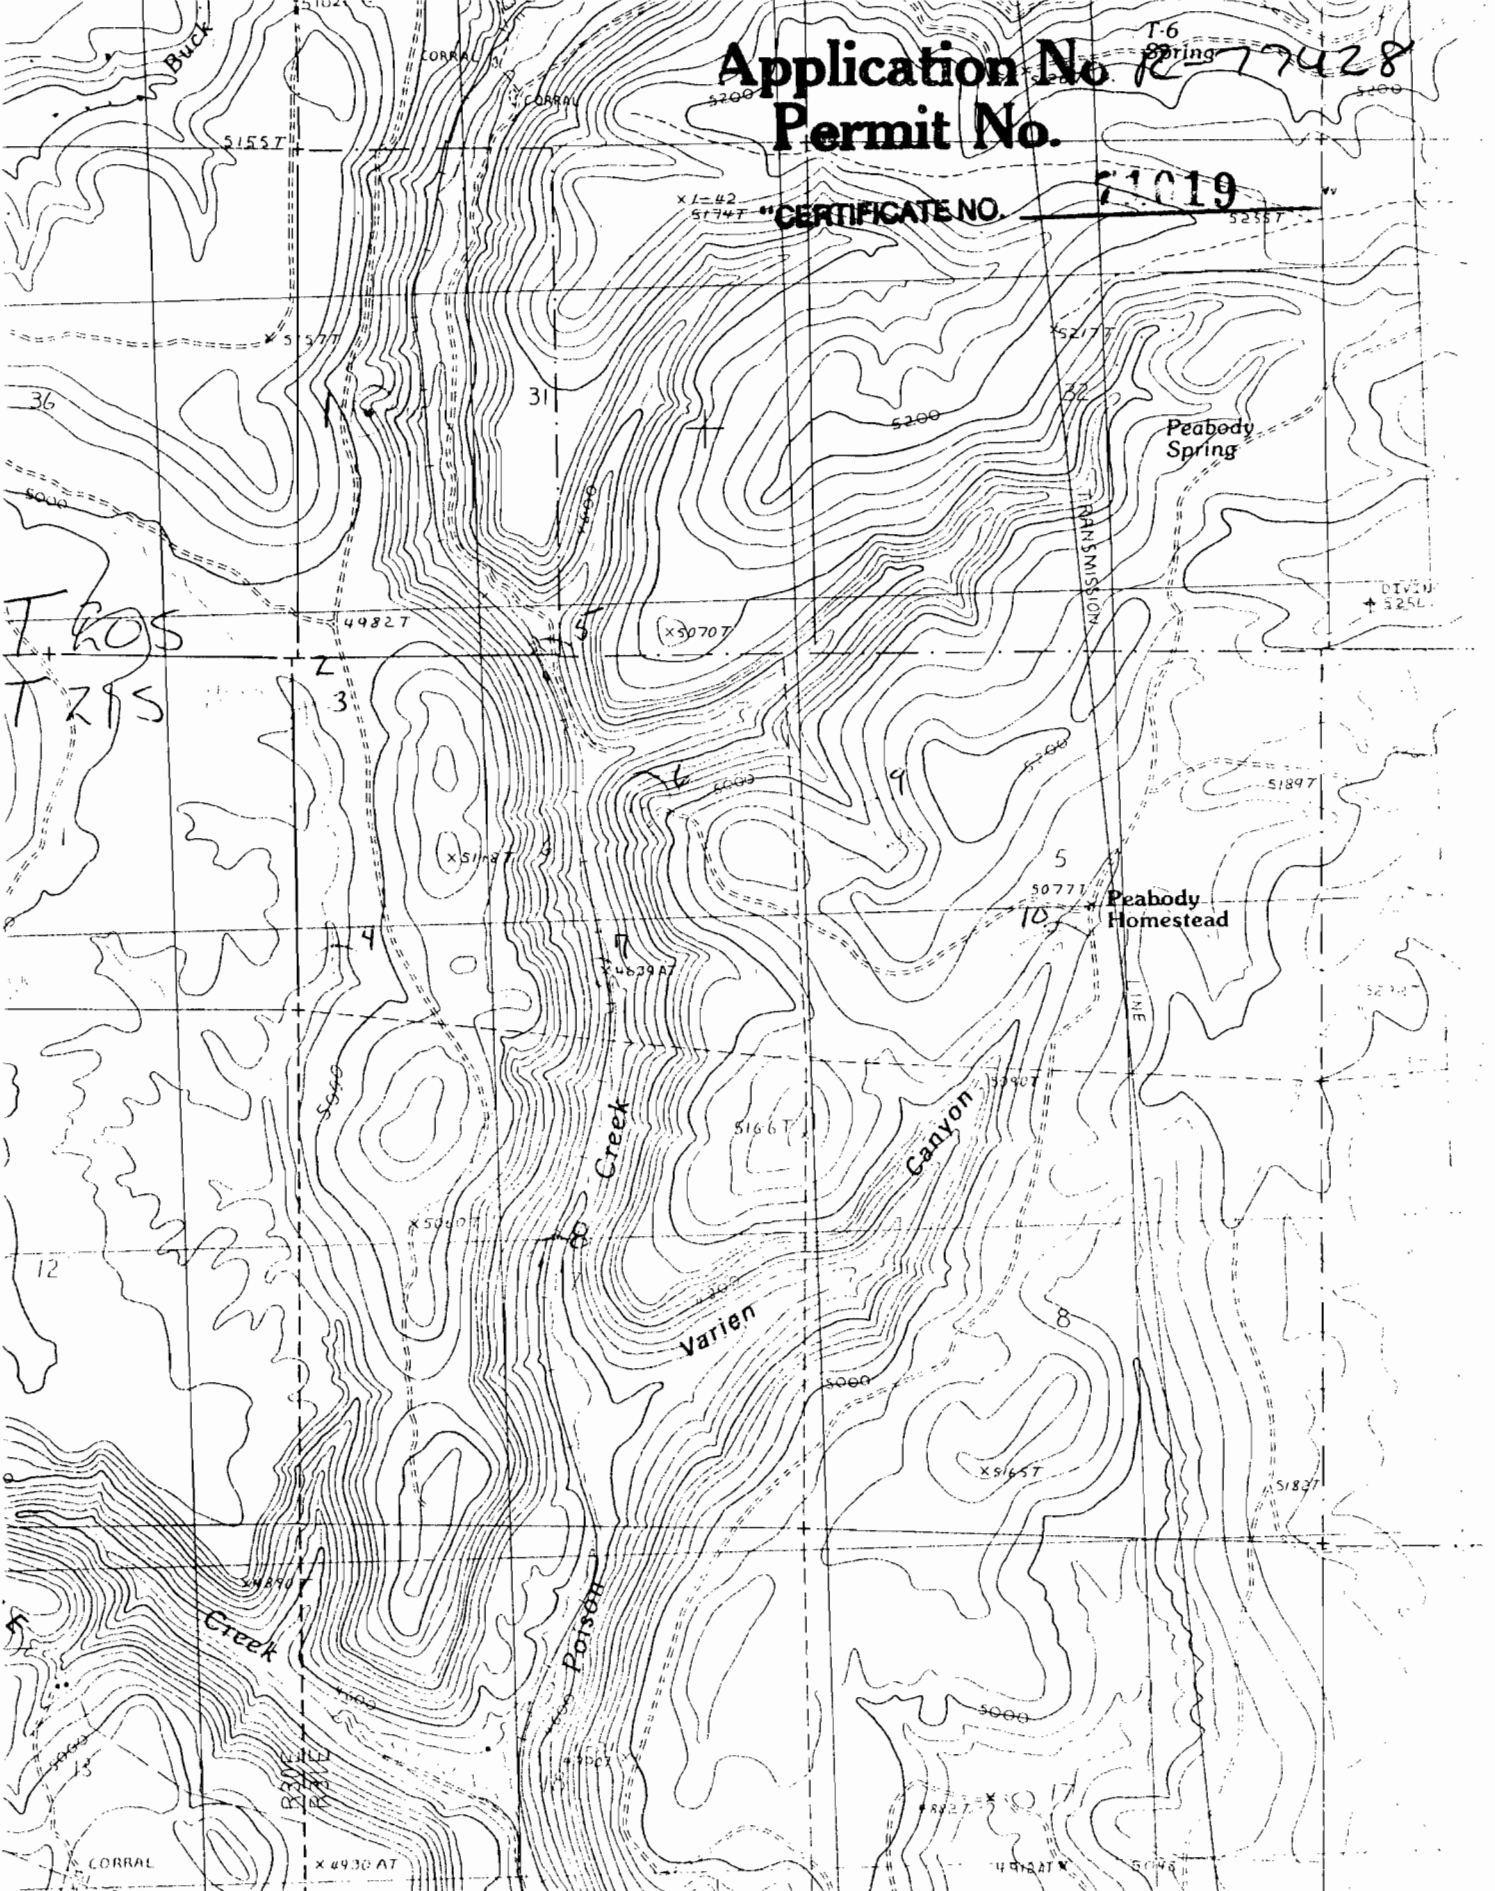

SCALE 1:24 000

0 1 2
KILOMETERS
0 1000 2000
METERS

INTERIOR- GEOLOGICAL SURVEY, RESTON, VIRGINIA-1990

OREGON

Mosquito Flat
1990 Ed