

MAP SHOWING IRRIGATION SYSTEM of FRED RUFFNER GRIZZLY OREGON

C-7102

I Raymond G. Heider of Madras Oregon do hereby certify that this map was made from notes taken during an actual survey made by me on March 14 1925 and that it correctly represents the works described in the accompanying application together with the location of streams and other ditches in the immediate vicinity.


Scale 1" = 200'

T12S, R15E of W.M.

Raymond G. Heider
county surveyor

16

1/4 sec cor.

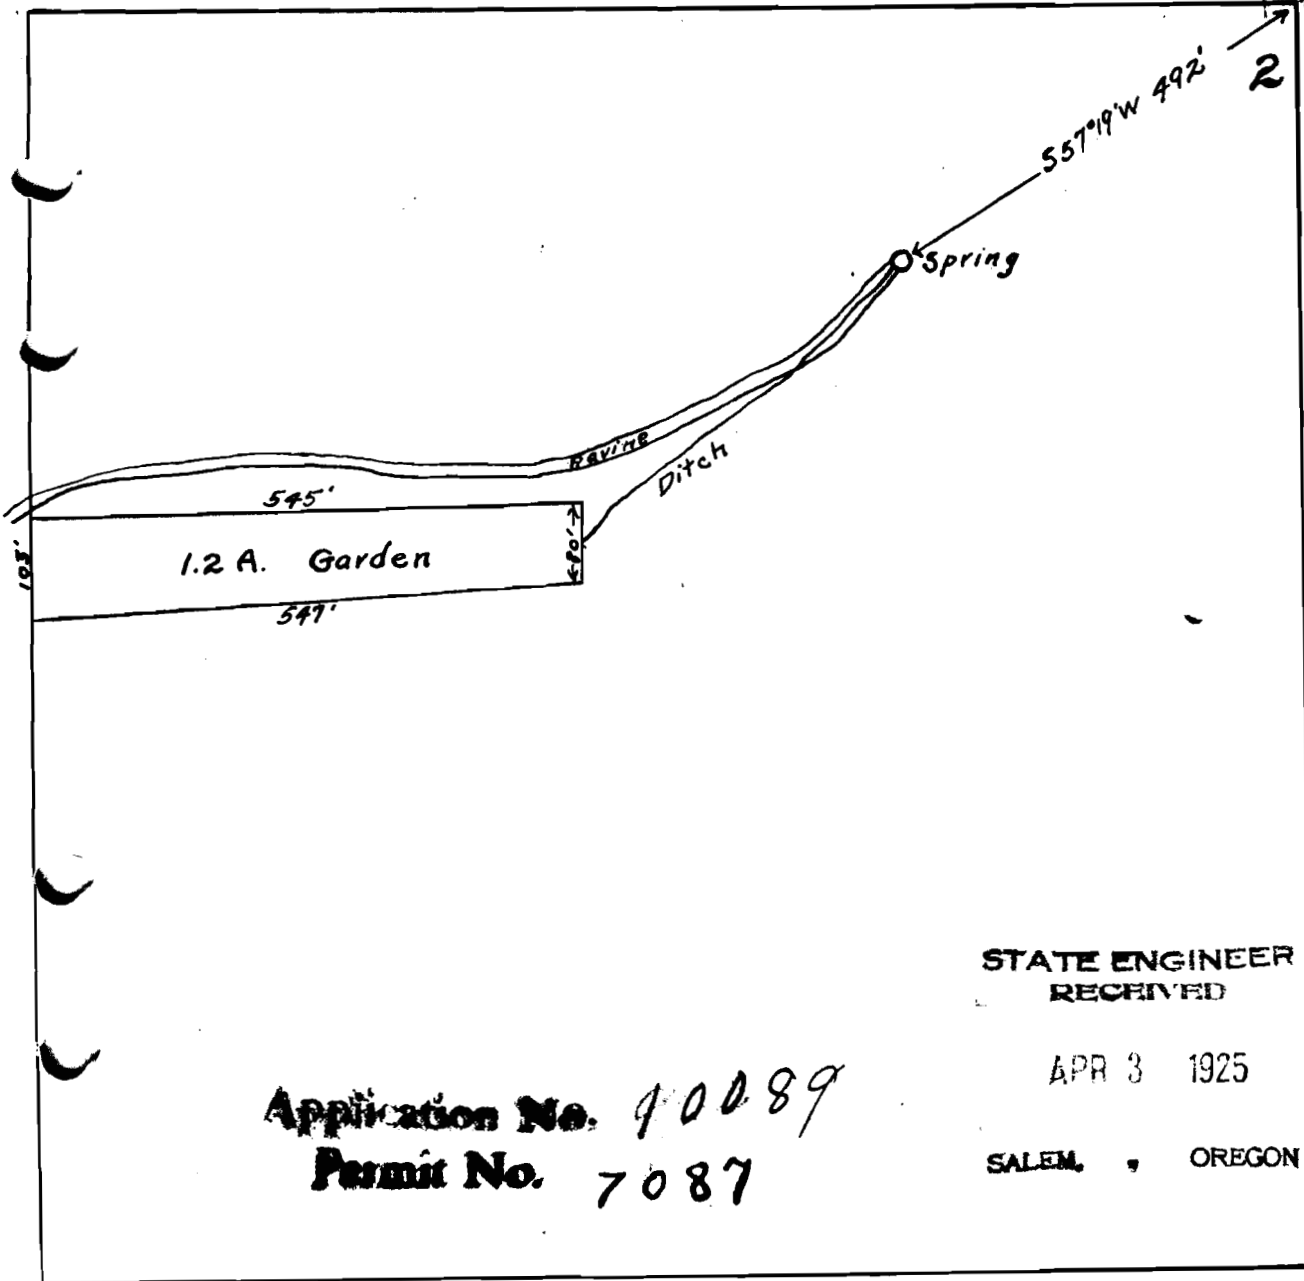

1001