


Application No. R-77439
Permit No.

CERTIFICATE NO. 36 71030

RECEIVED
DEC 3 1994
WATER RESOURCES
SALEM, OREGON

BURNS
1960
W.H. Beal

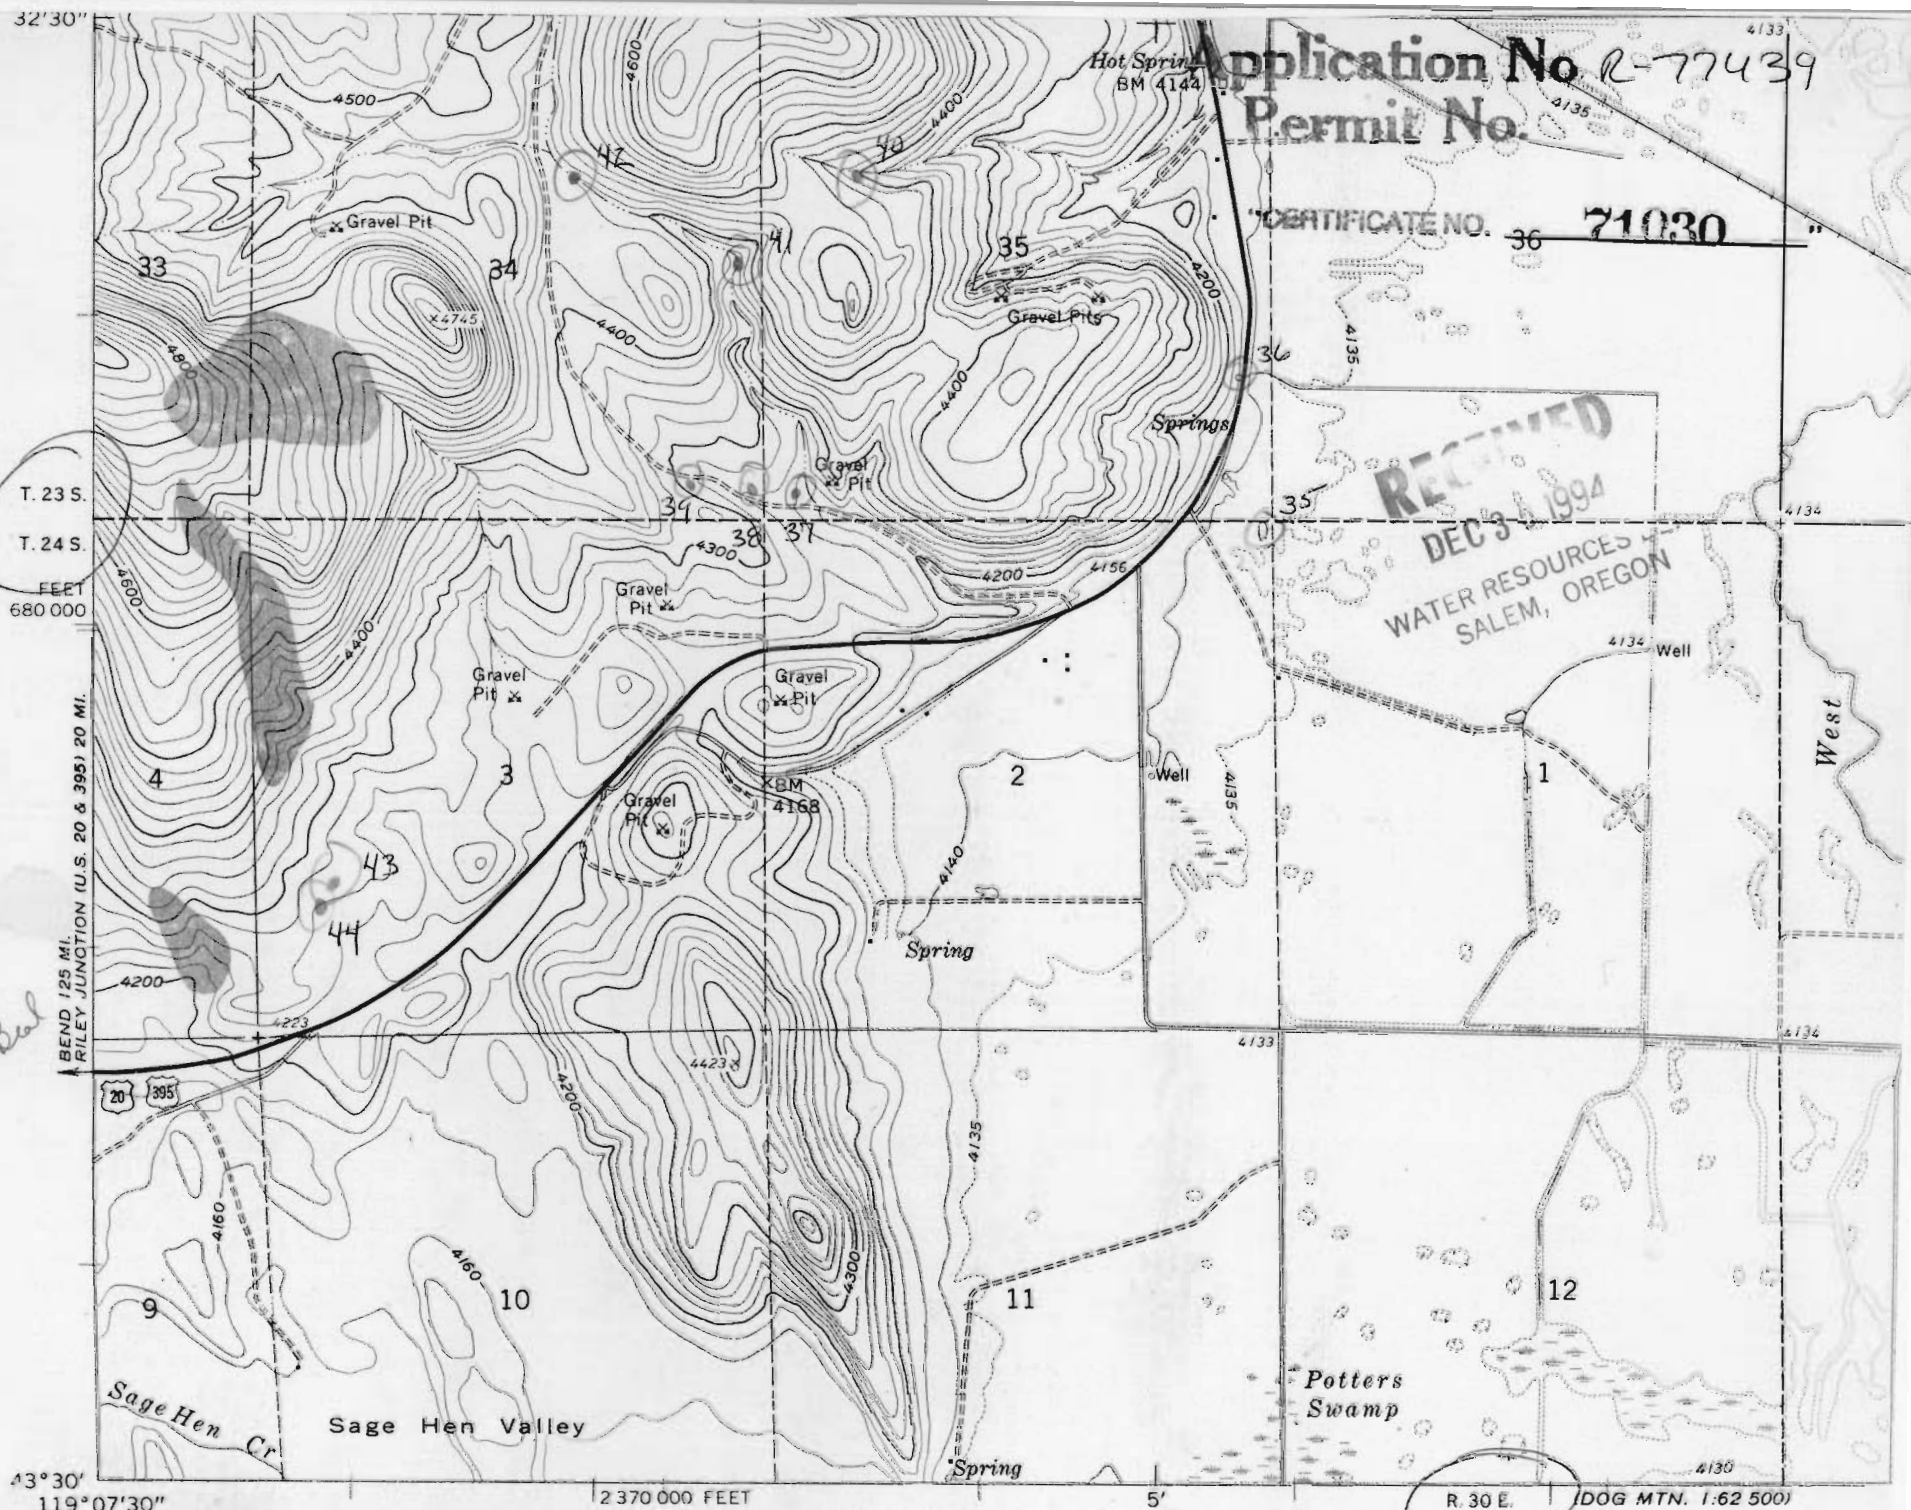

Mapped, edited, and published by the Geological Survey
Control by USGS and USC&GS
Topography by photogrammetric methods from aerial



R. 30 E. DOG MTN. 1:62 500